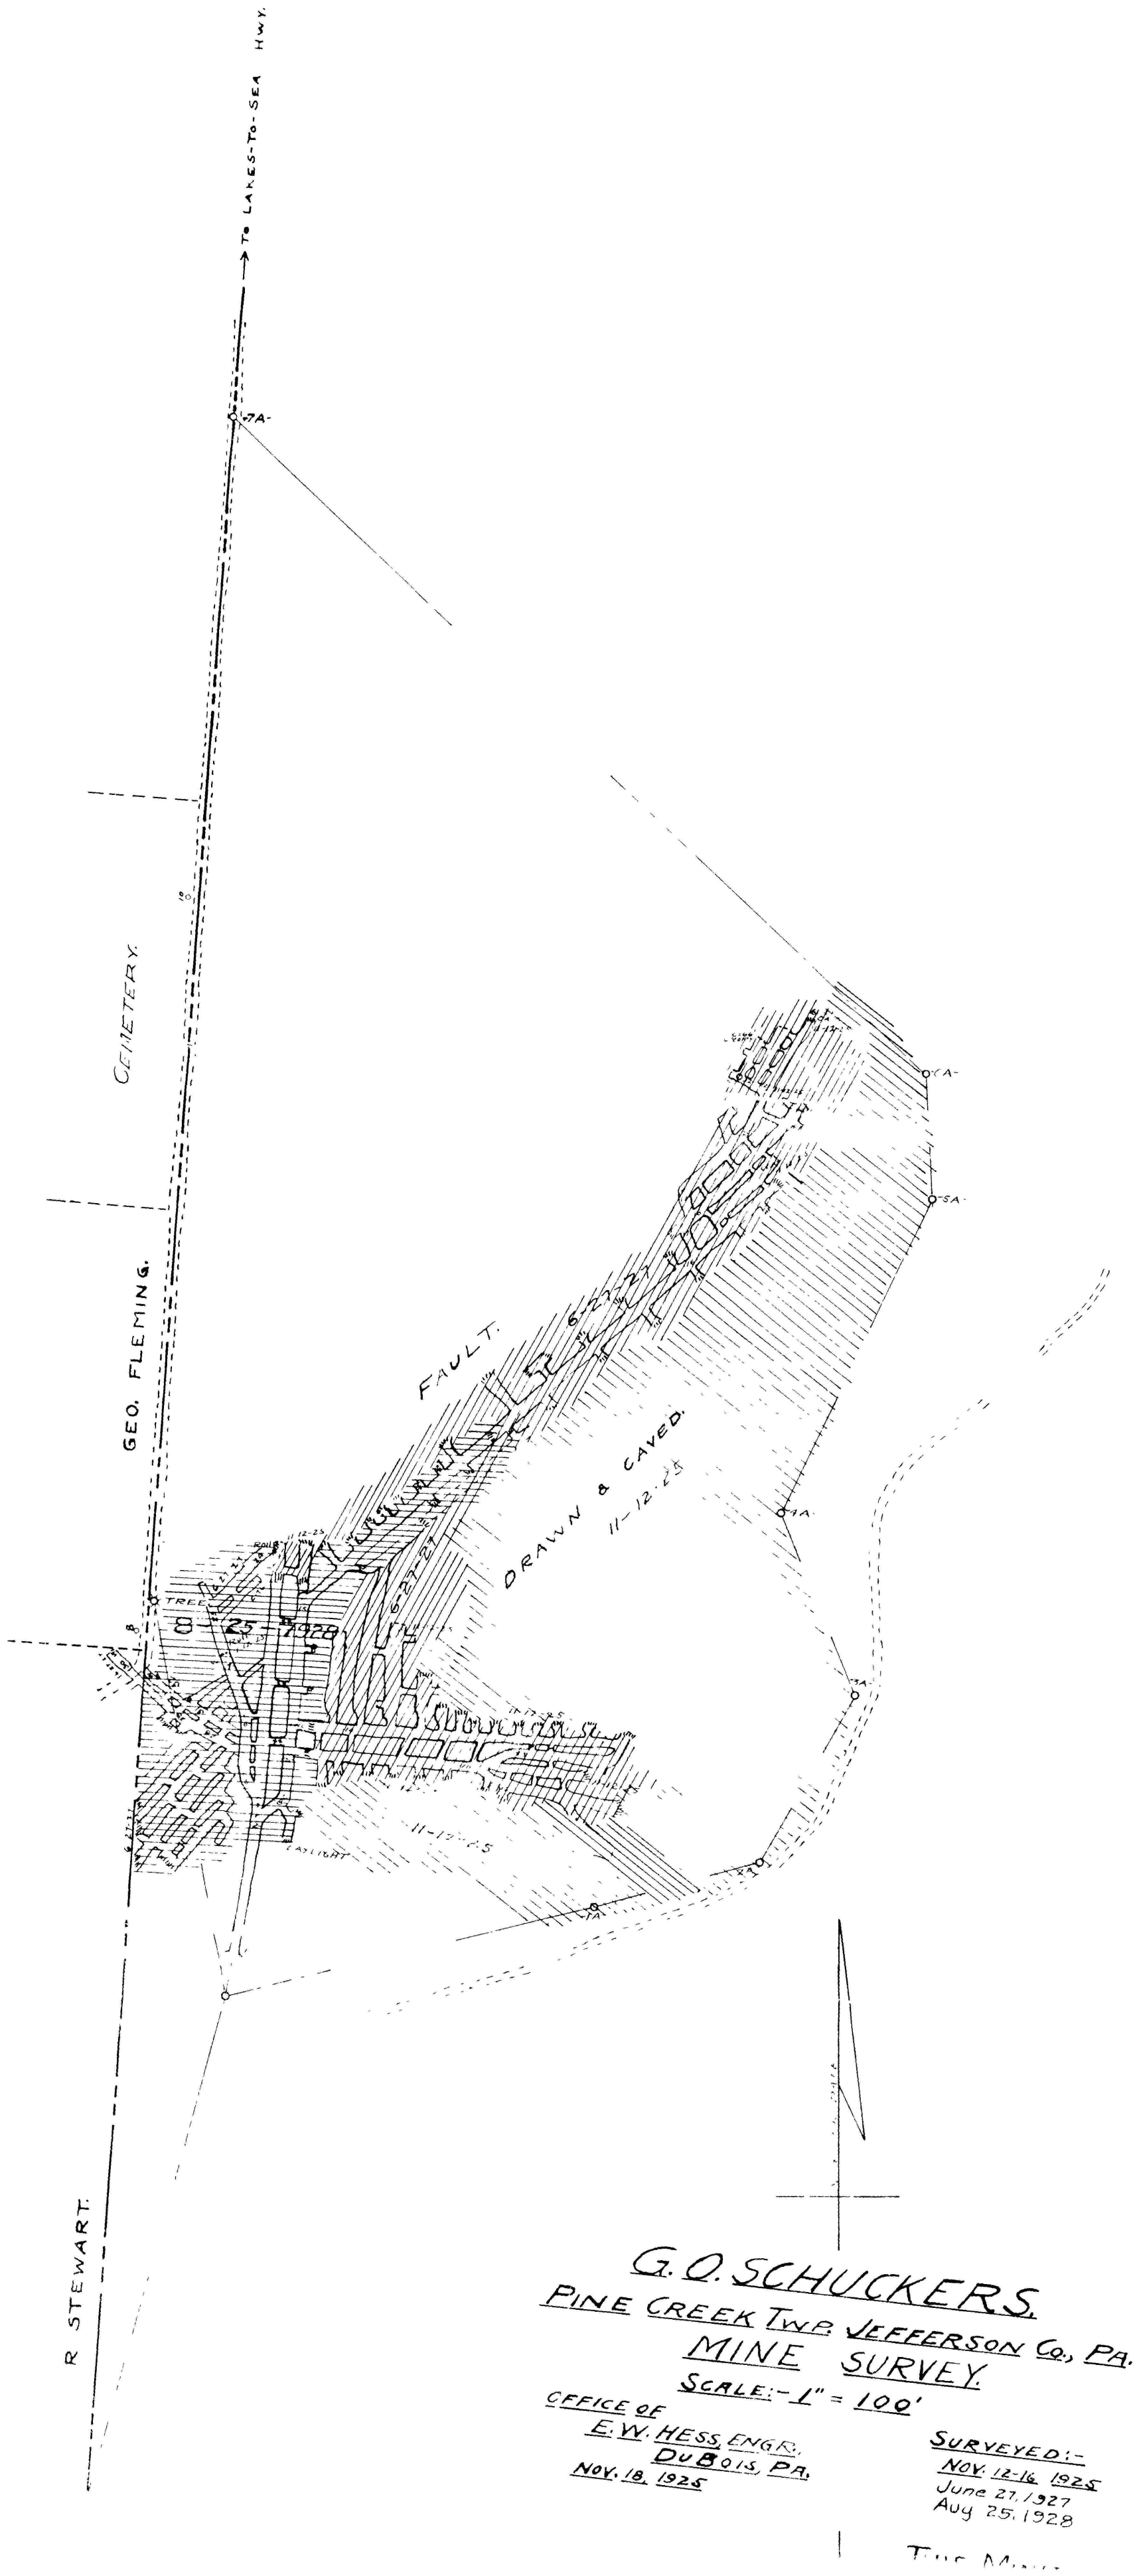
TO LAKES-TO-SEA HWY.
CEMETERY.
GEO. FLEMING.
R STEWART.
FAULT.
DRAWN & CAVED.
11-12-25
6-27-27
8-25-1928
TREE
CAYLIGHT
G. O. SCHUCKERS.
PINE CREEK TWP. JEFFERSON CO., PA.
MINE SURVEY.
SCALE:- 1" = 100'
OFFICE OF
E. W. HESS, ENGR.,
DUBOIS, PA.
NOV. 18, 1925
SURVEYED:-
NOV. 12-16, 1925
June 27, 1927
Aug 25, 1928