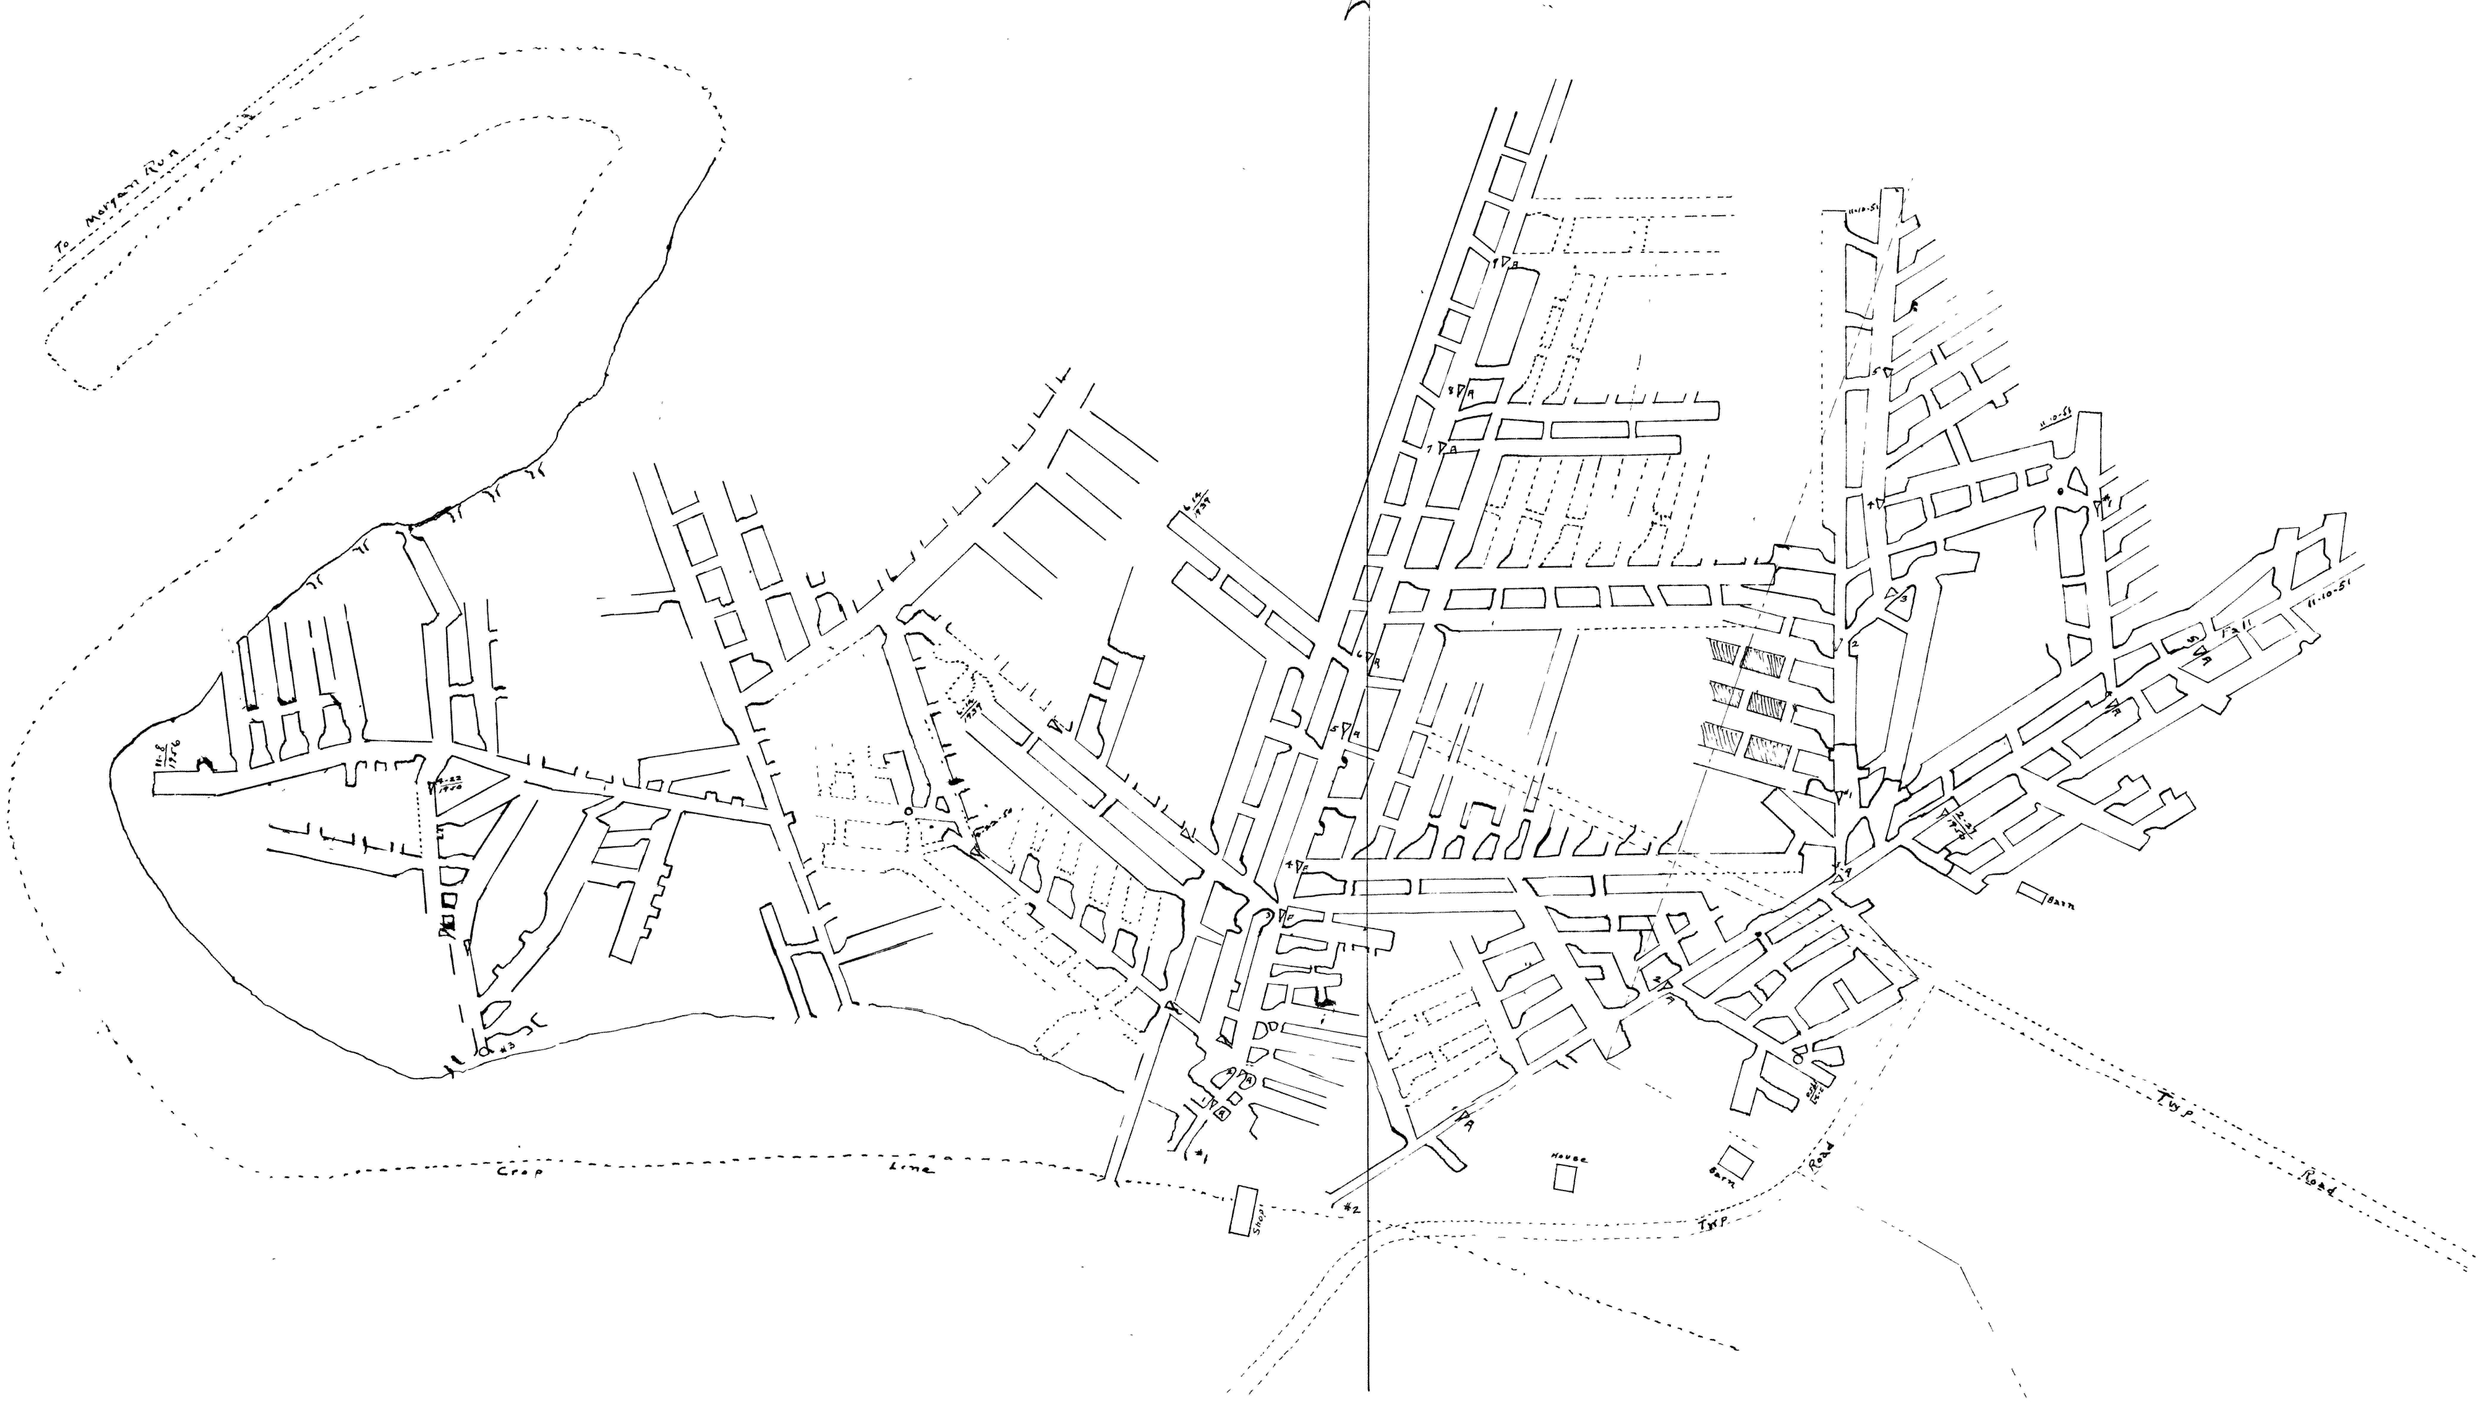

MAP
of
SECKINGER COAL MINING CO.
Seckinger No 1 Mine
MADERA, Bigler Twp, Clearfield Co, Pa.
Scale 1" = 100'