


ALLEGHENY RIVER MINING CO SEMINOLE MINES ARMSTRONG CO ~

Upper Freeport Seam

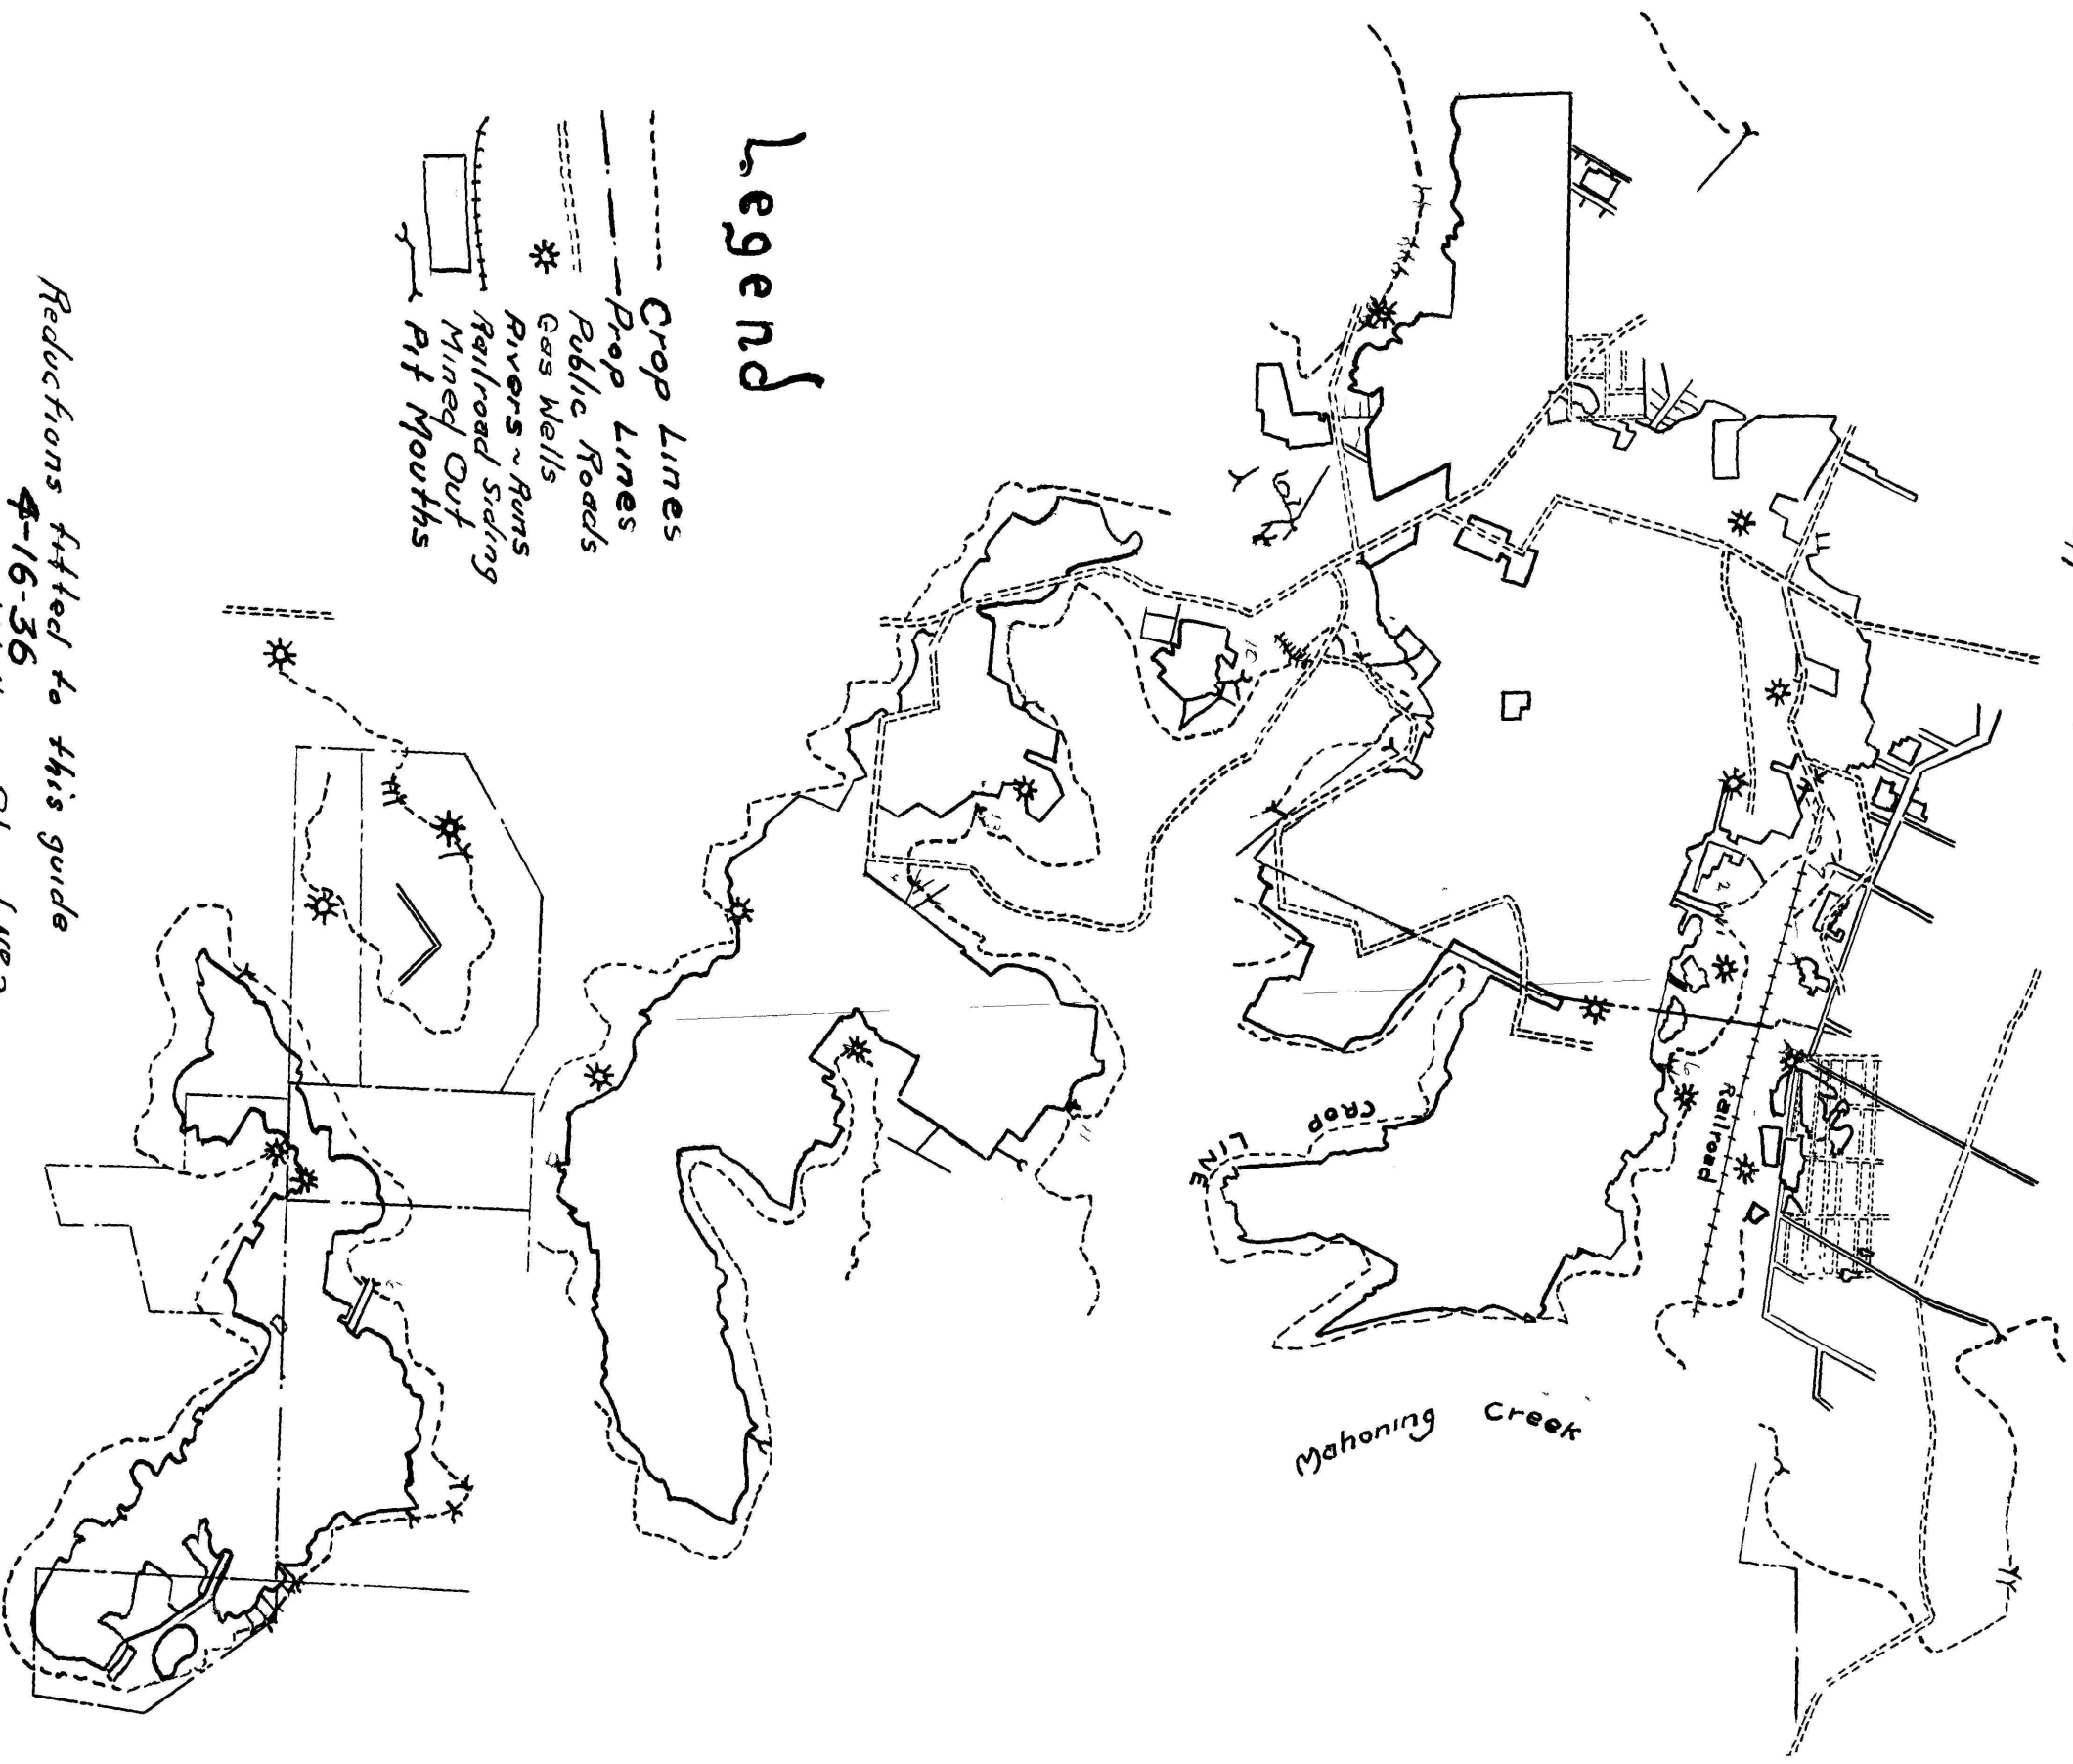

Legend

- Crop Lines
- Prop Lines
- Public Roads
- * Gas Wells
- ~ Rivers ~ Runs
- Railroad Siding
- ▭ Mined Out
- ▭ Pit Mouths

Reductions fitted to this guide

4-16-36

Fitted on Rural Valley - Sheet No 2

4-17-36

(ESM)

I