


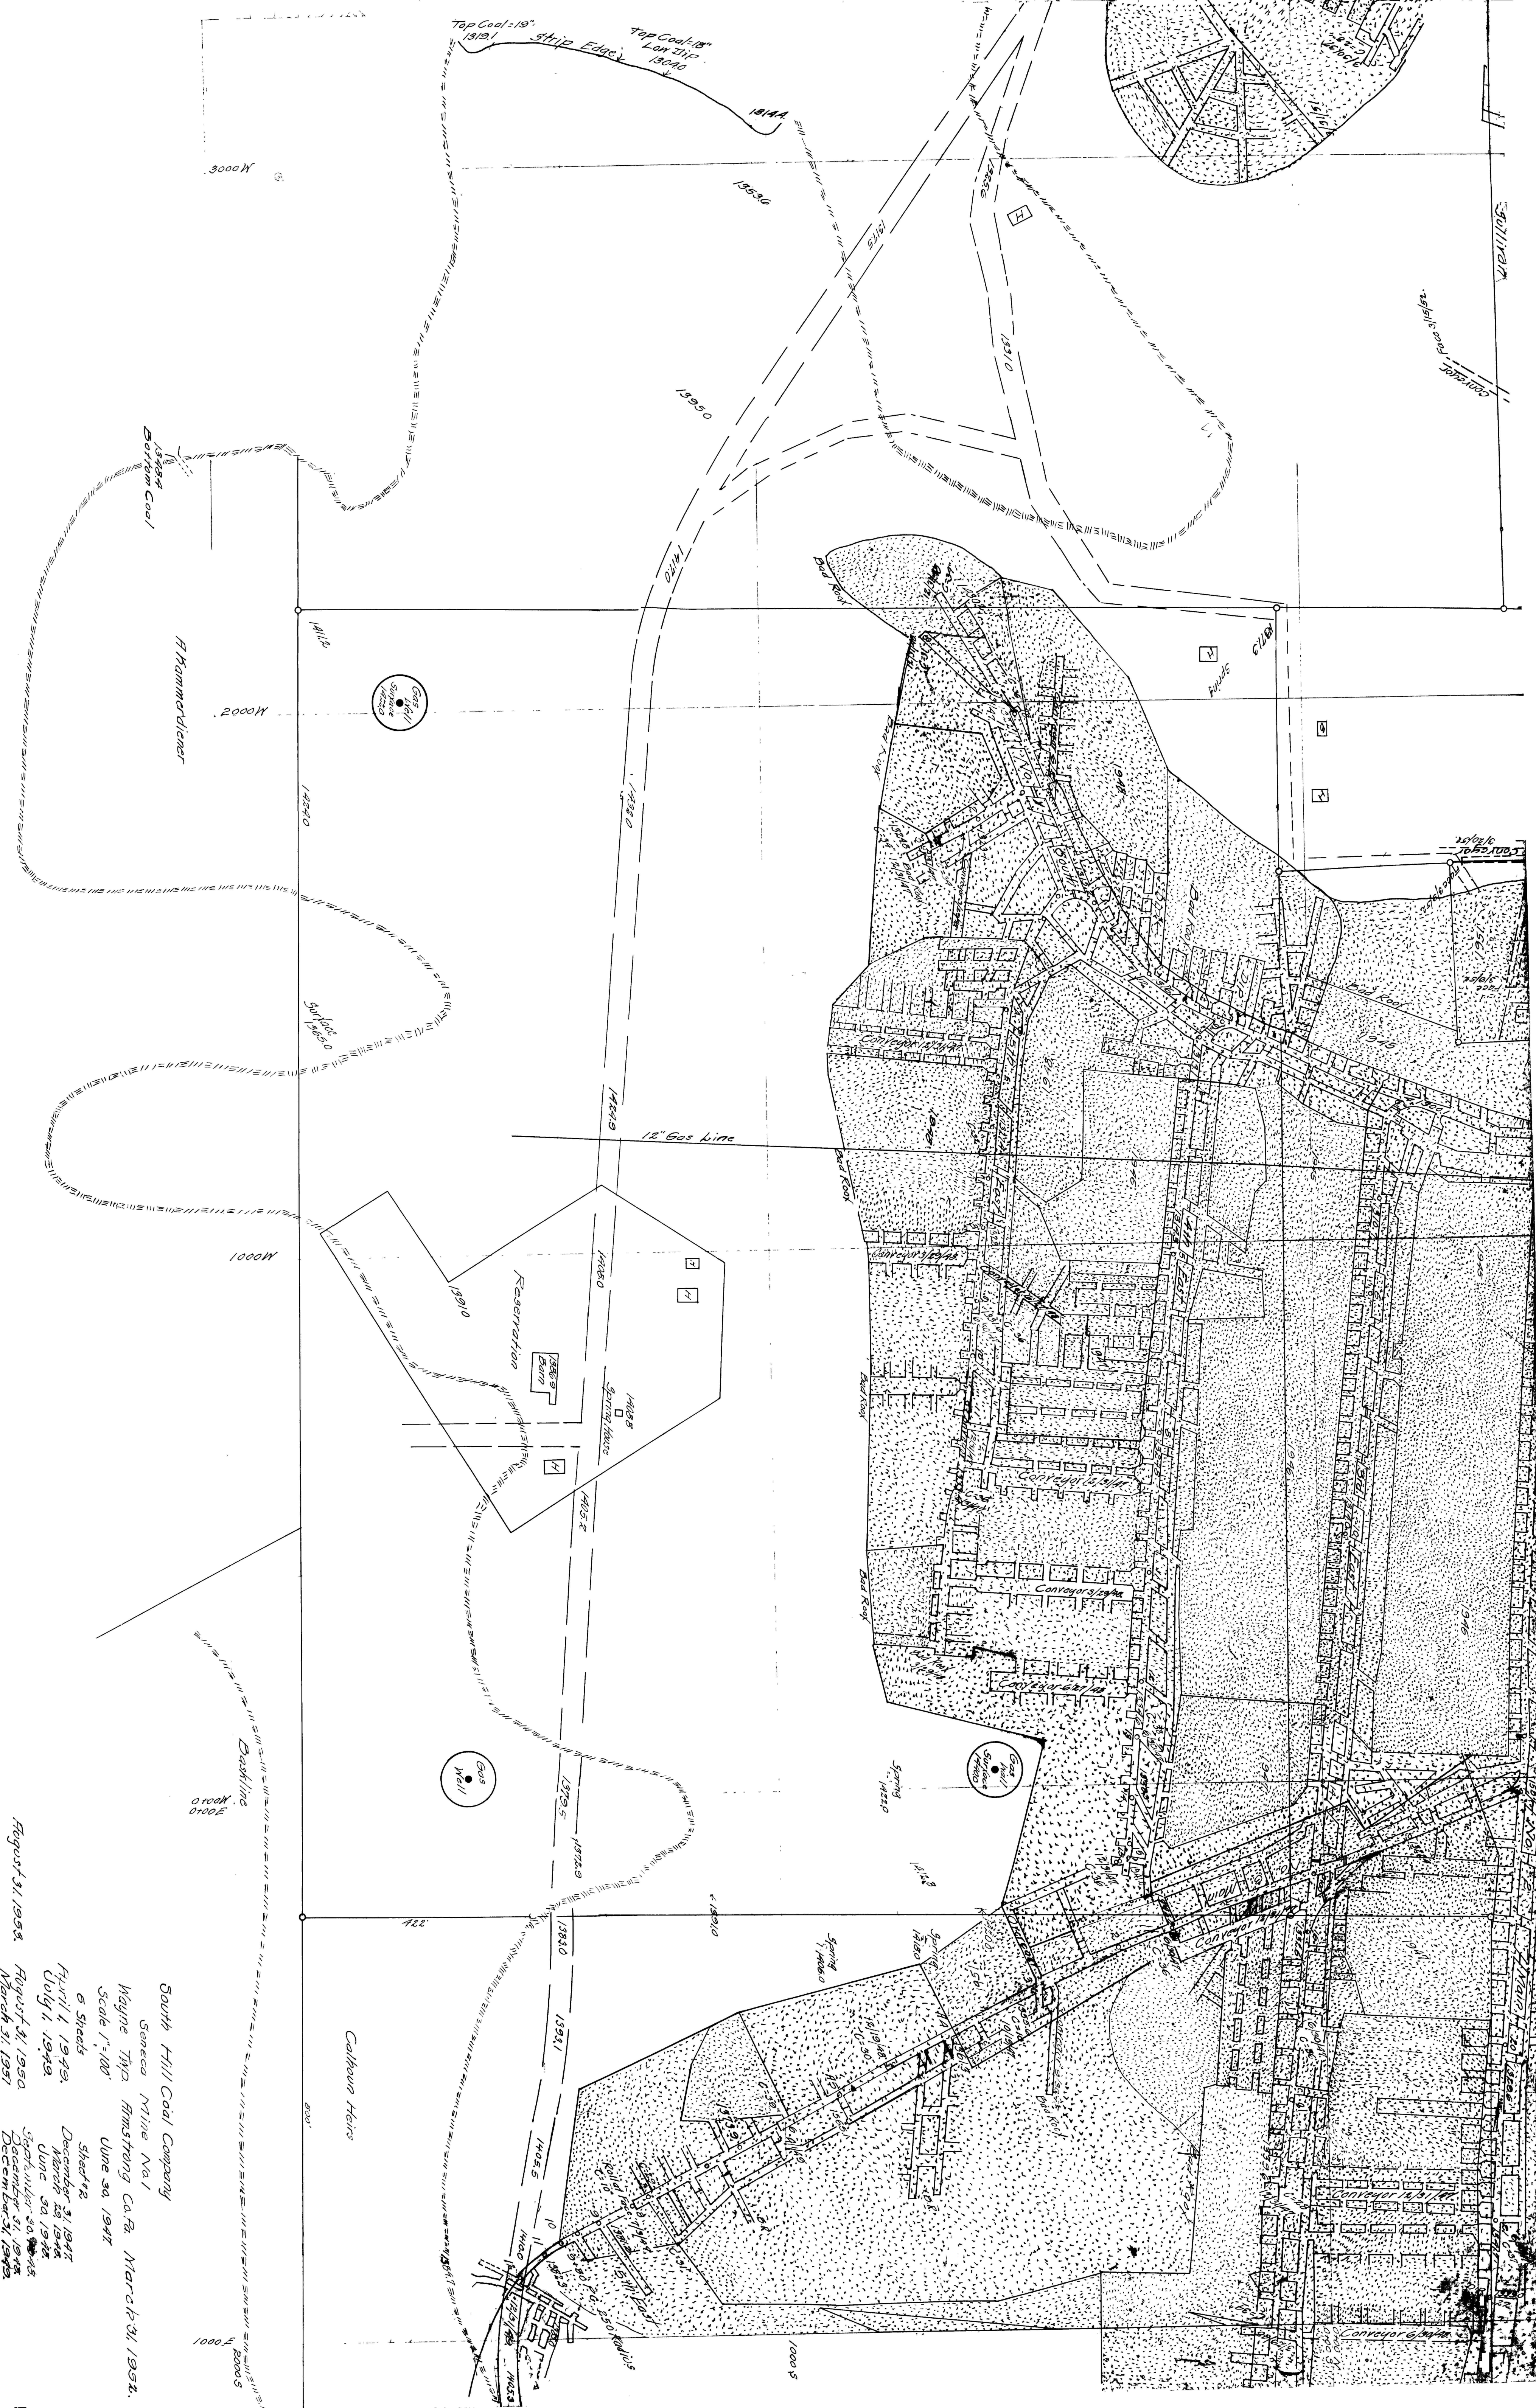

South Hill Coal Company
Geneca Mine No. 1
Wayne Twp. Armstrong Co. Pa. March 31, 1958.

August 31, 1958.

6 Sheets
April 1, 1949.
July 1, 1949.
August 31, 1950.
March 31, 1951.

Sheet #2
December 31, 1947.
March 31, 1948.
June 30, 1948.
September 30, 1948.
December 31, 1948.
March 31, 1949.