


T.B. MCGARA - SURFACE
R.B.C. & CO - COAL

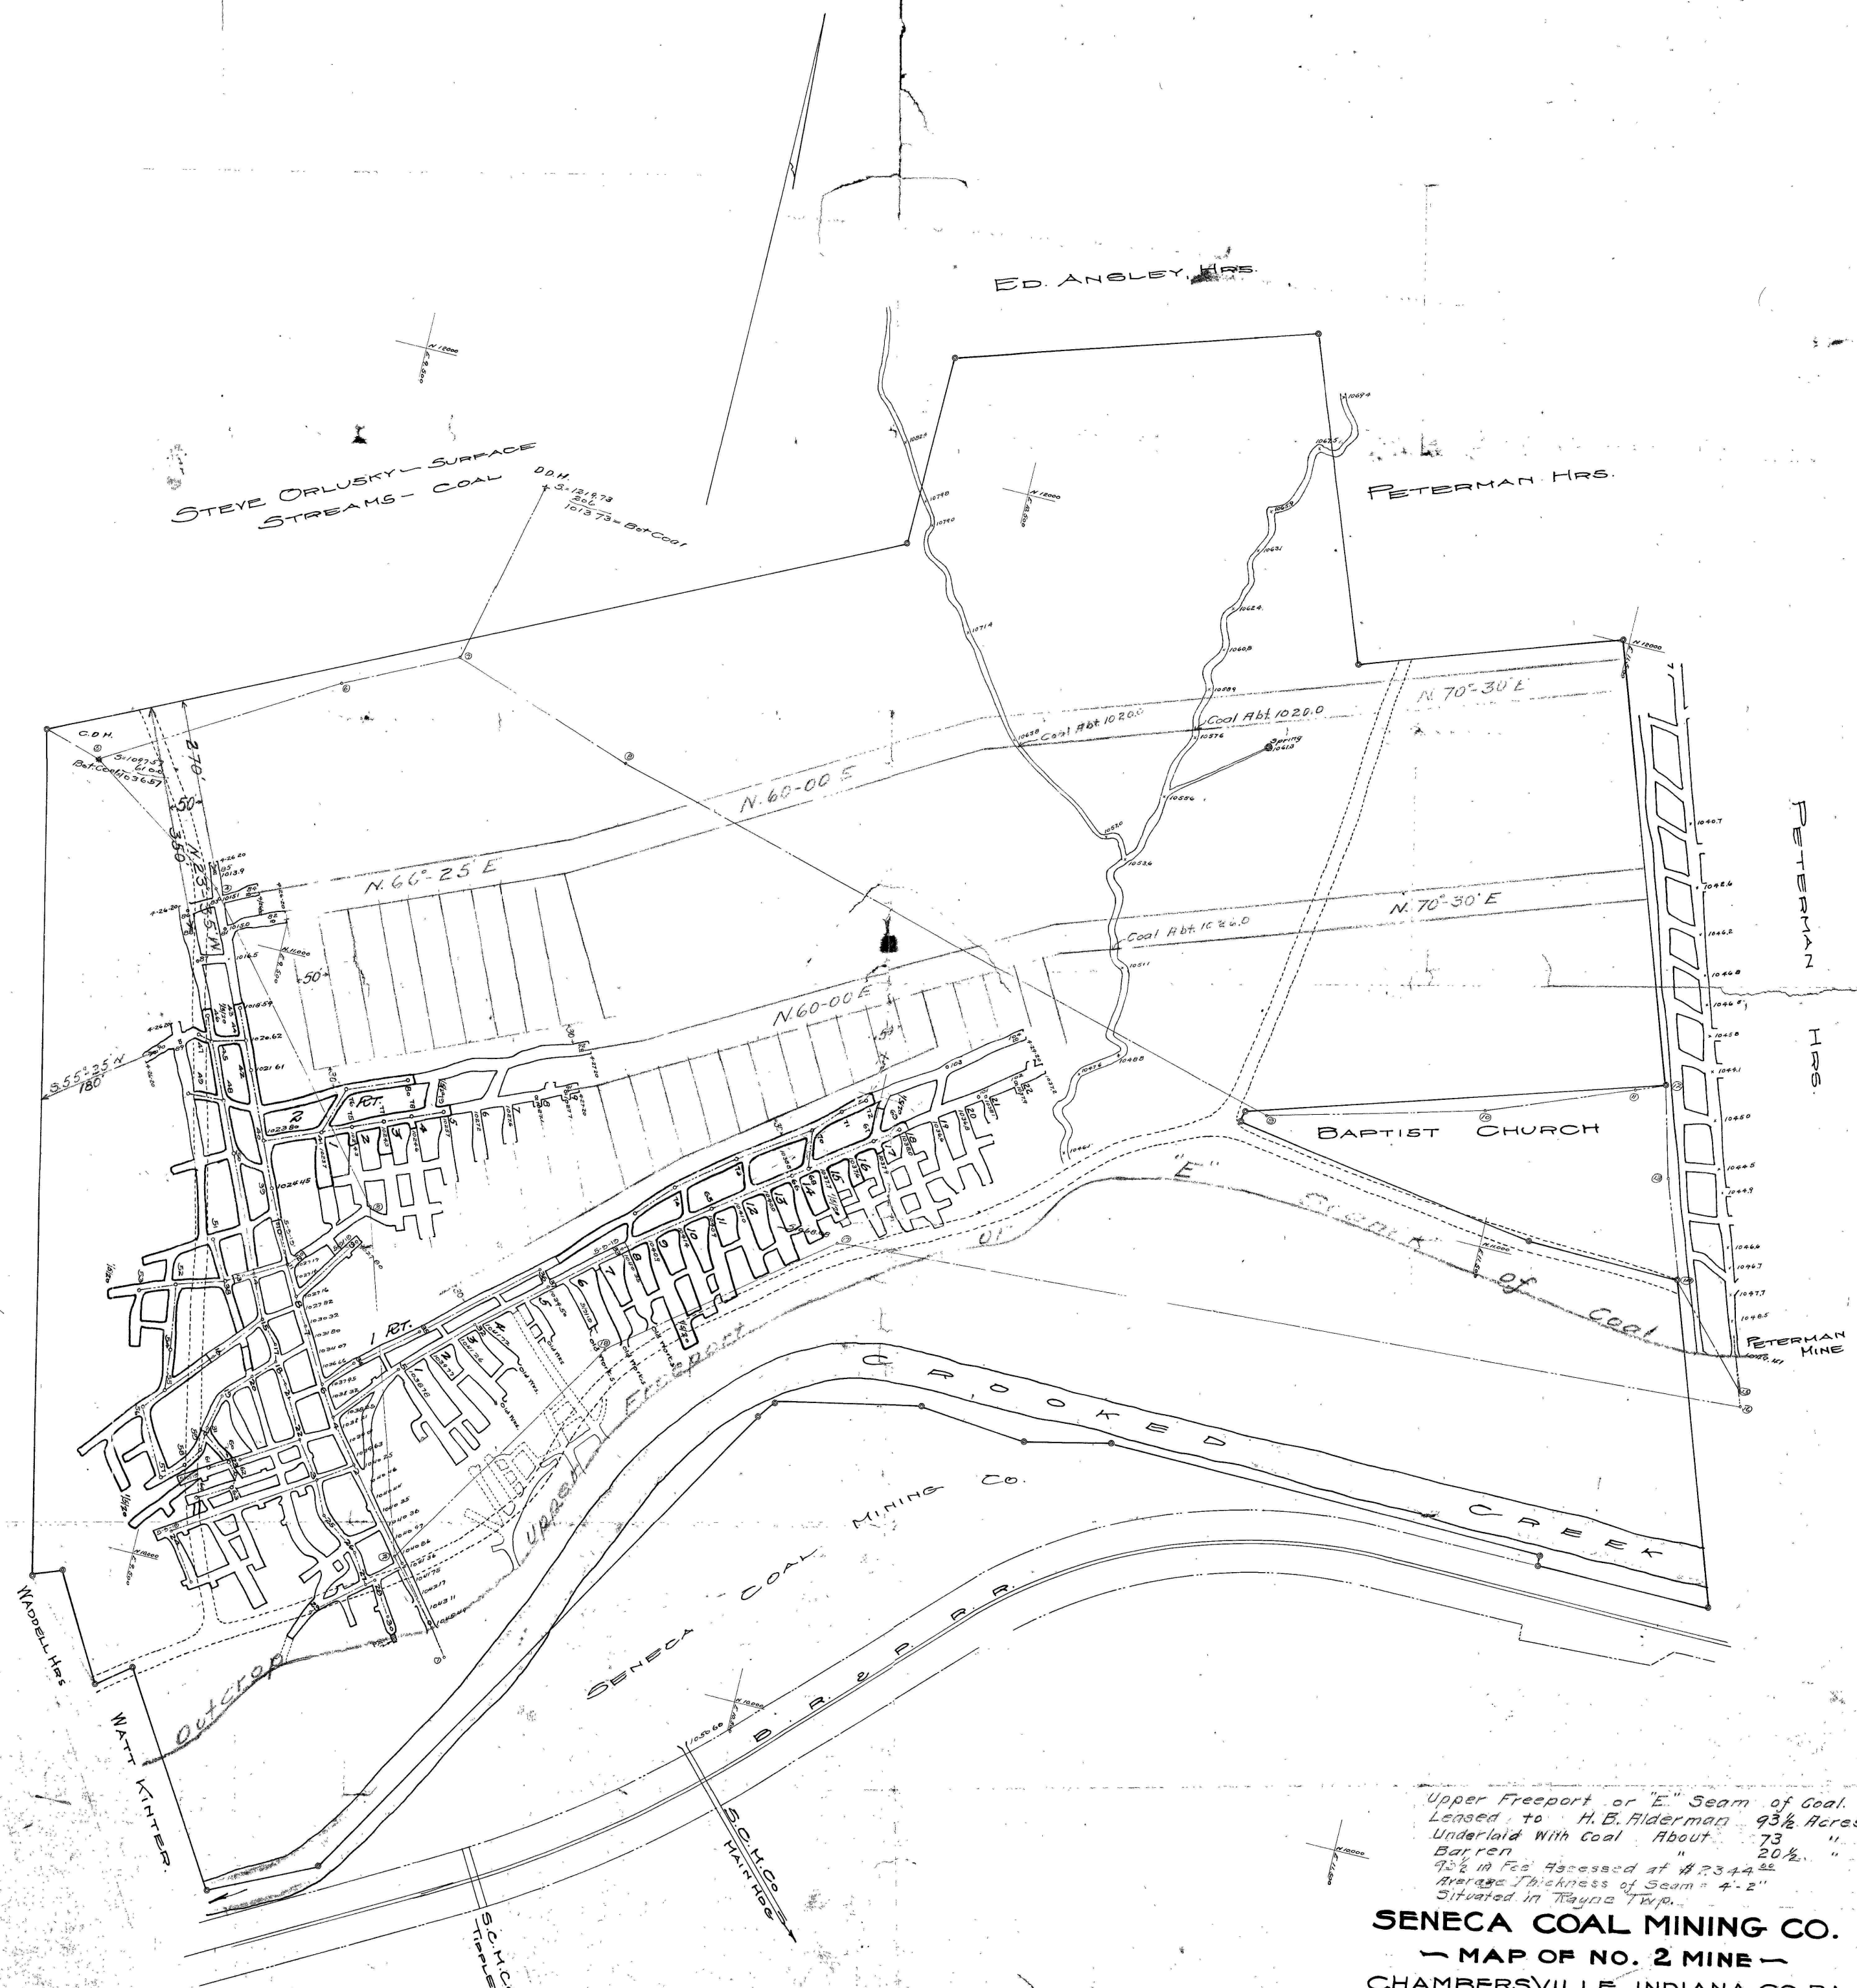

Upper Freeport or "E" Seam of Coal.
Leased to H.B. Alderman 93 1/2 Acres.
Underlaid With Coal About 73 "
Barren " 20 1/2 "
90% in Fee Accessed at \$2344.00
Average Thickness of Seam 4.2"
Situated in Wayne Twp.

SENECA COAL MINING CO.
— MAP OF NO. 2 MINE —
CHAMBERSVILLE, INDIANA CO., PA.

MAY 20, 1919 SCALE 1" = 100.0'

Thomas Pealer C.E.
Leander O.