


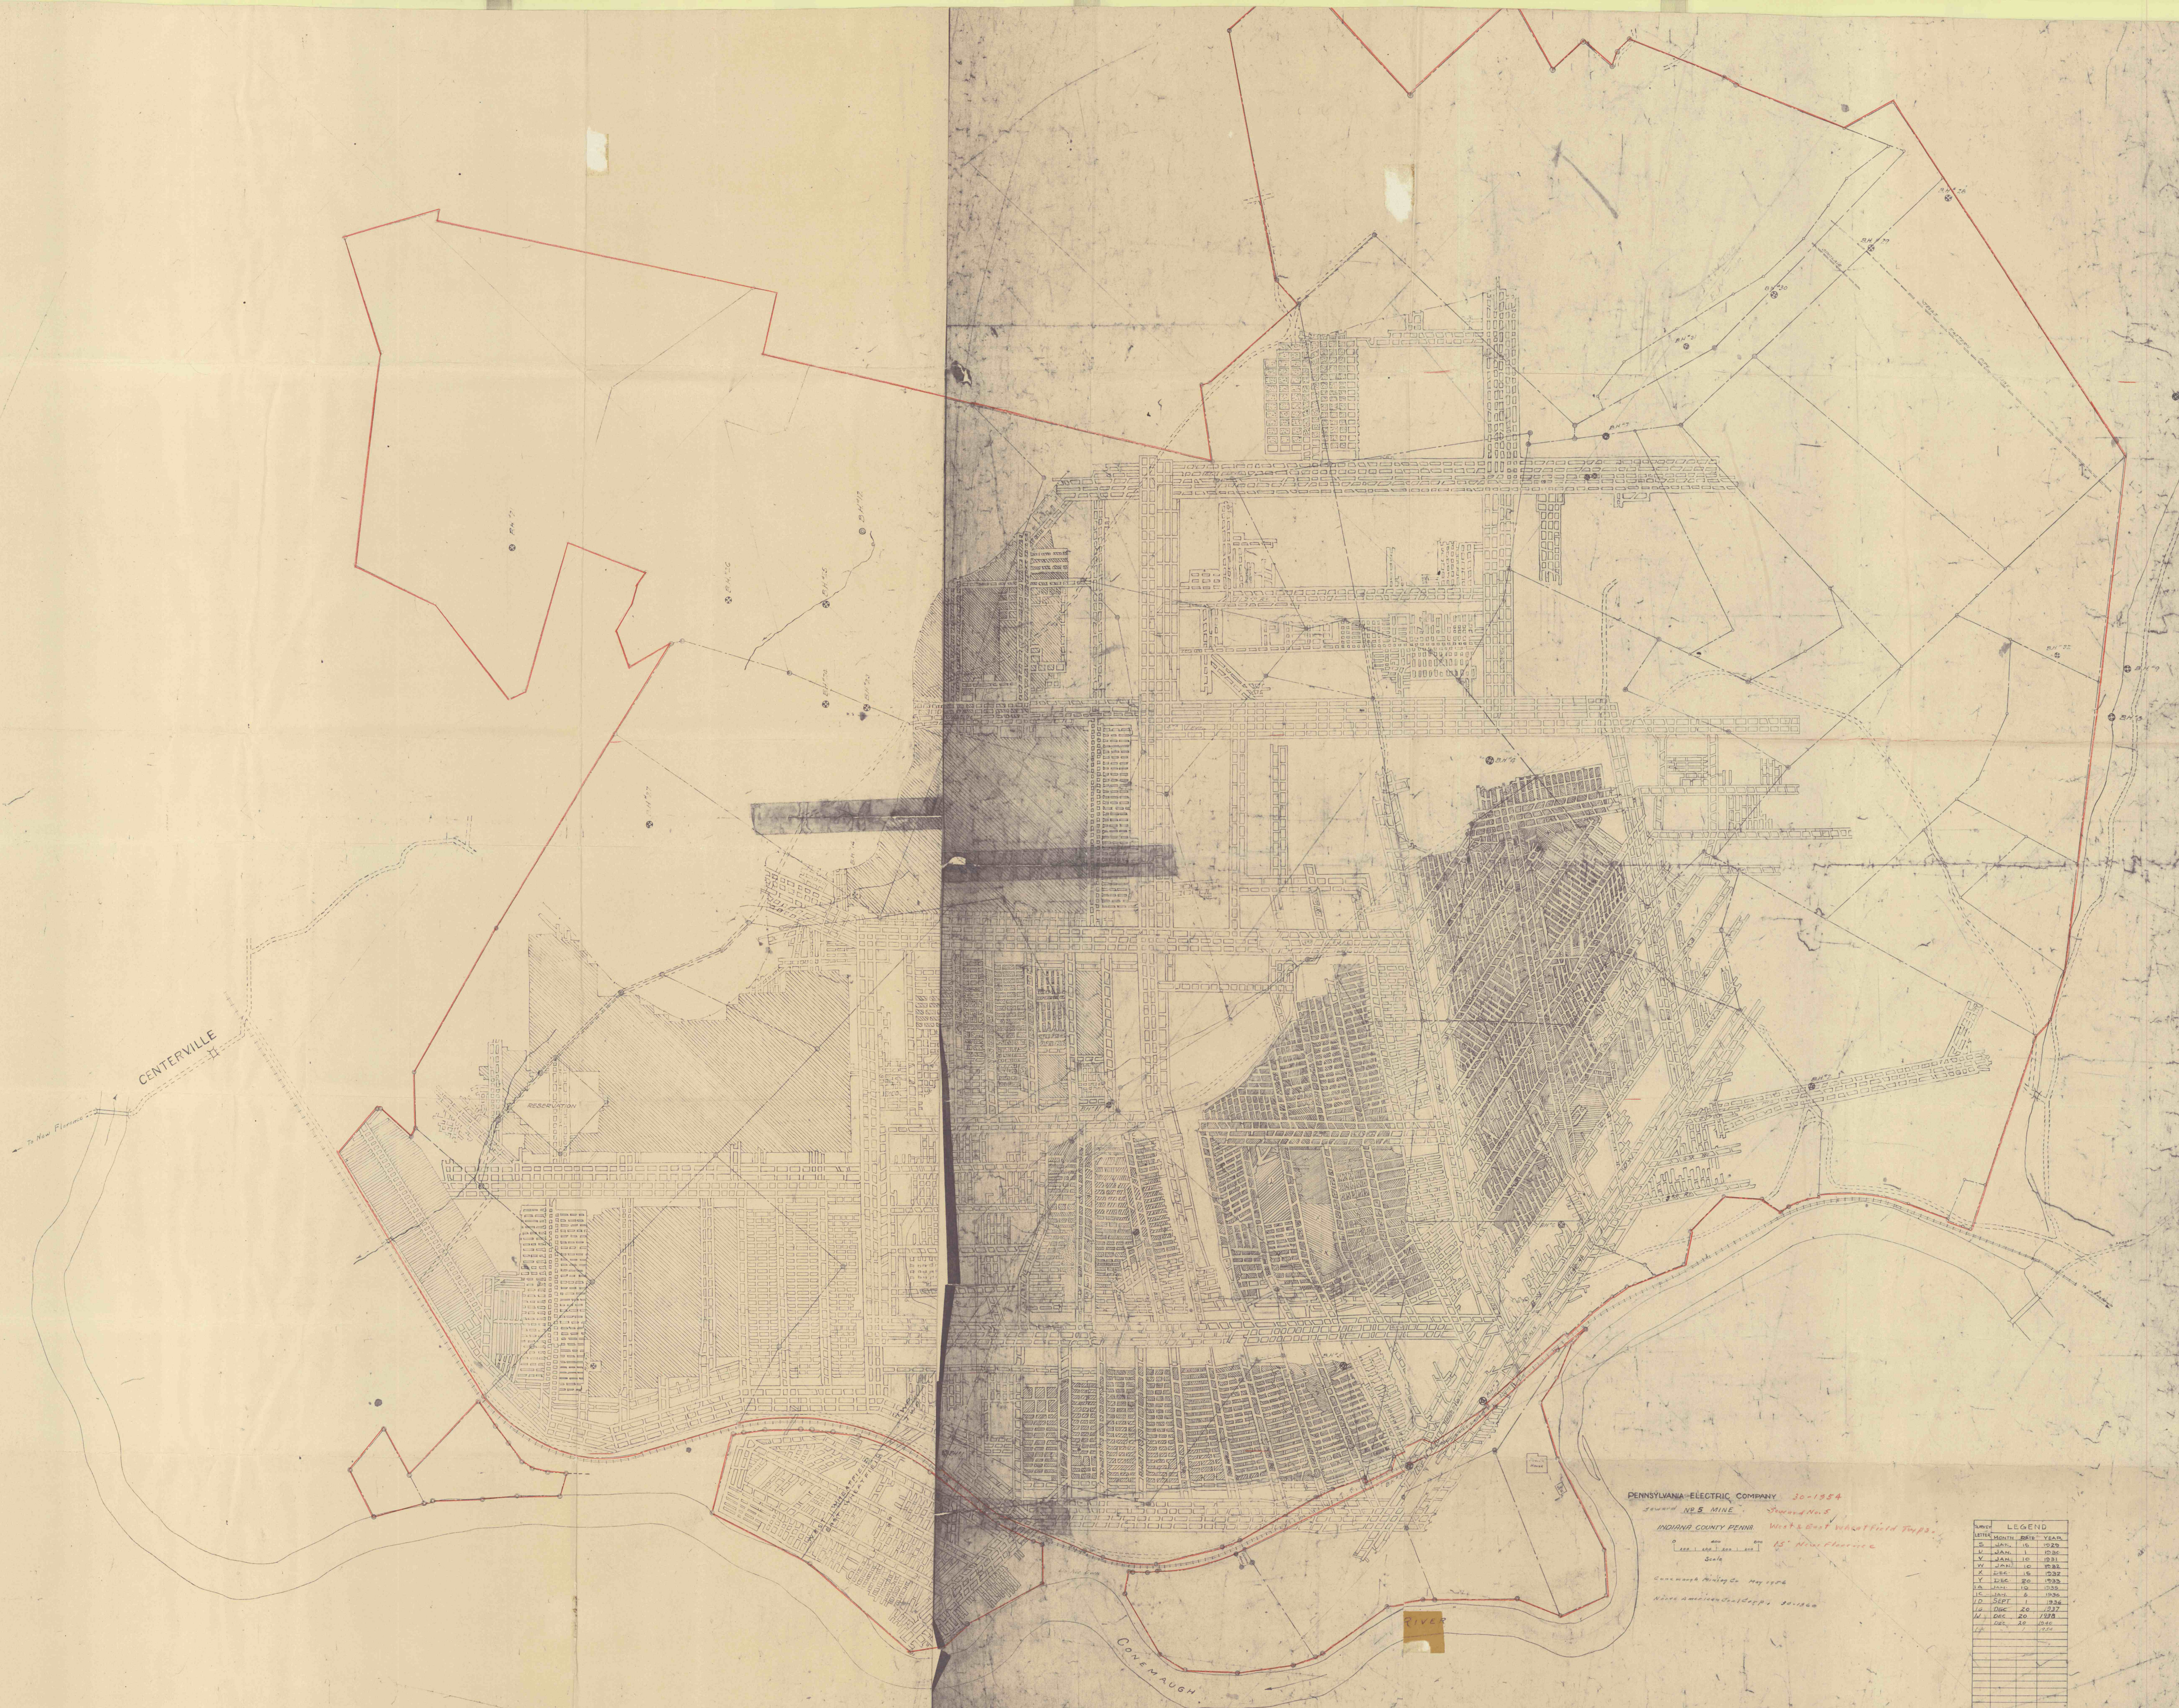

| SURVEY |       | LEGEND |      |  |
|--------|-------|--------|------|--|
| LETTER | MONTH | DATE   | YEAR |  |
| S      | JAN.  | 15     | 1925 |  |
| V      | JAN.  | 1      | 1926 |  |
| Y      | JAN.  | 10     | 1921 |  |
| W      | JAN.  | 10     | 1923 |  |
| X      | JEE.  | 15     | 1923 |  |
| Z      | JEE.  | 20     | 1923 |  |
| 1A     | JAN.  | 10     | 1925 |  |
| 1C     | JAN.  | 2      | 1926 |  |
| 1D     | SEPT  | 1      | 1923 |  |
| 1G     | DEC   | 20     | 1927 |  |
| 1H     | DEC   | 20     | 1929 |  |
| 1I     | DEC   | 20     | 1926 |  |
|        |       |        | 1925 |  |