
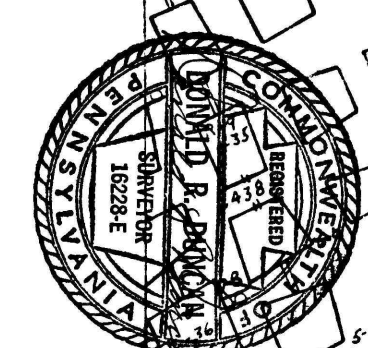
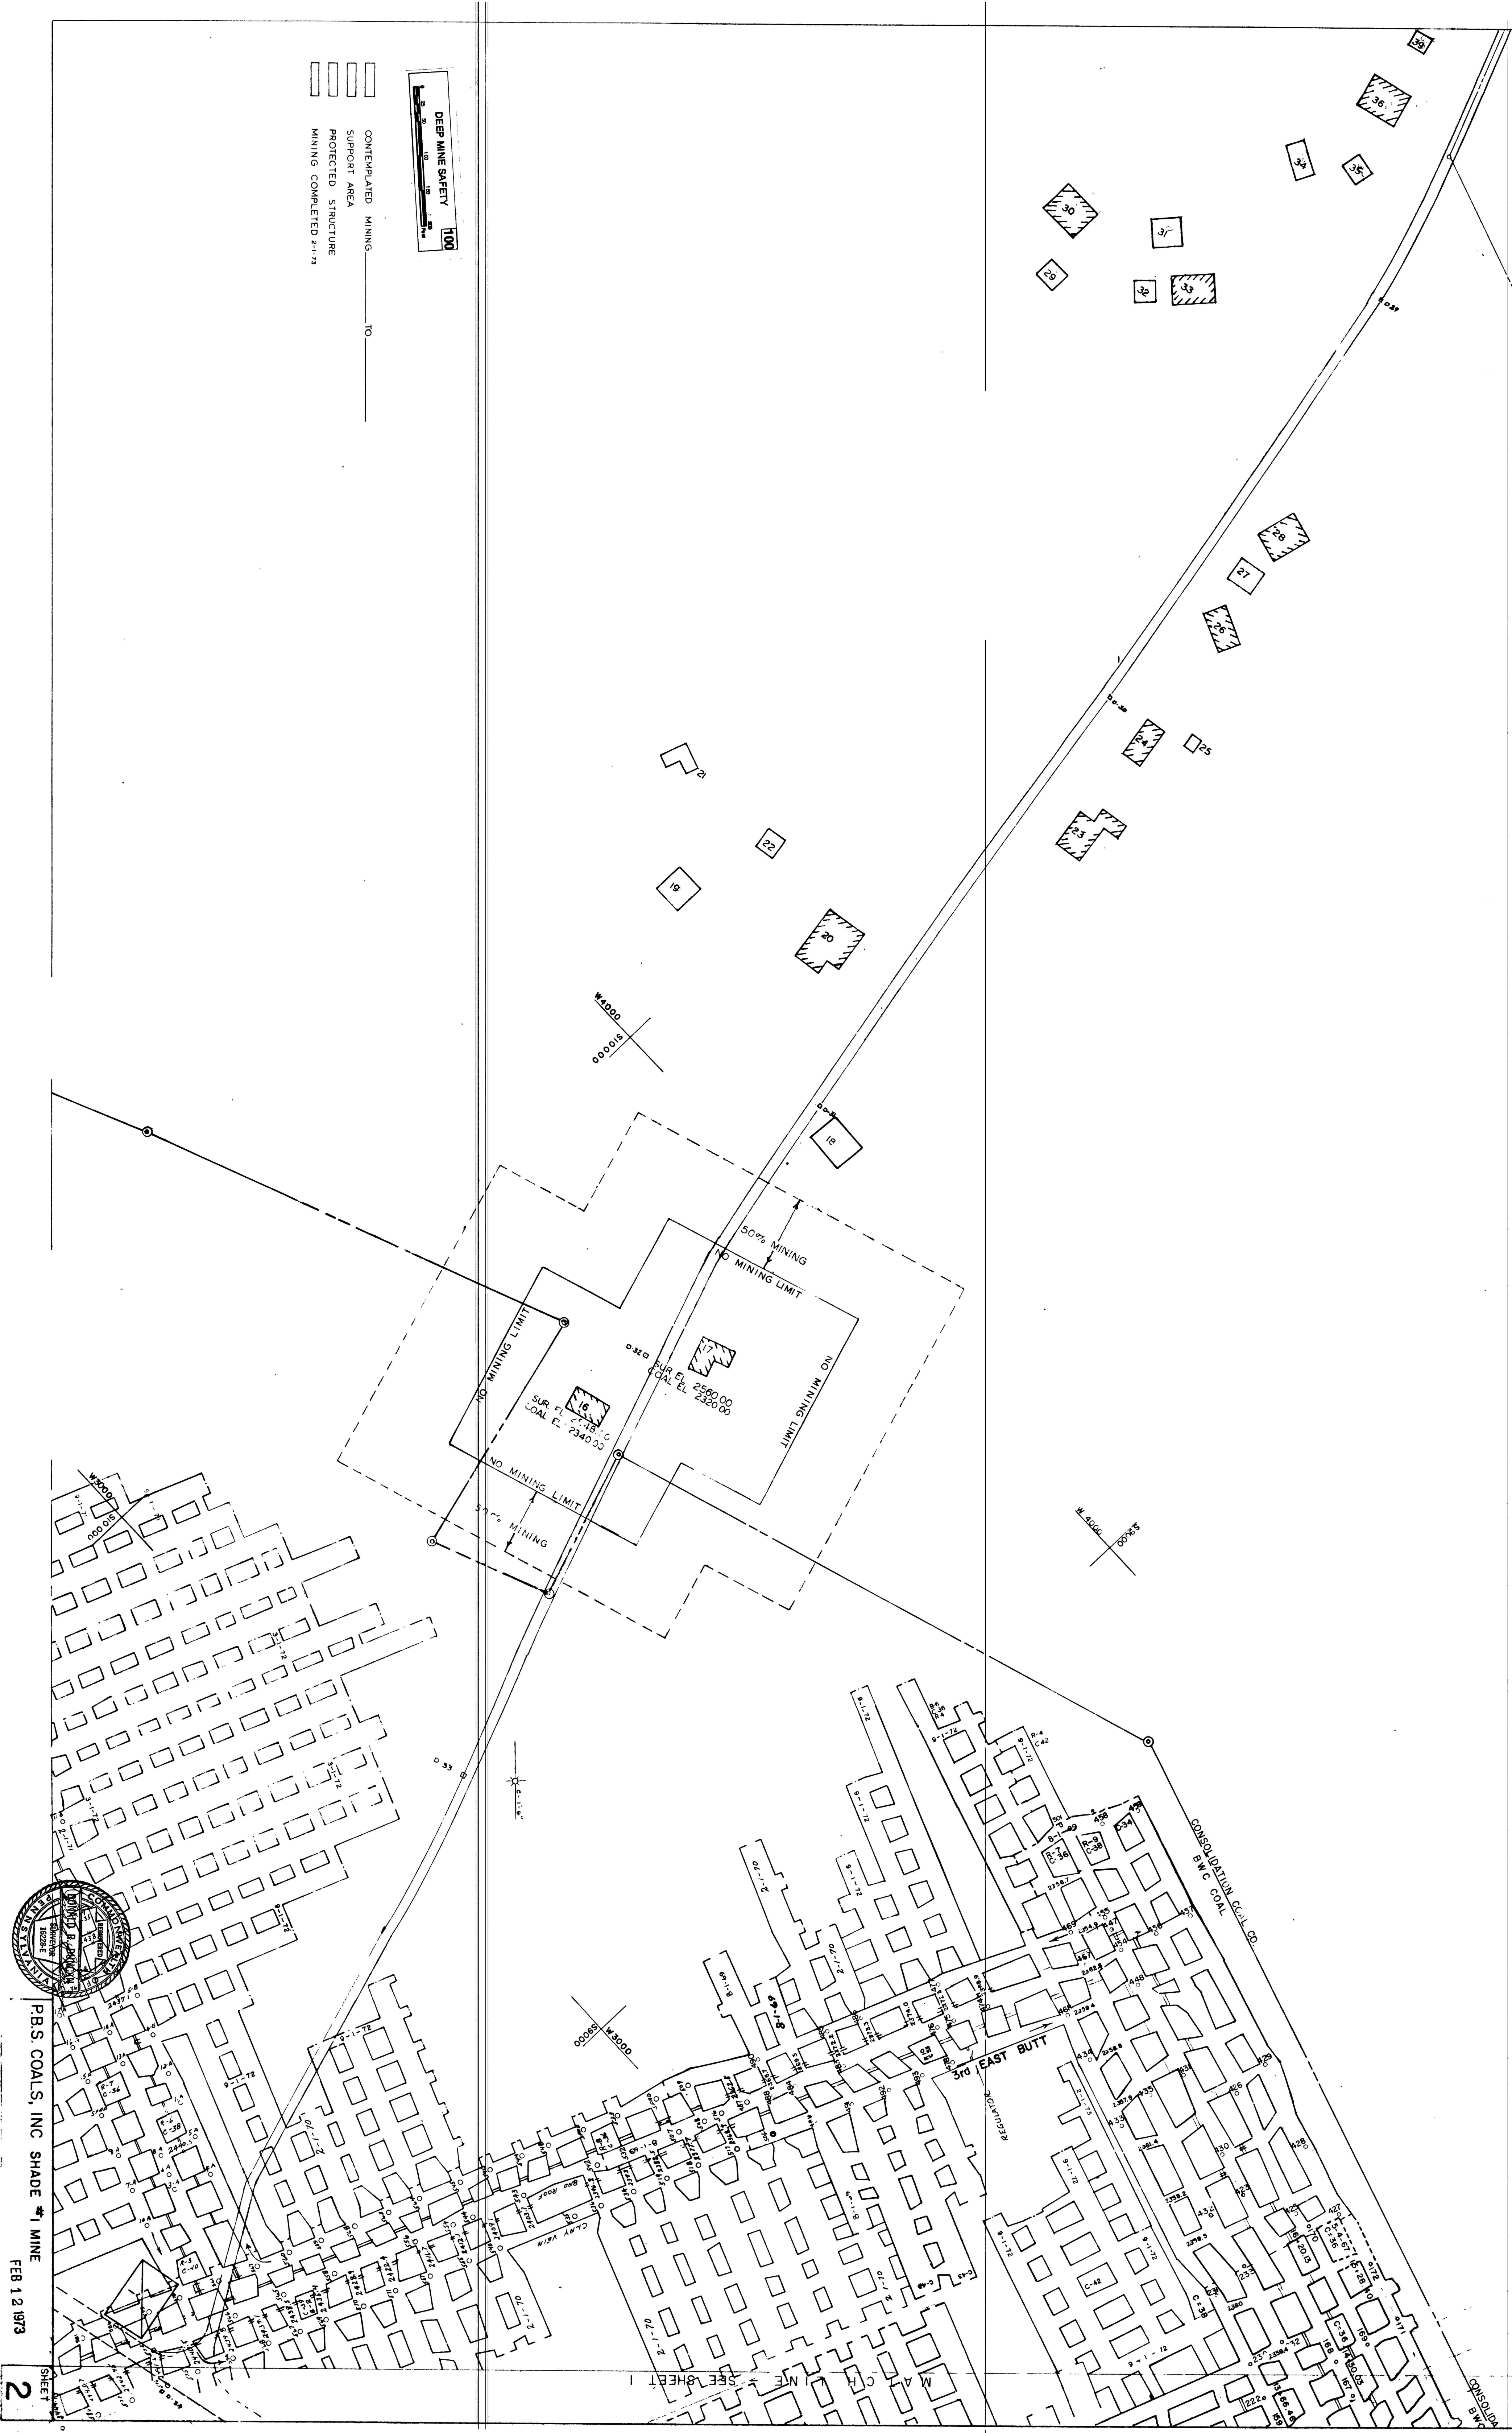


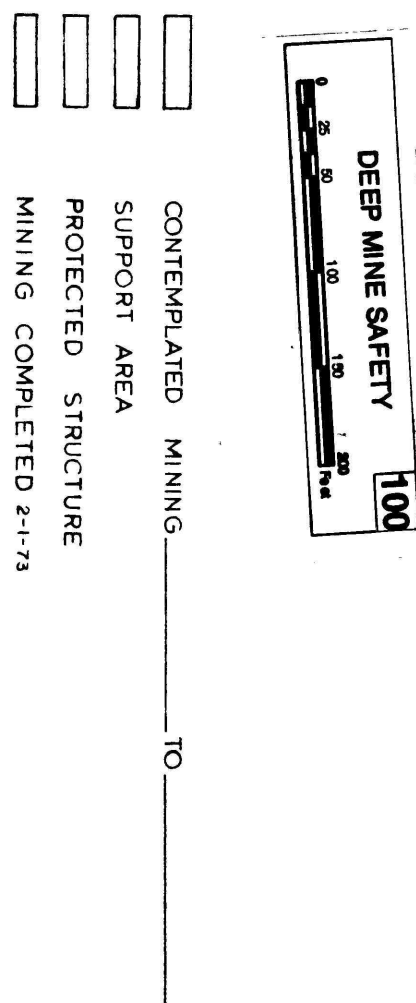

P.B.S. COALS, INC. SHADE #1 MINE
FEB 12 1973