




P.B.S. COALS, INC.
SHADE #1 MINE
"C" PRIME SEAM

SHADE TOWNSHIP, SOMERSET COUNTY, PENNSYLVANIA
SCALE: 1" = 100'

DONALD H. DUNCAN
REGISTERED SURVEYOR
16228-C

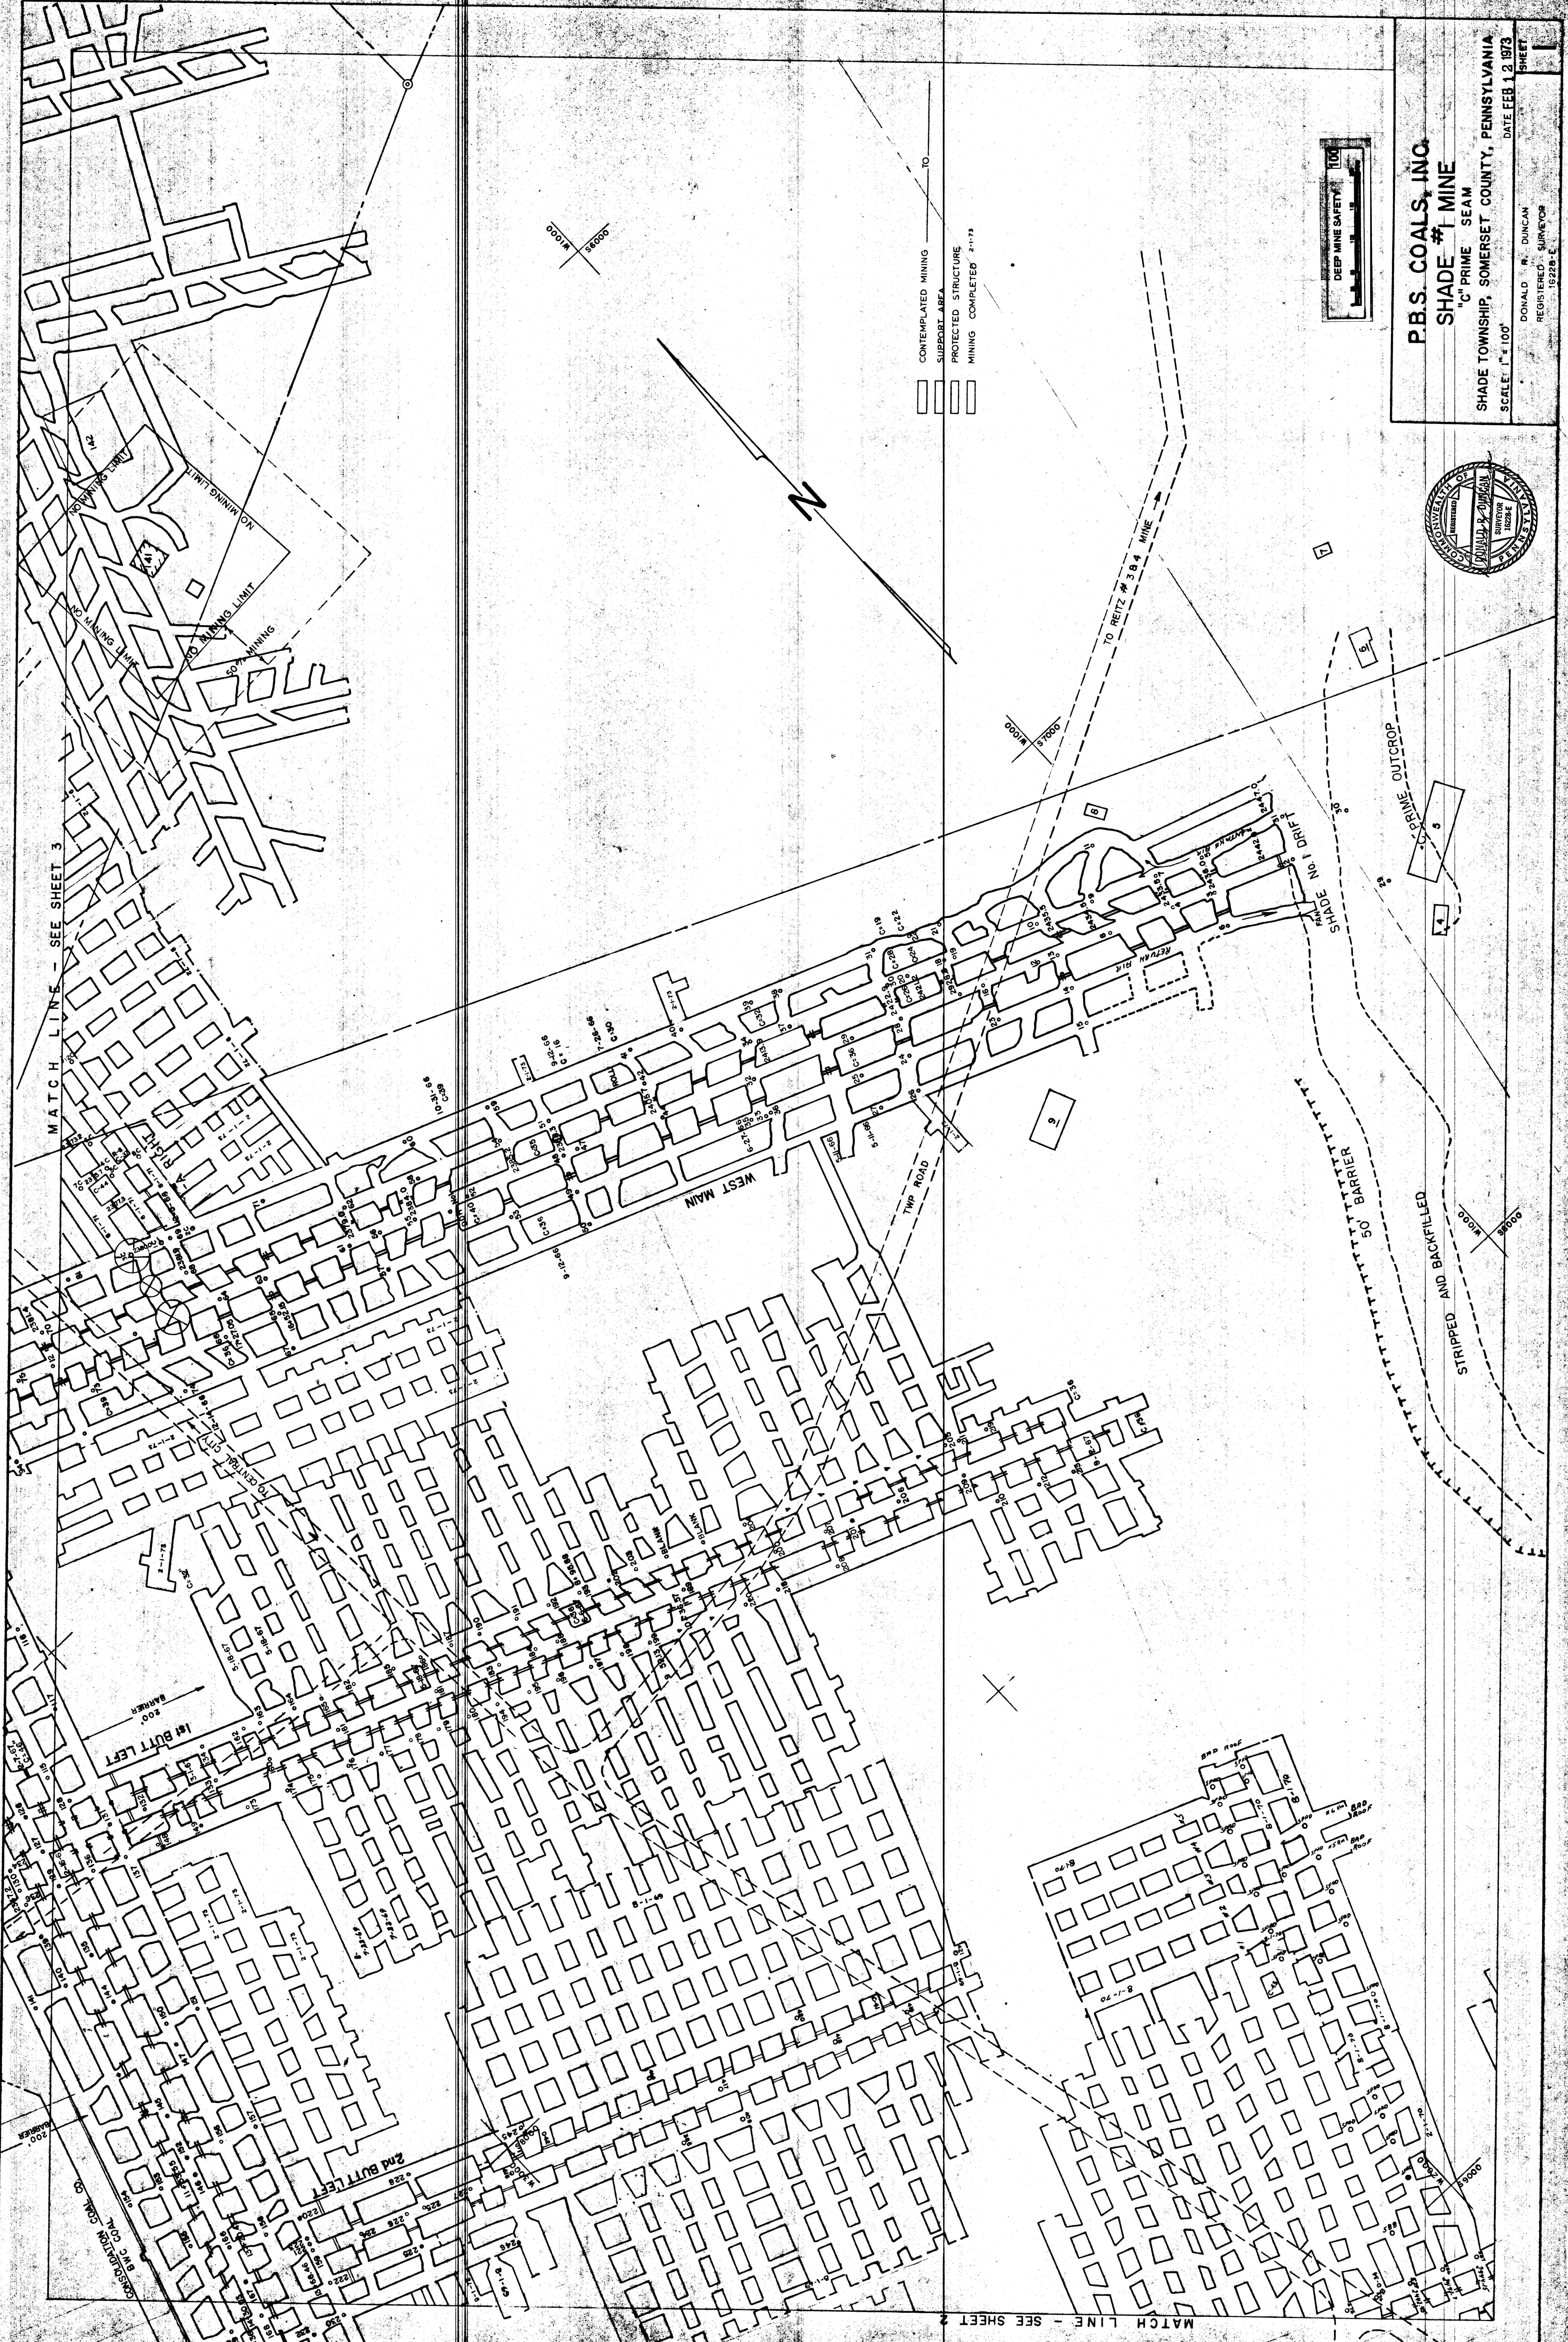