
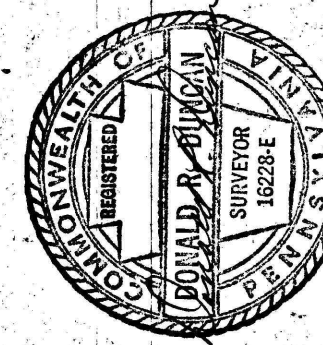


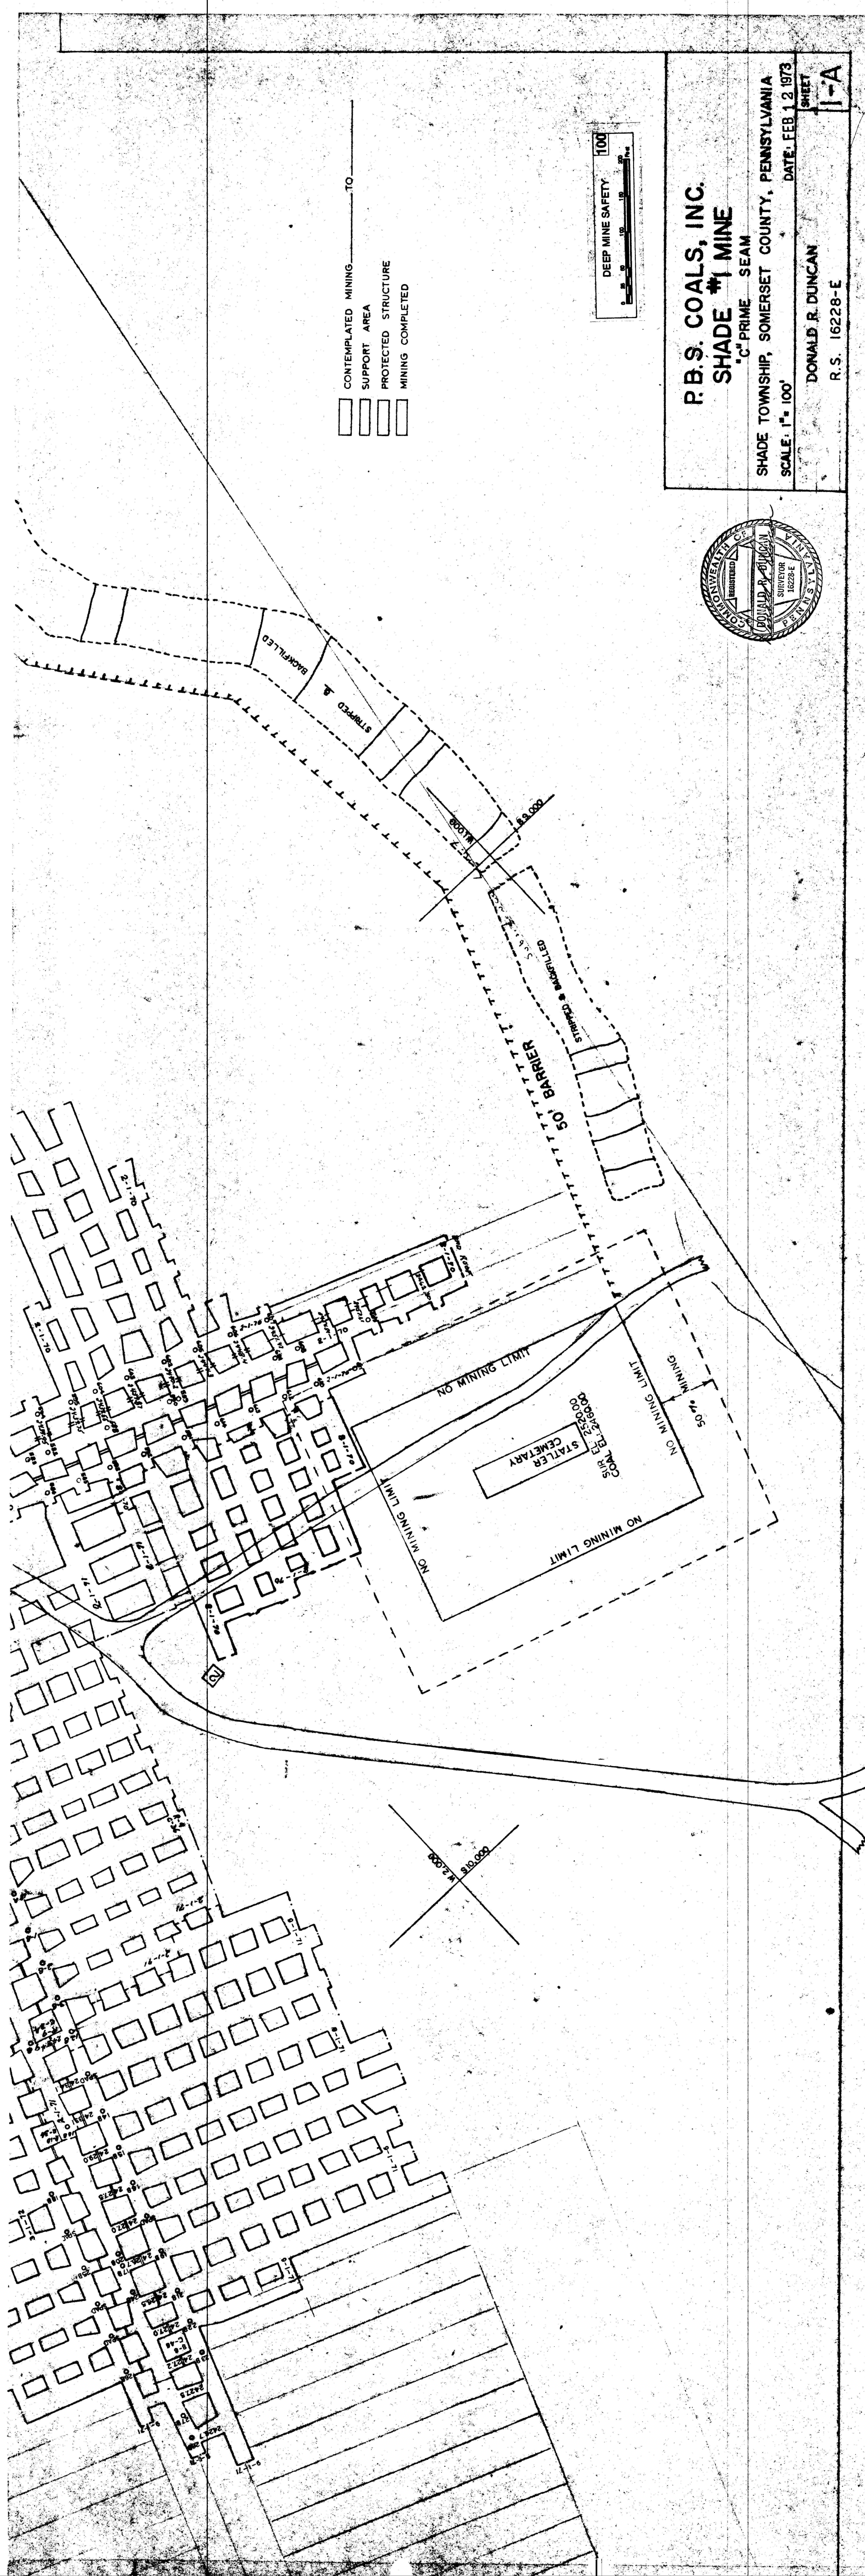

P.B.S. COALS, INC.
SHADE #1 MINE
"C" PRIME SEAM
SHADE TOWNSHIP, SOMERSET COUNTY, PENNSYLVANIA
SCALE: 1" = 100'
DATE: FEB. 12, 1973
DONALD R. DUNCAN
R.S. 16228-E
SHEET
1-A