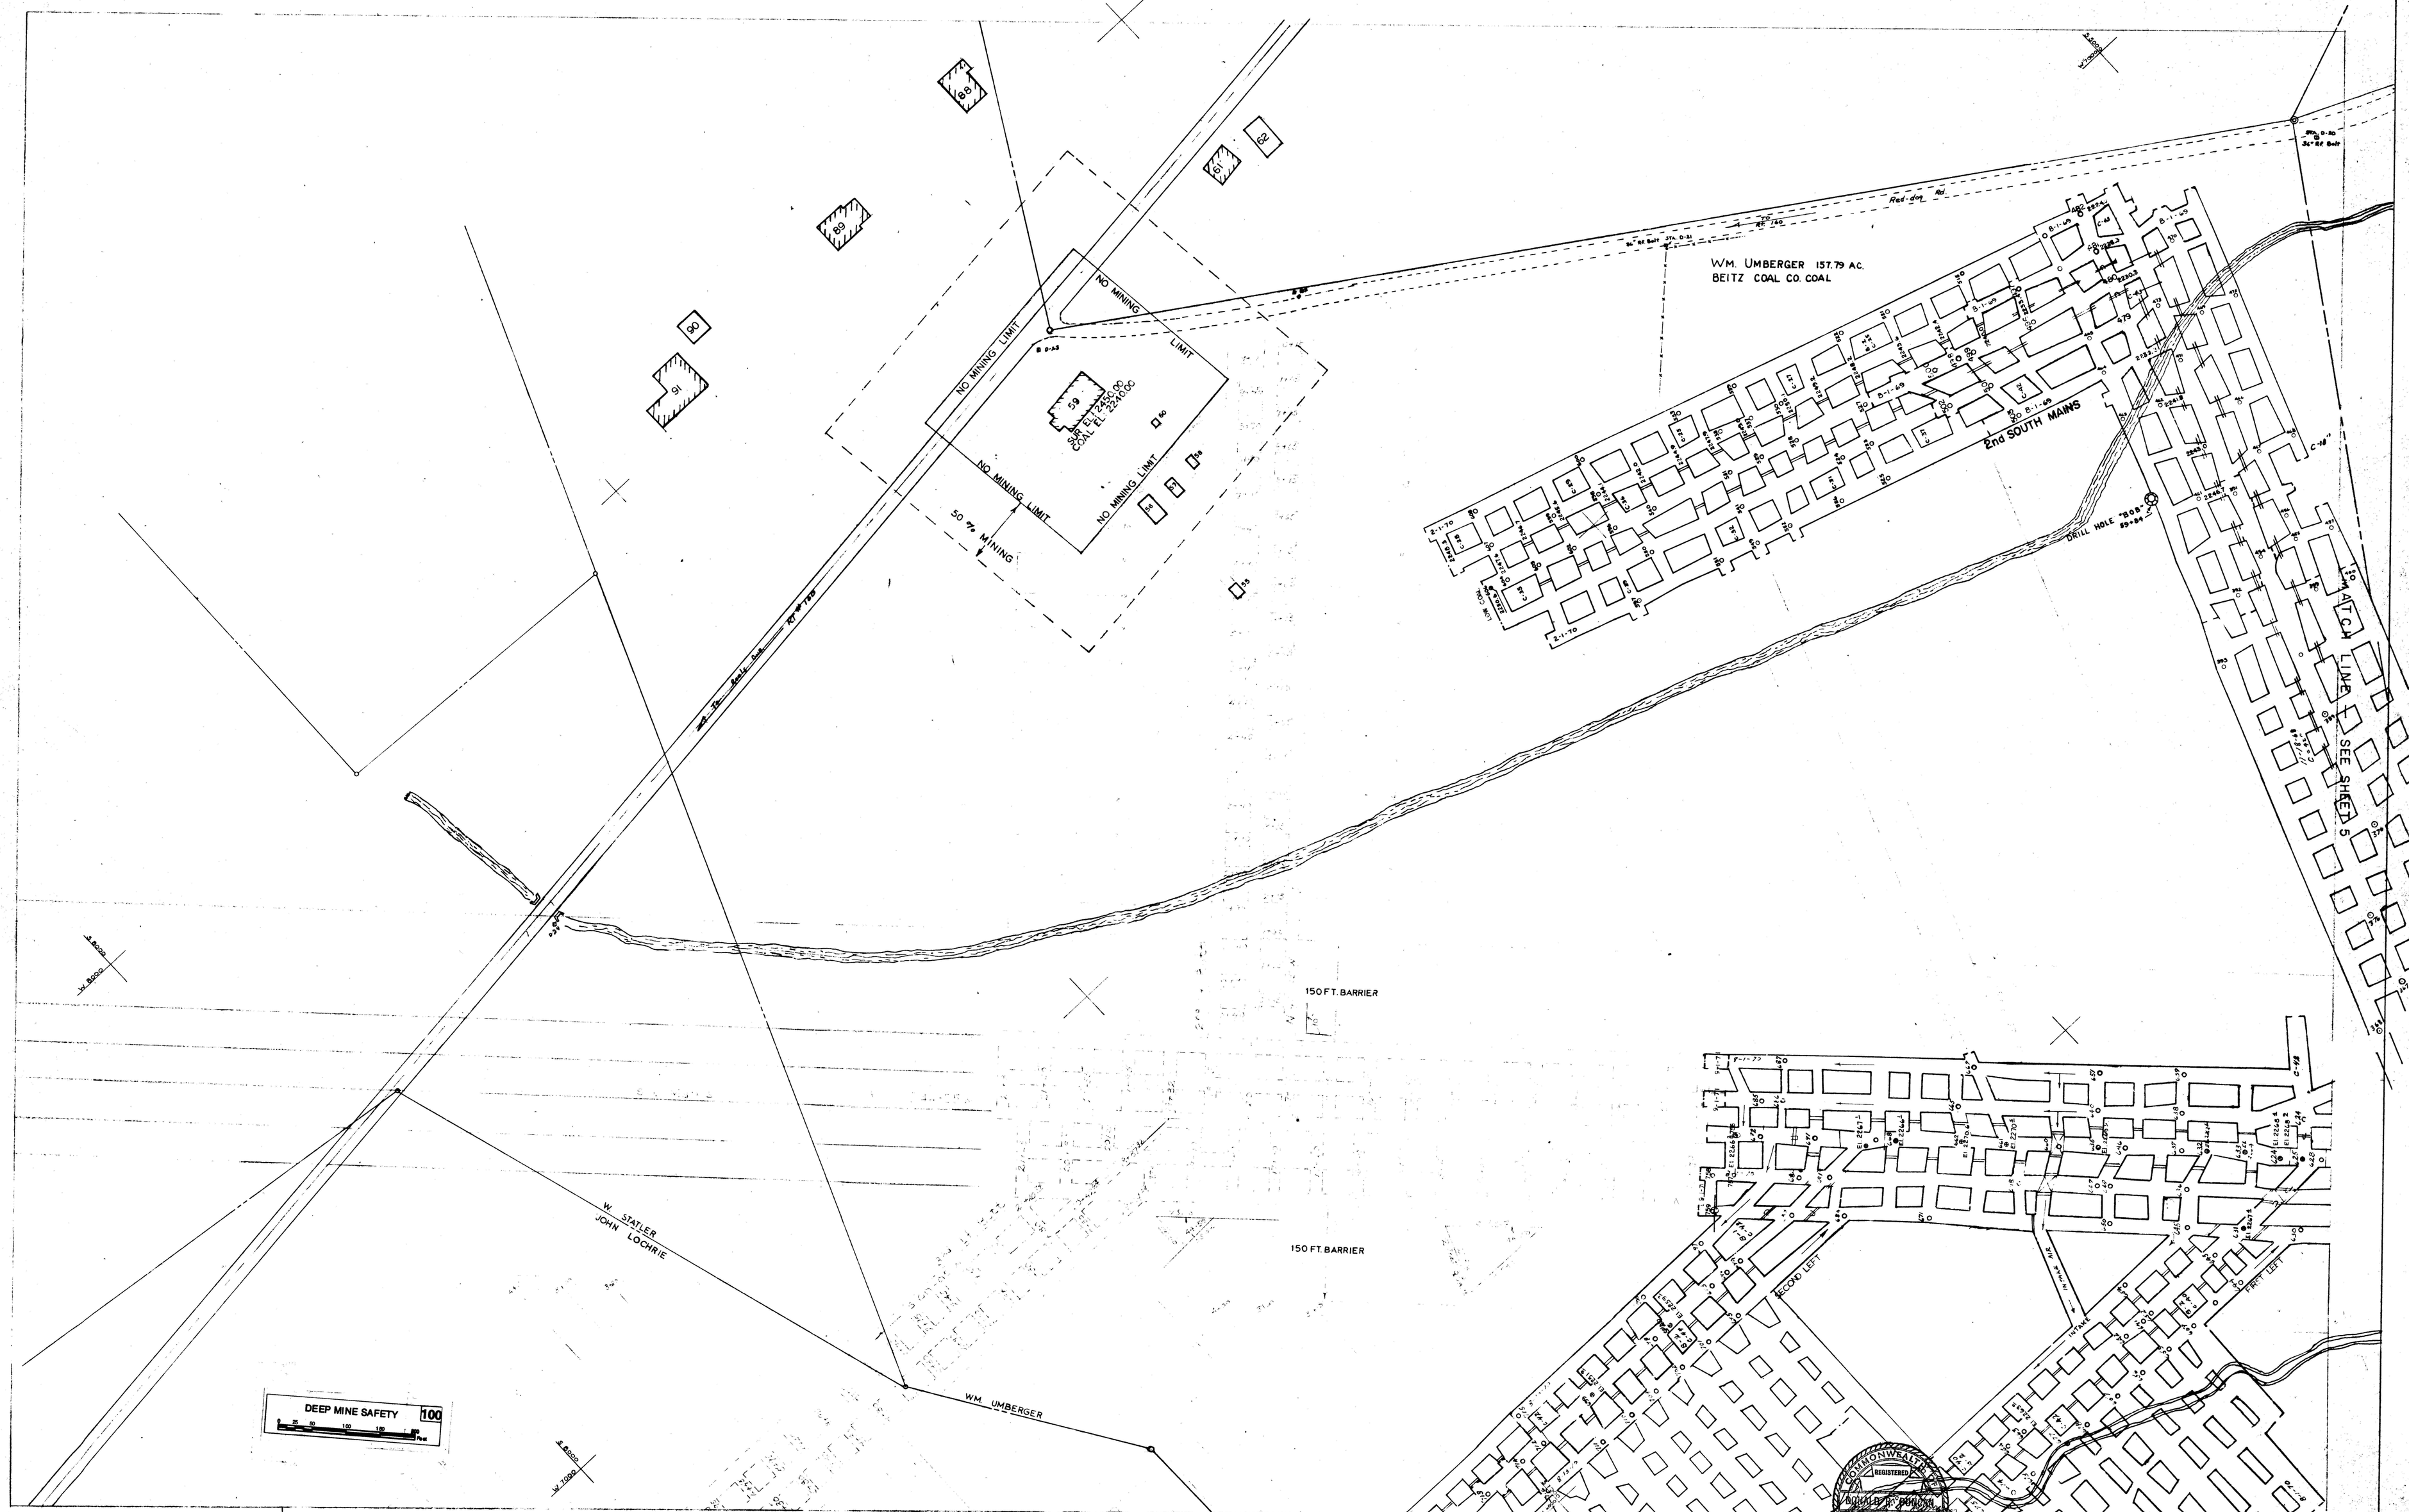

P.B.S. COALS, INC. SHADE #1 MINE

FEB 12 1973

SHEET 6