


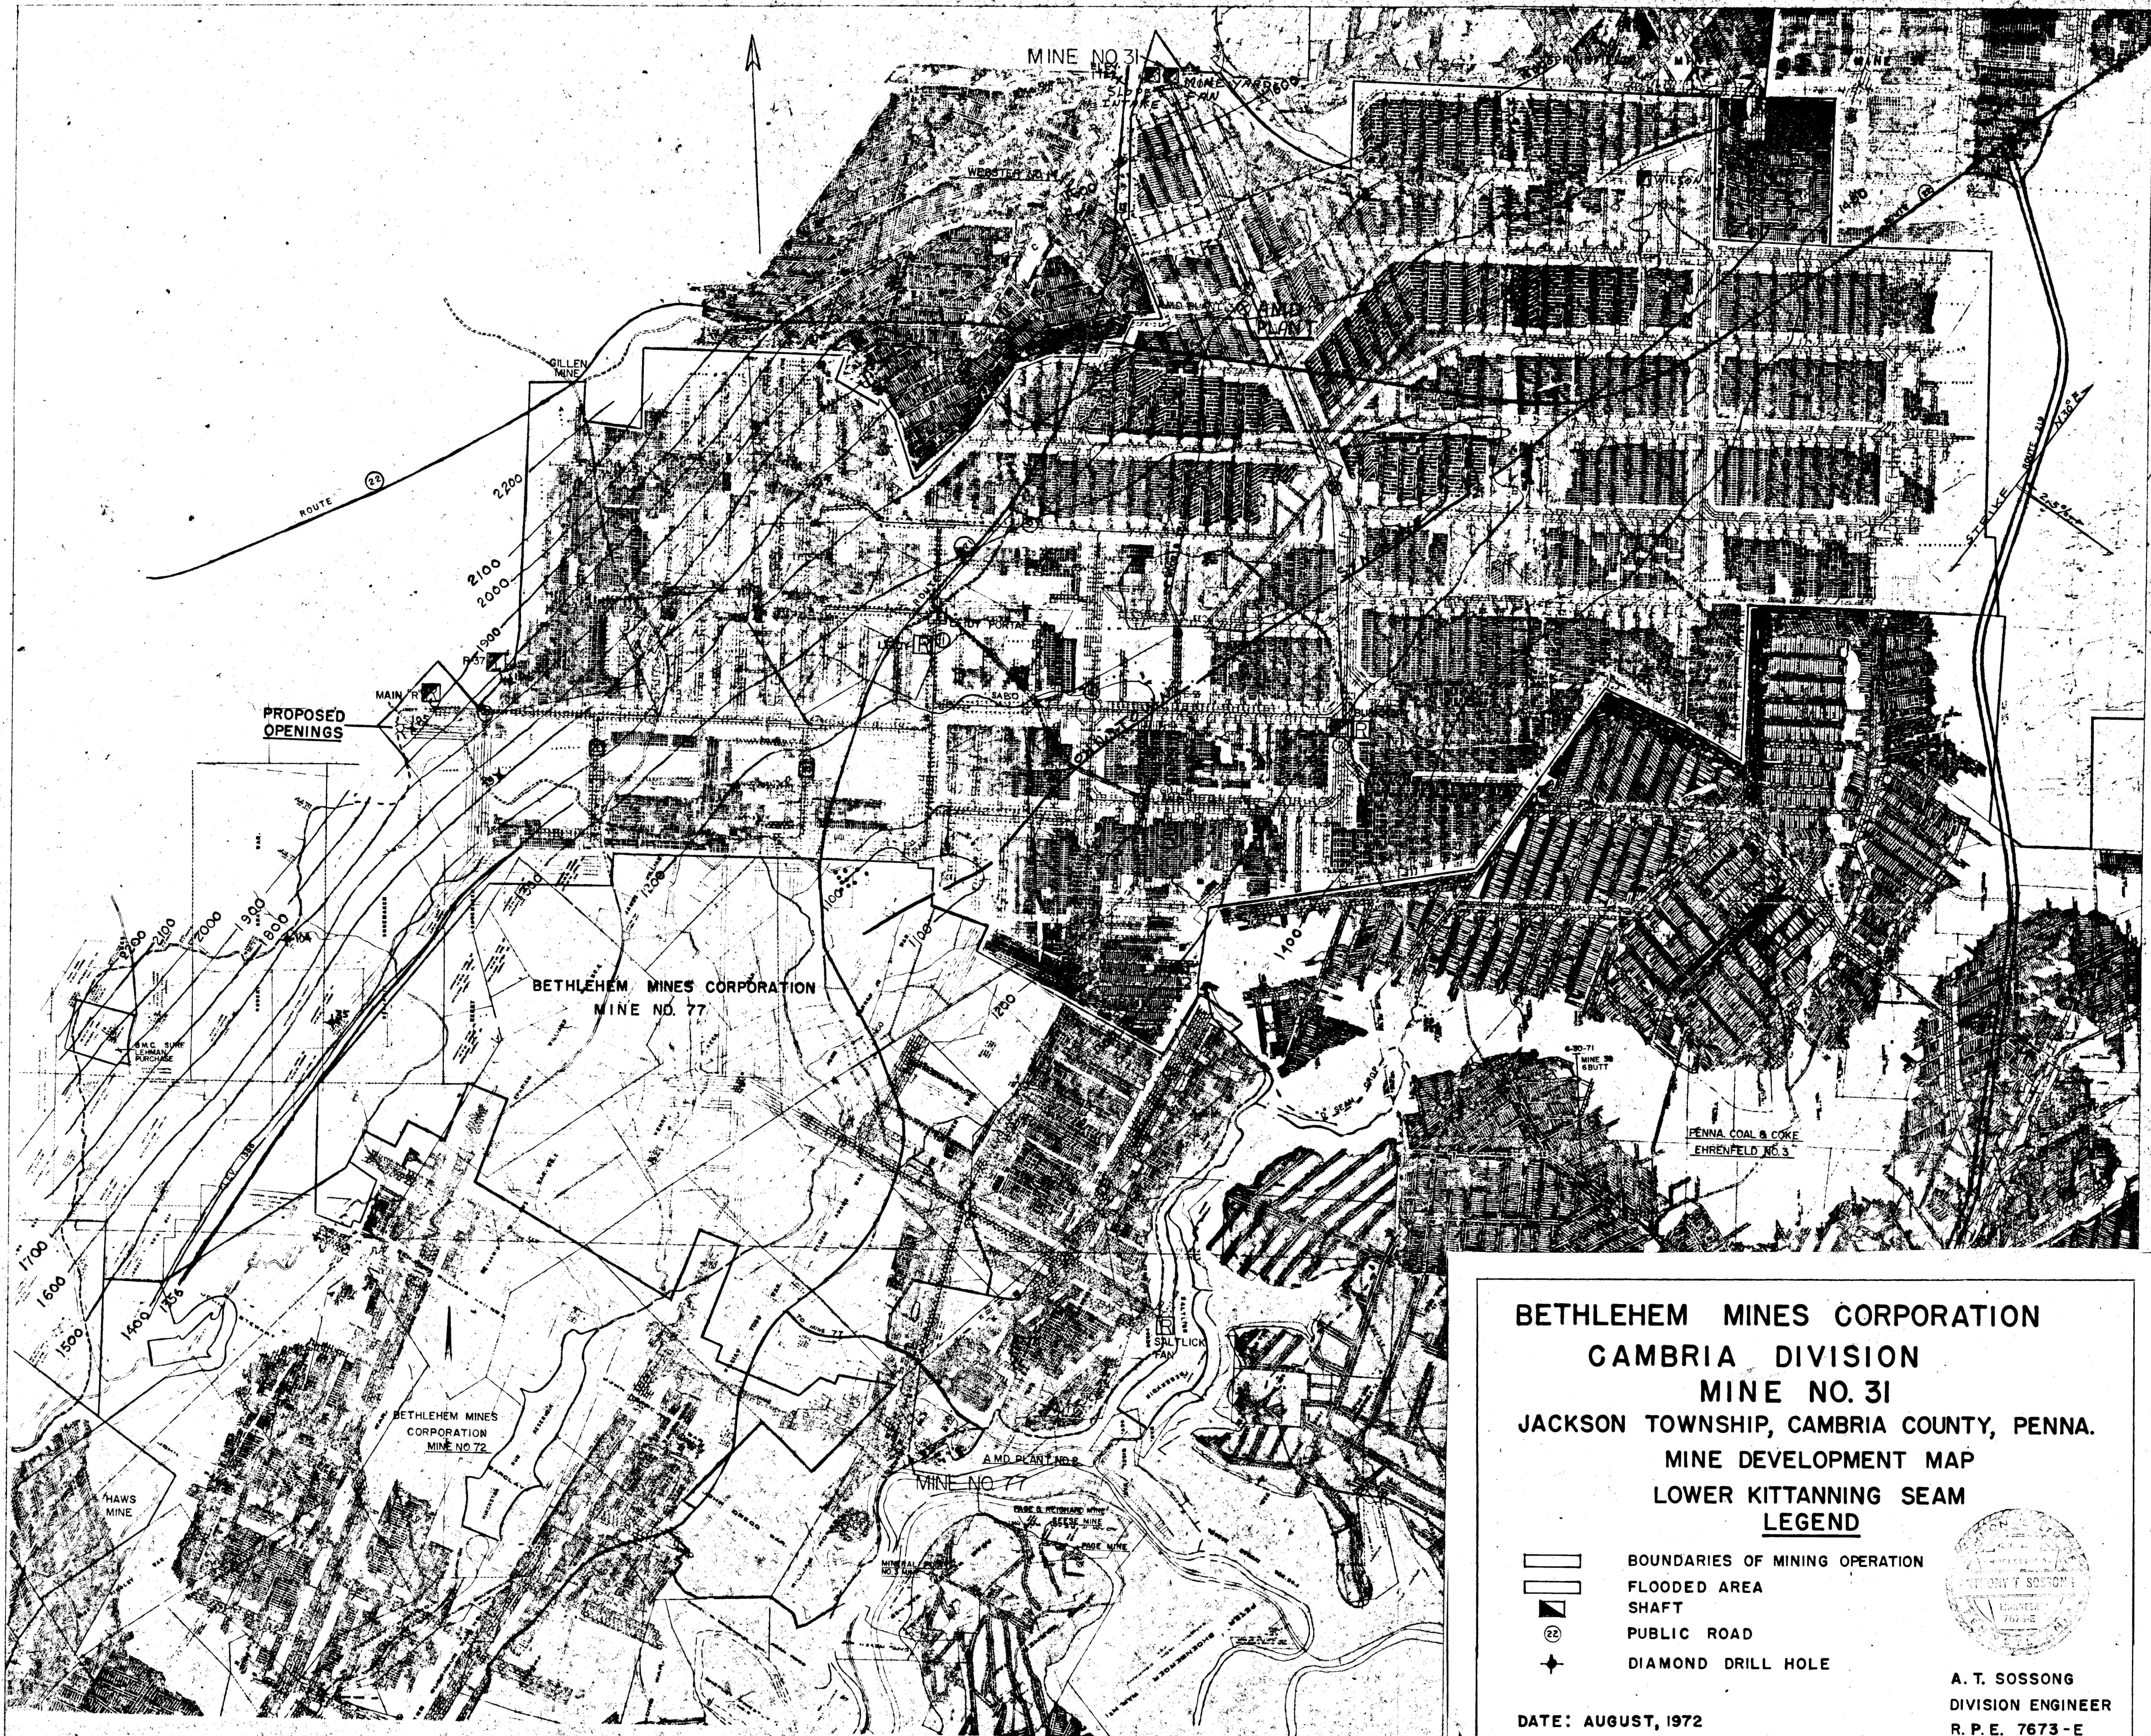


BETHLEHEM MINES CORPORATION
CAMBRIA DIVISION
MINE NO. 31
JACKSON TOWNSHIP, CAMBRIA COUNTY, PENNA.
MINE DEVELOPMENT MAP
LOWER KITTANNING SEAM
LEGEND

- BOUNDARIES OF MINING OPERATION
- FLOODED AREA
- SHAFT
- PUBLIC ROAD
- DIAMOND DRILL HOLE

DATE: AUGUST, 1972

2000 1000 0 2000 4000
SCALE

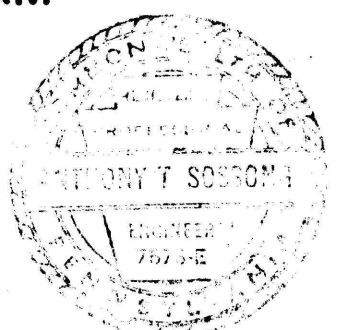

A. T. SOSSONG
DIVISION ENGINEER
R. P. E. 7673-E

A. T. Sossong
EXHIBIT-3