


Chas. K. Shaffer
Mine Survey

May 15, 1935
and
October 1, 1935
Scale: 1"=50'

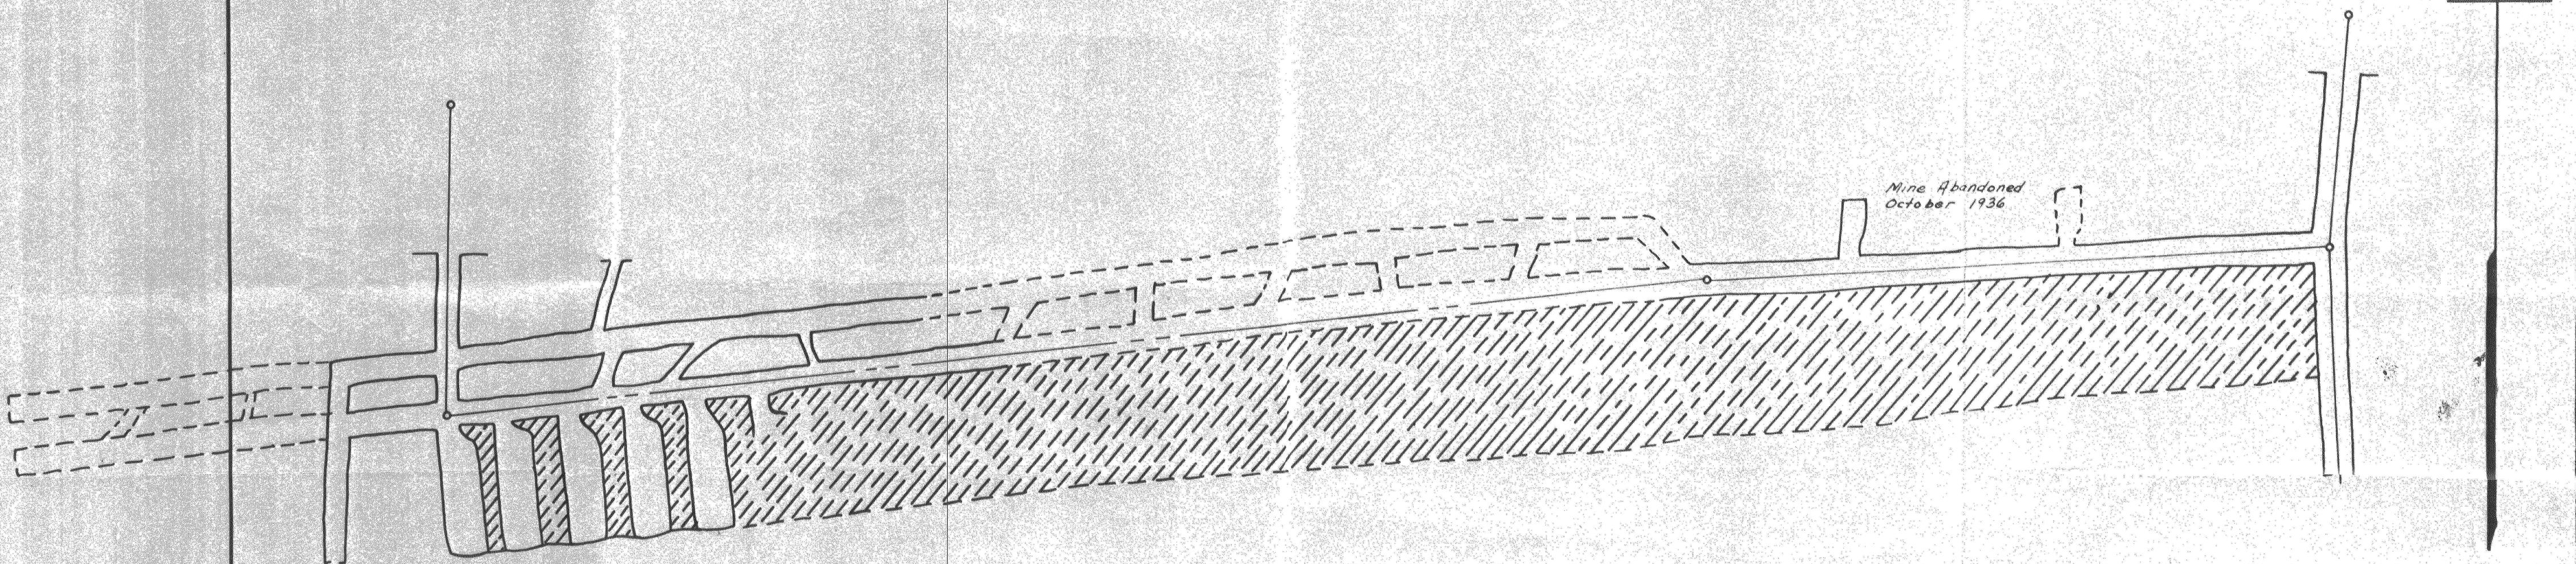

Note: This is a copy of a blue print
made from the original tracing.
Survey in 1935. Lines plotted from
information from Operator Chas. K. Shaffer
Lodowick Coal Co.

Post Office Department The B.W.C.M. Co.

Situate in Shade Township
Somerset County Pennsylvania
James M. Coale Surveyor
Berlin
Penna