


L. C. Co.

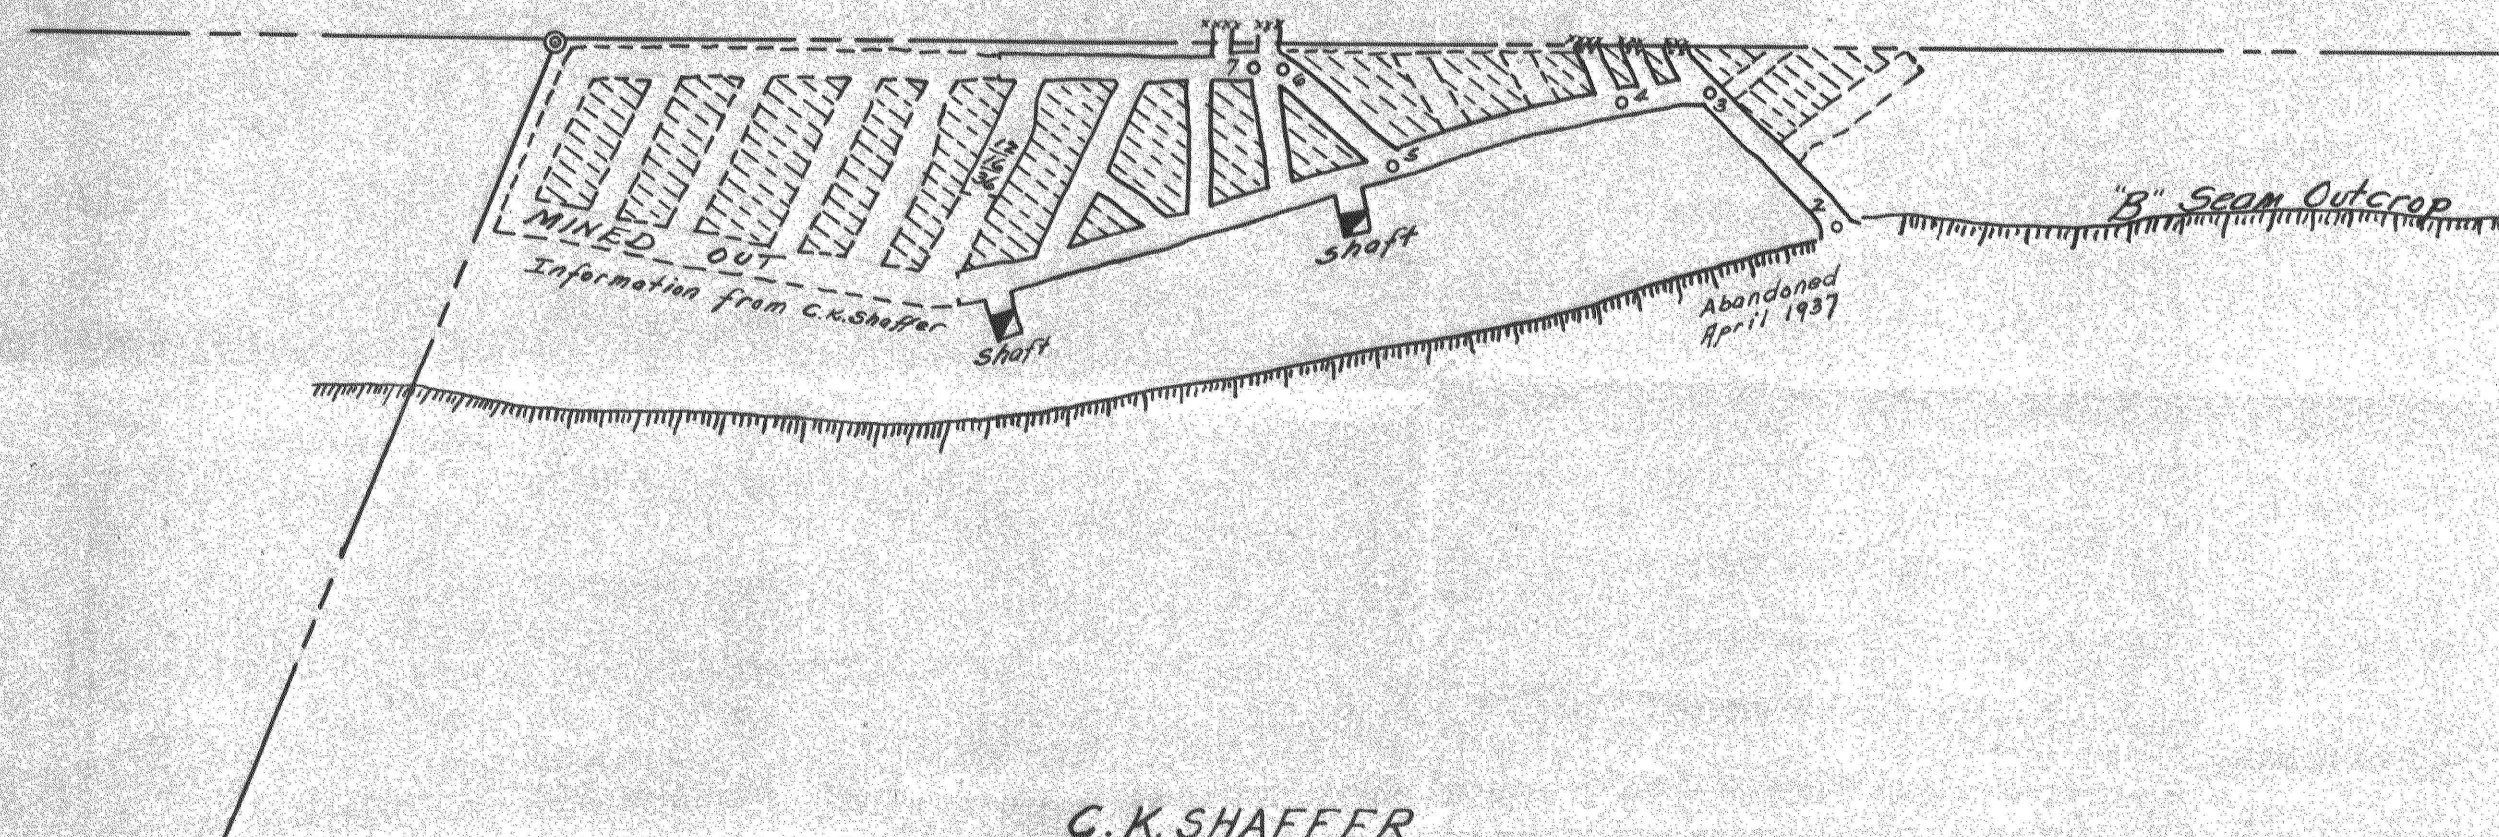

C. K. SHAFFER
No. 3 MINE

Shade Twp.
Scale 1"=100'

Somerset County Pa.
Dec. 16, 1936

I hereby certify that this is a true and correct copy of the original survey of the mine workings as shown by solid lines, in addition to the workings shown by dotted lines, as plotted from information furnished by the operator, Charles K. Shaffer.

Irwin Buckwalter
Asst. Div. Draftsman
B. W. C. M. Co.