


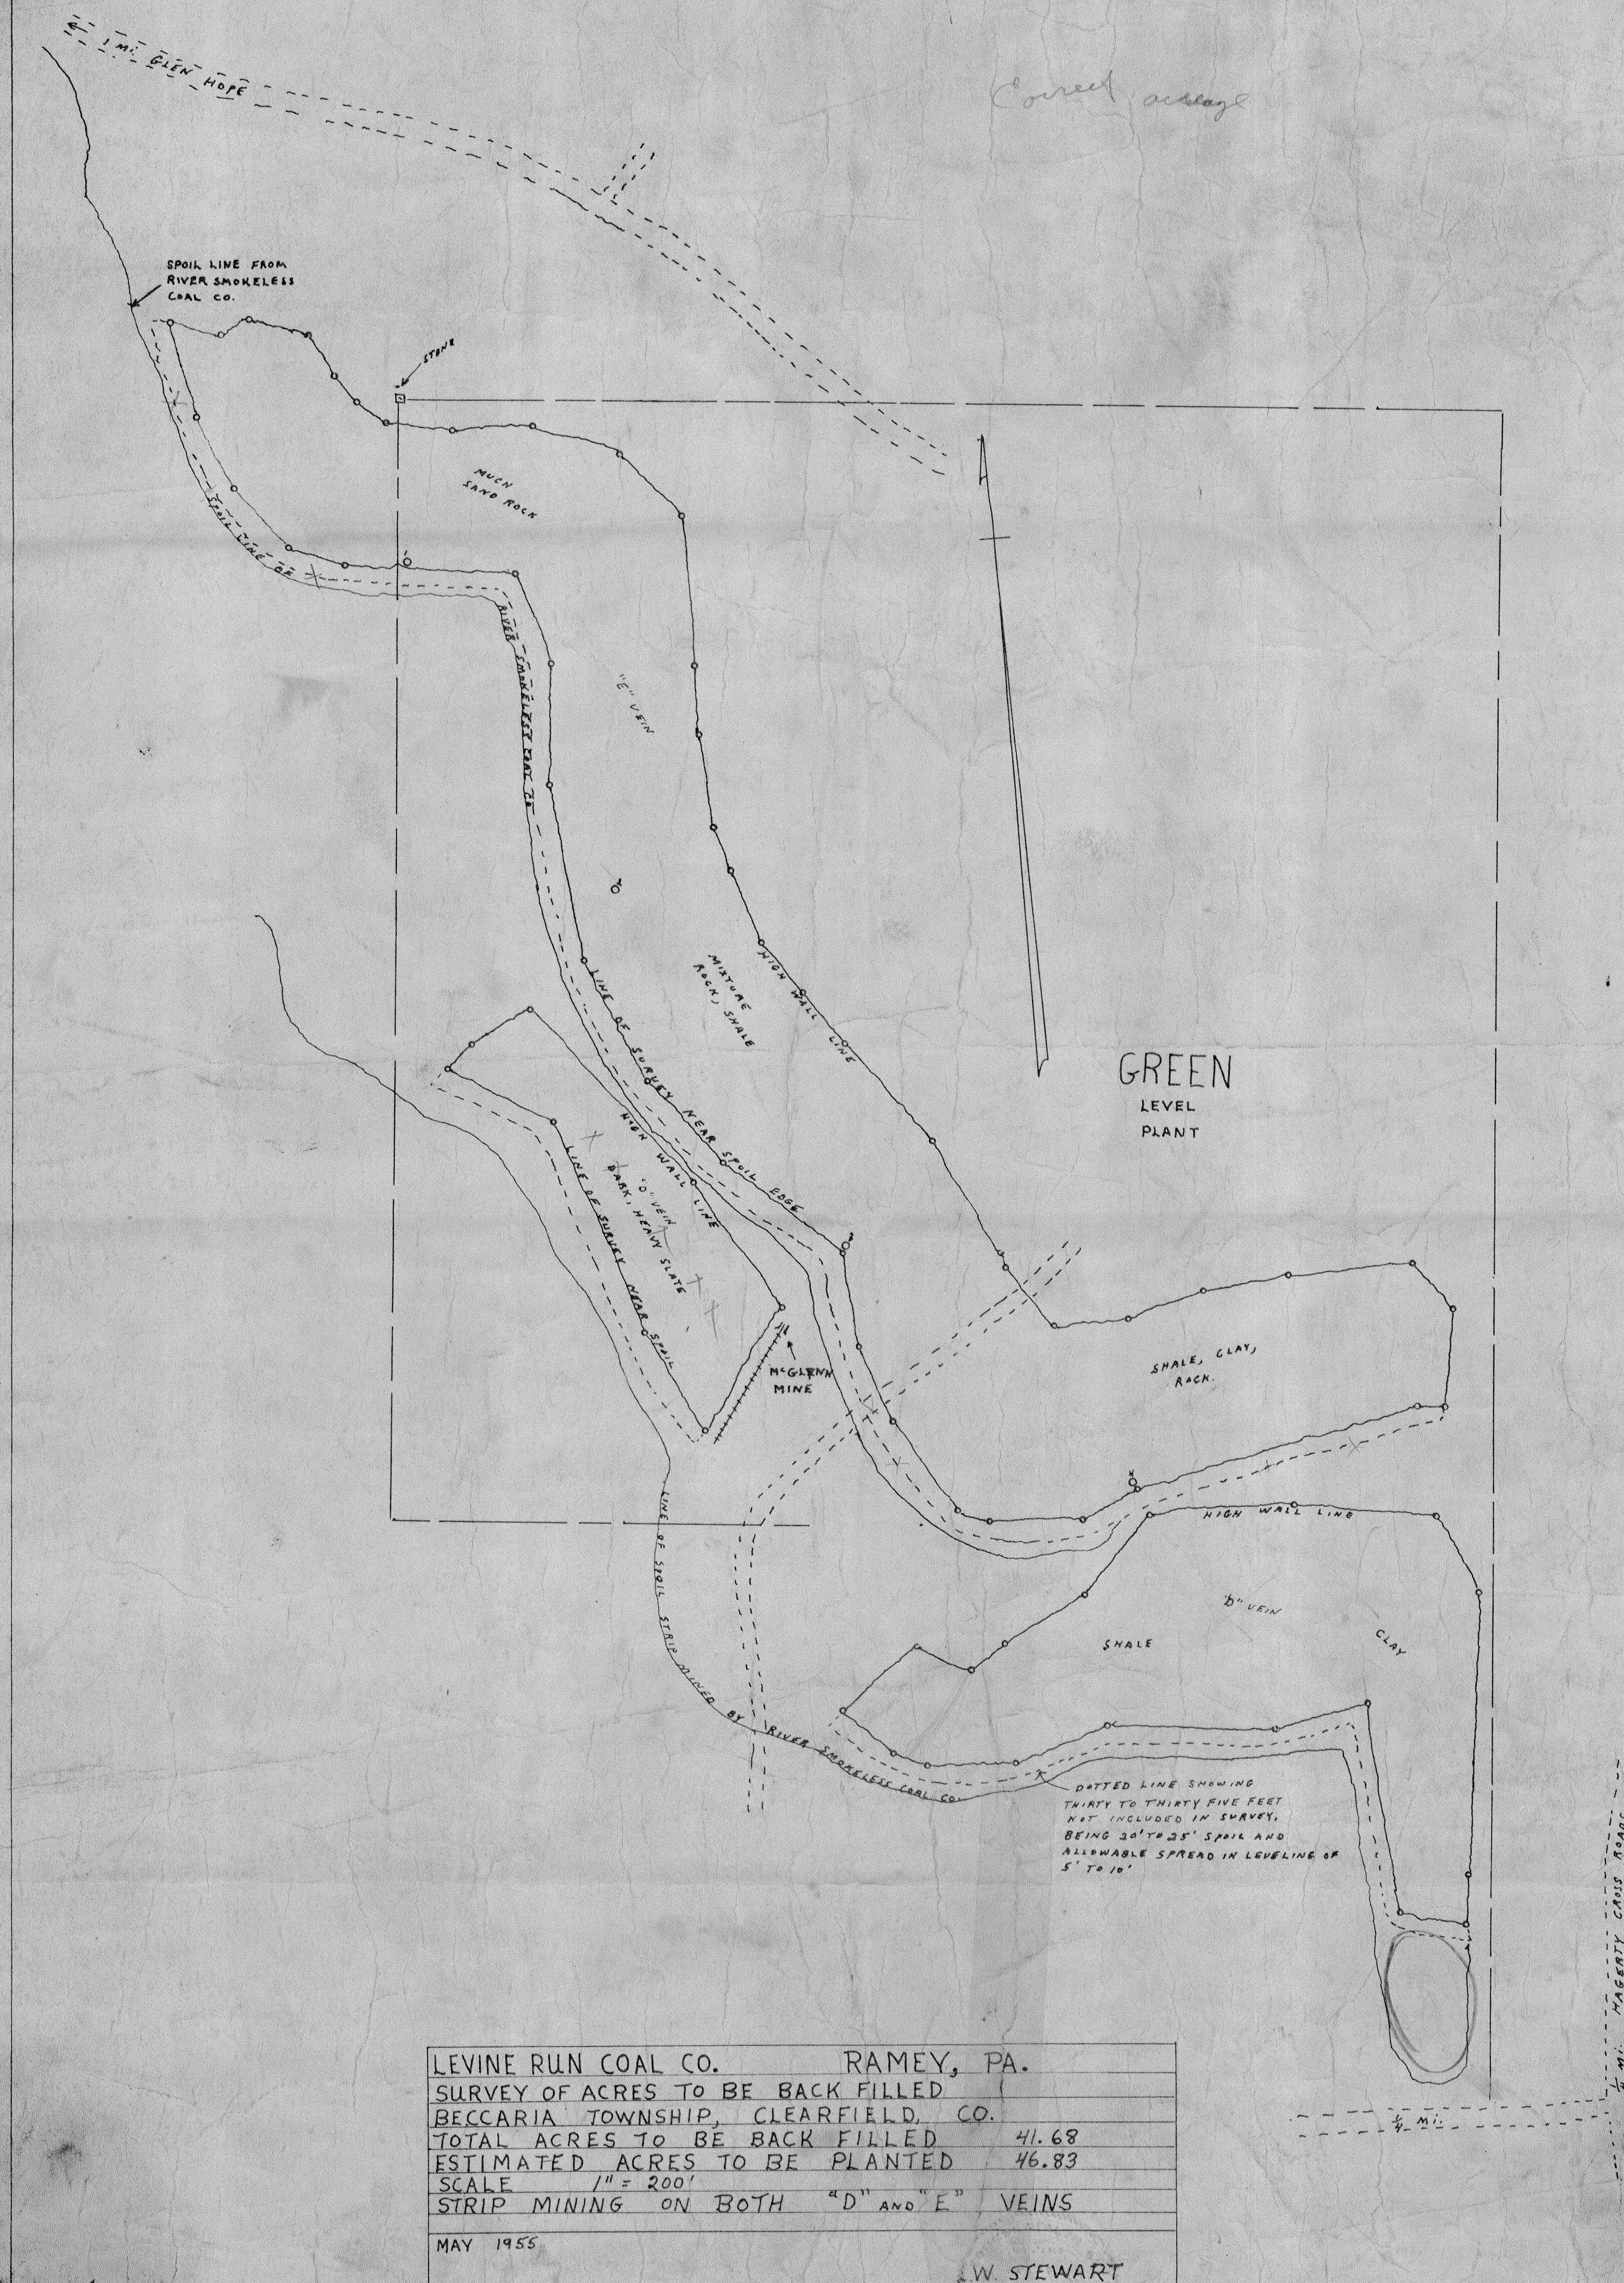

Ramey 7 1/2'
near SH 474