



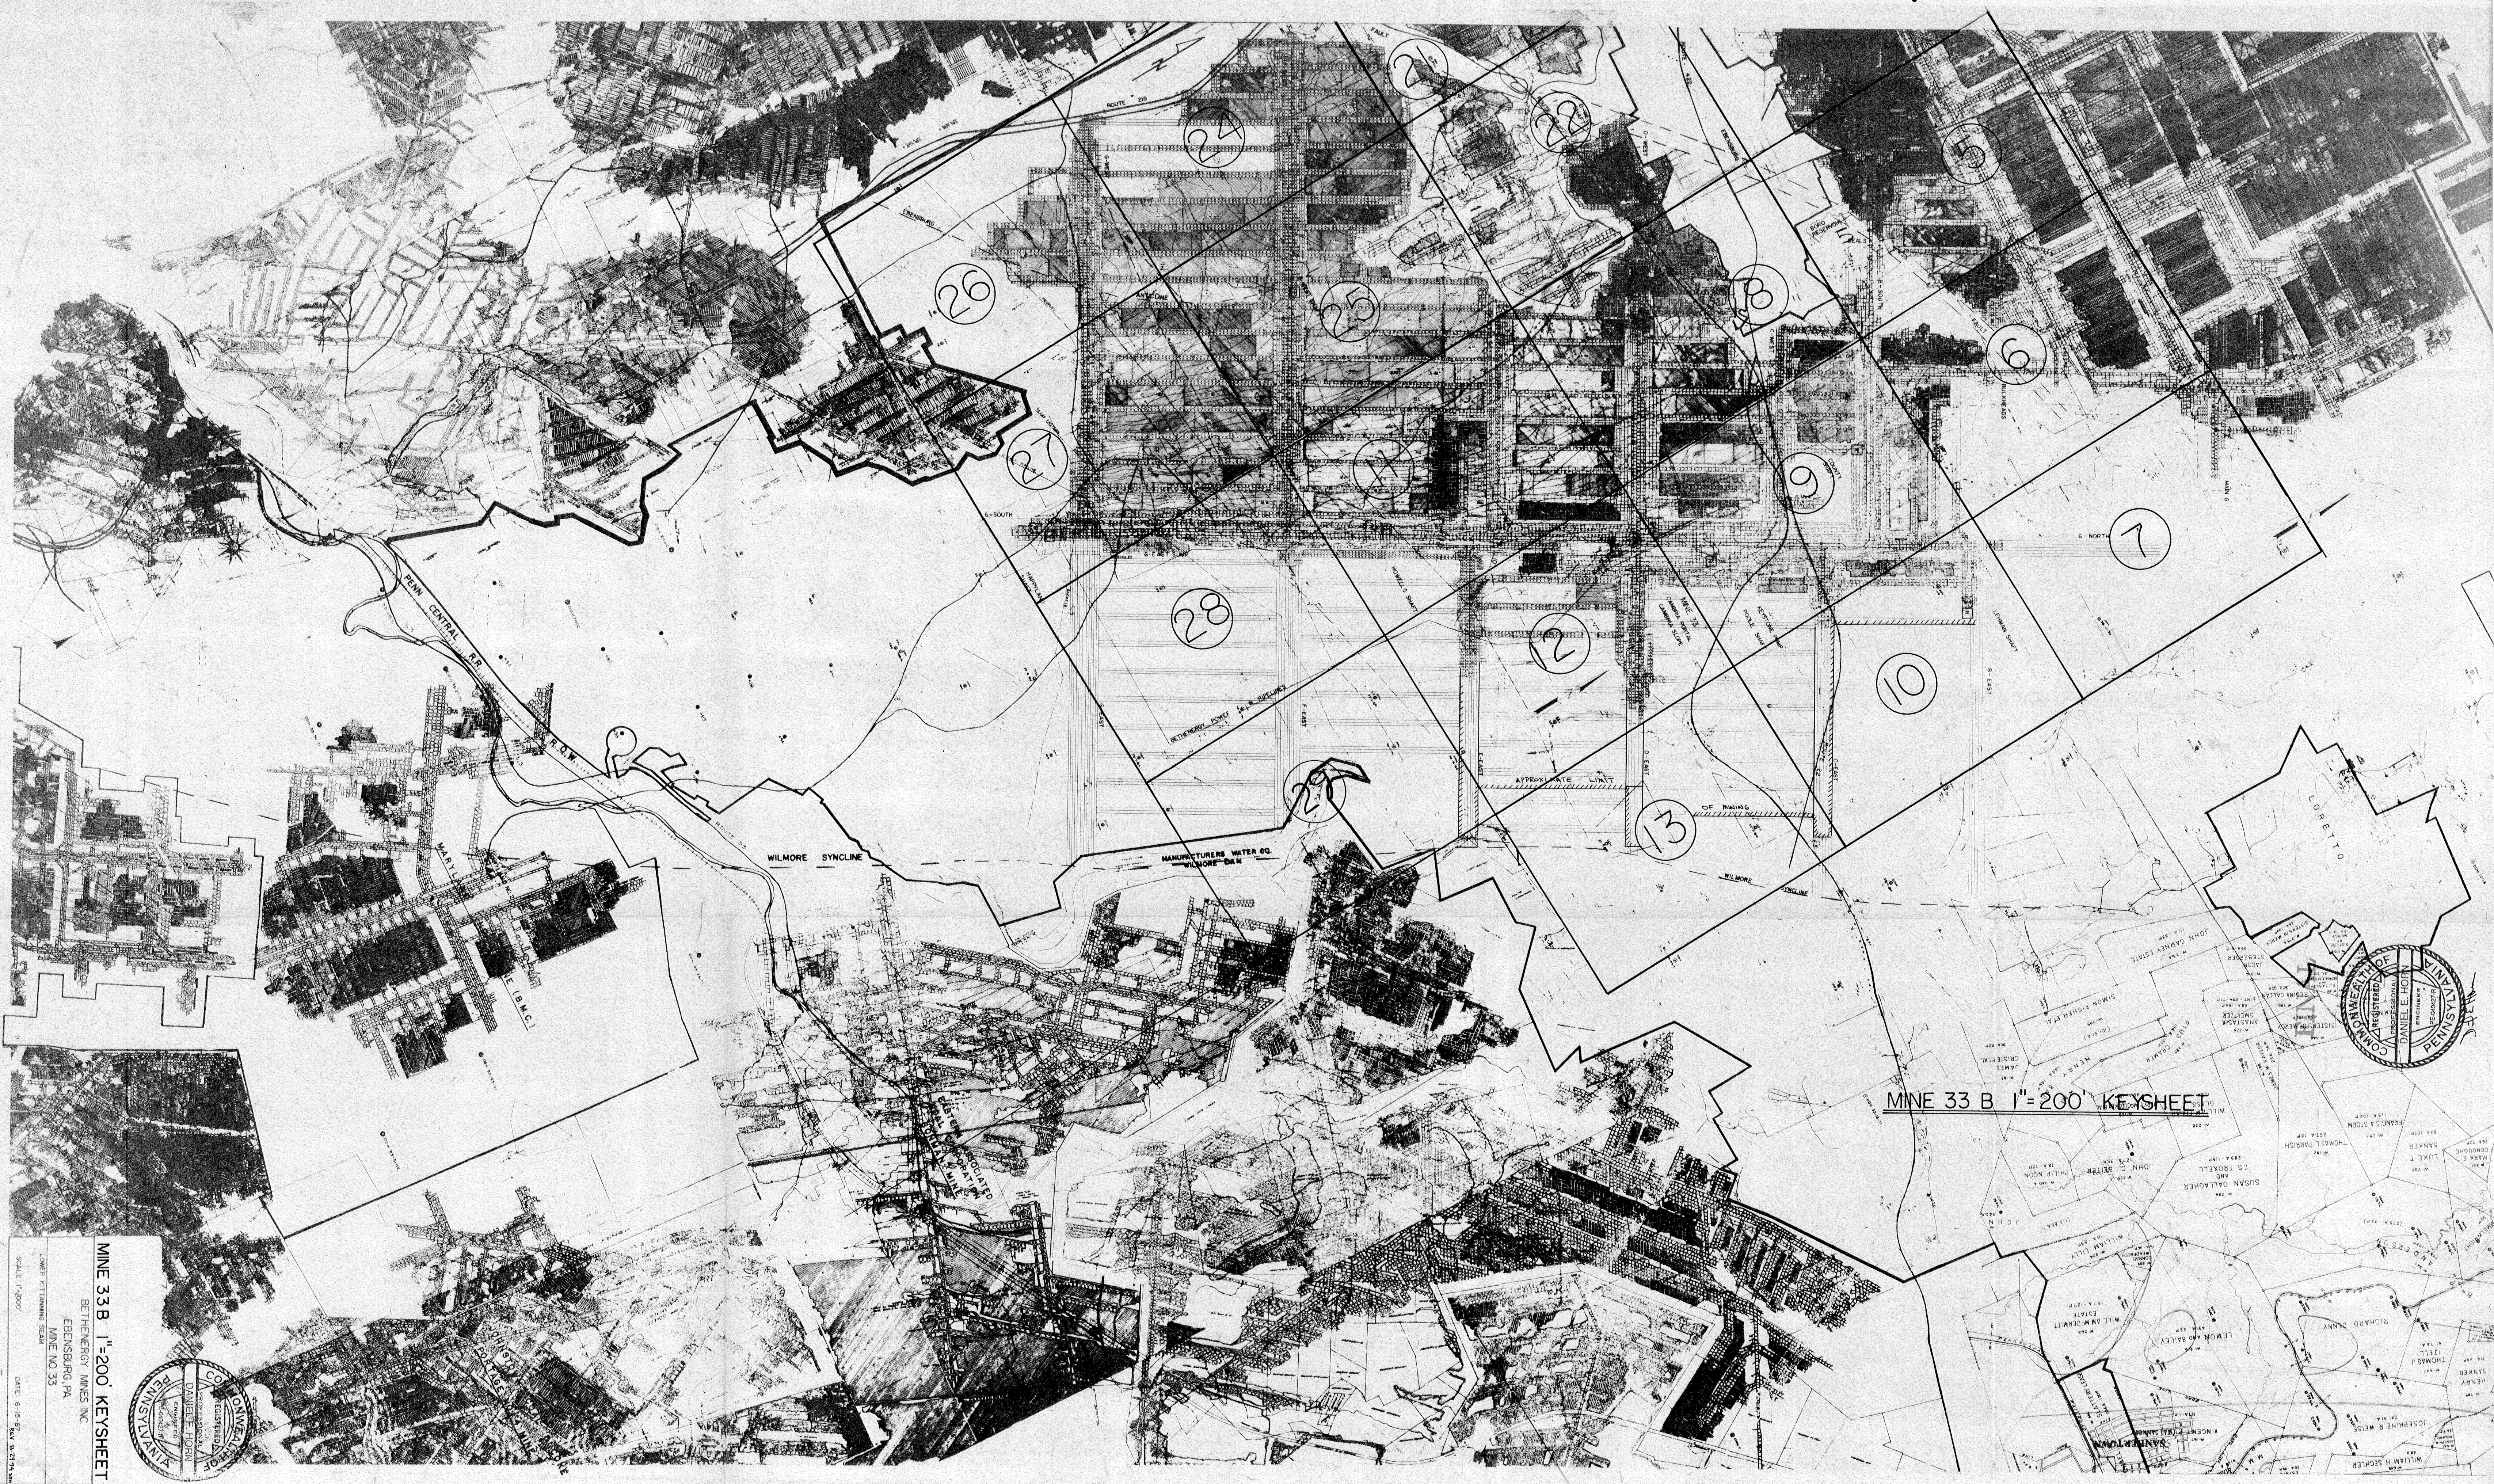

MINE 33 B 1"=200' KEYSHEET

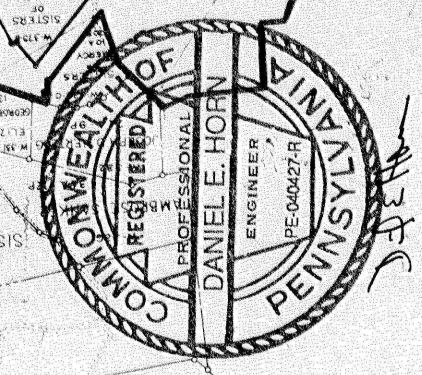

MINE 33 B 1"=200' KEYSHEET
Ebensburg, PA
MINE NO. 33
DATE: 6-1-87
REV. 9-27-88

