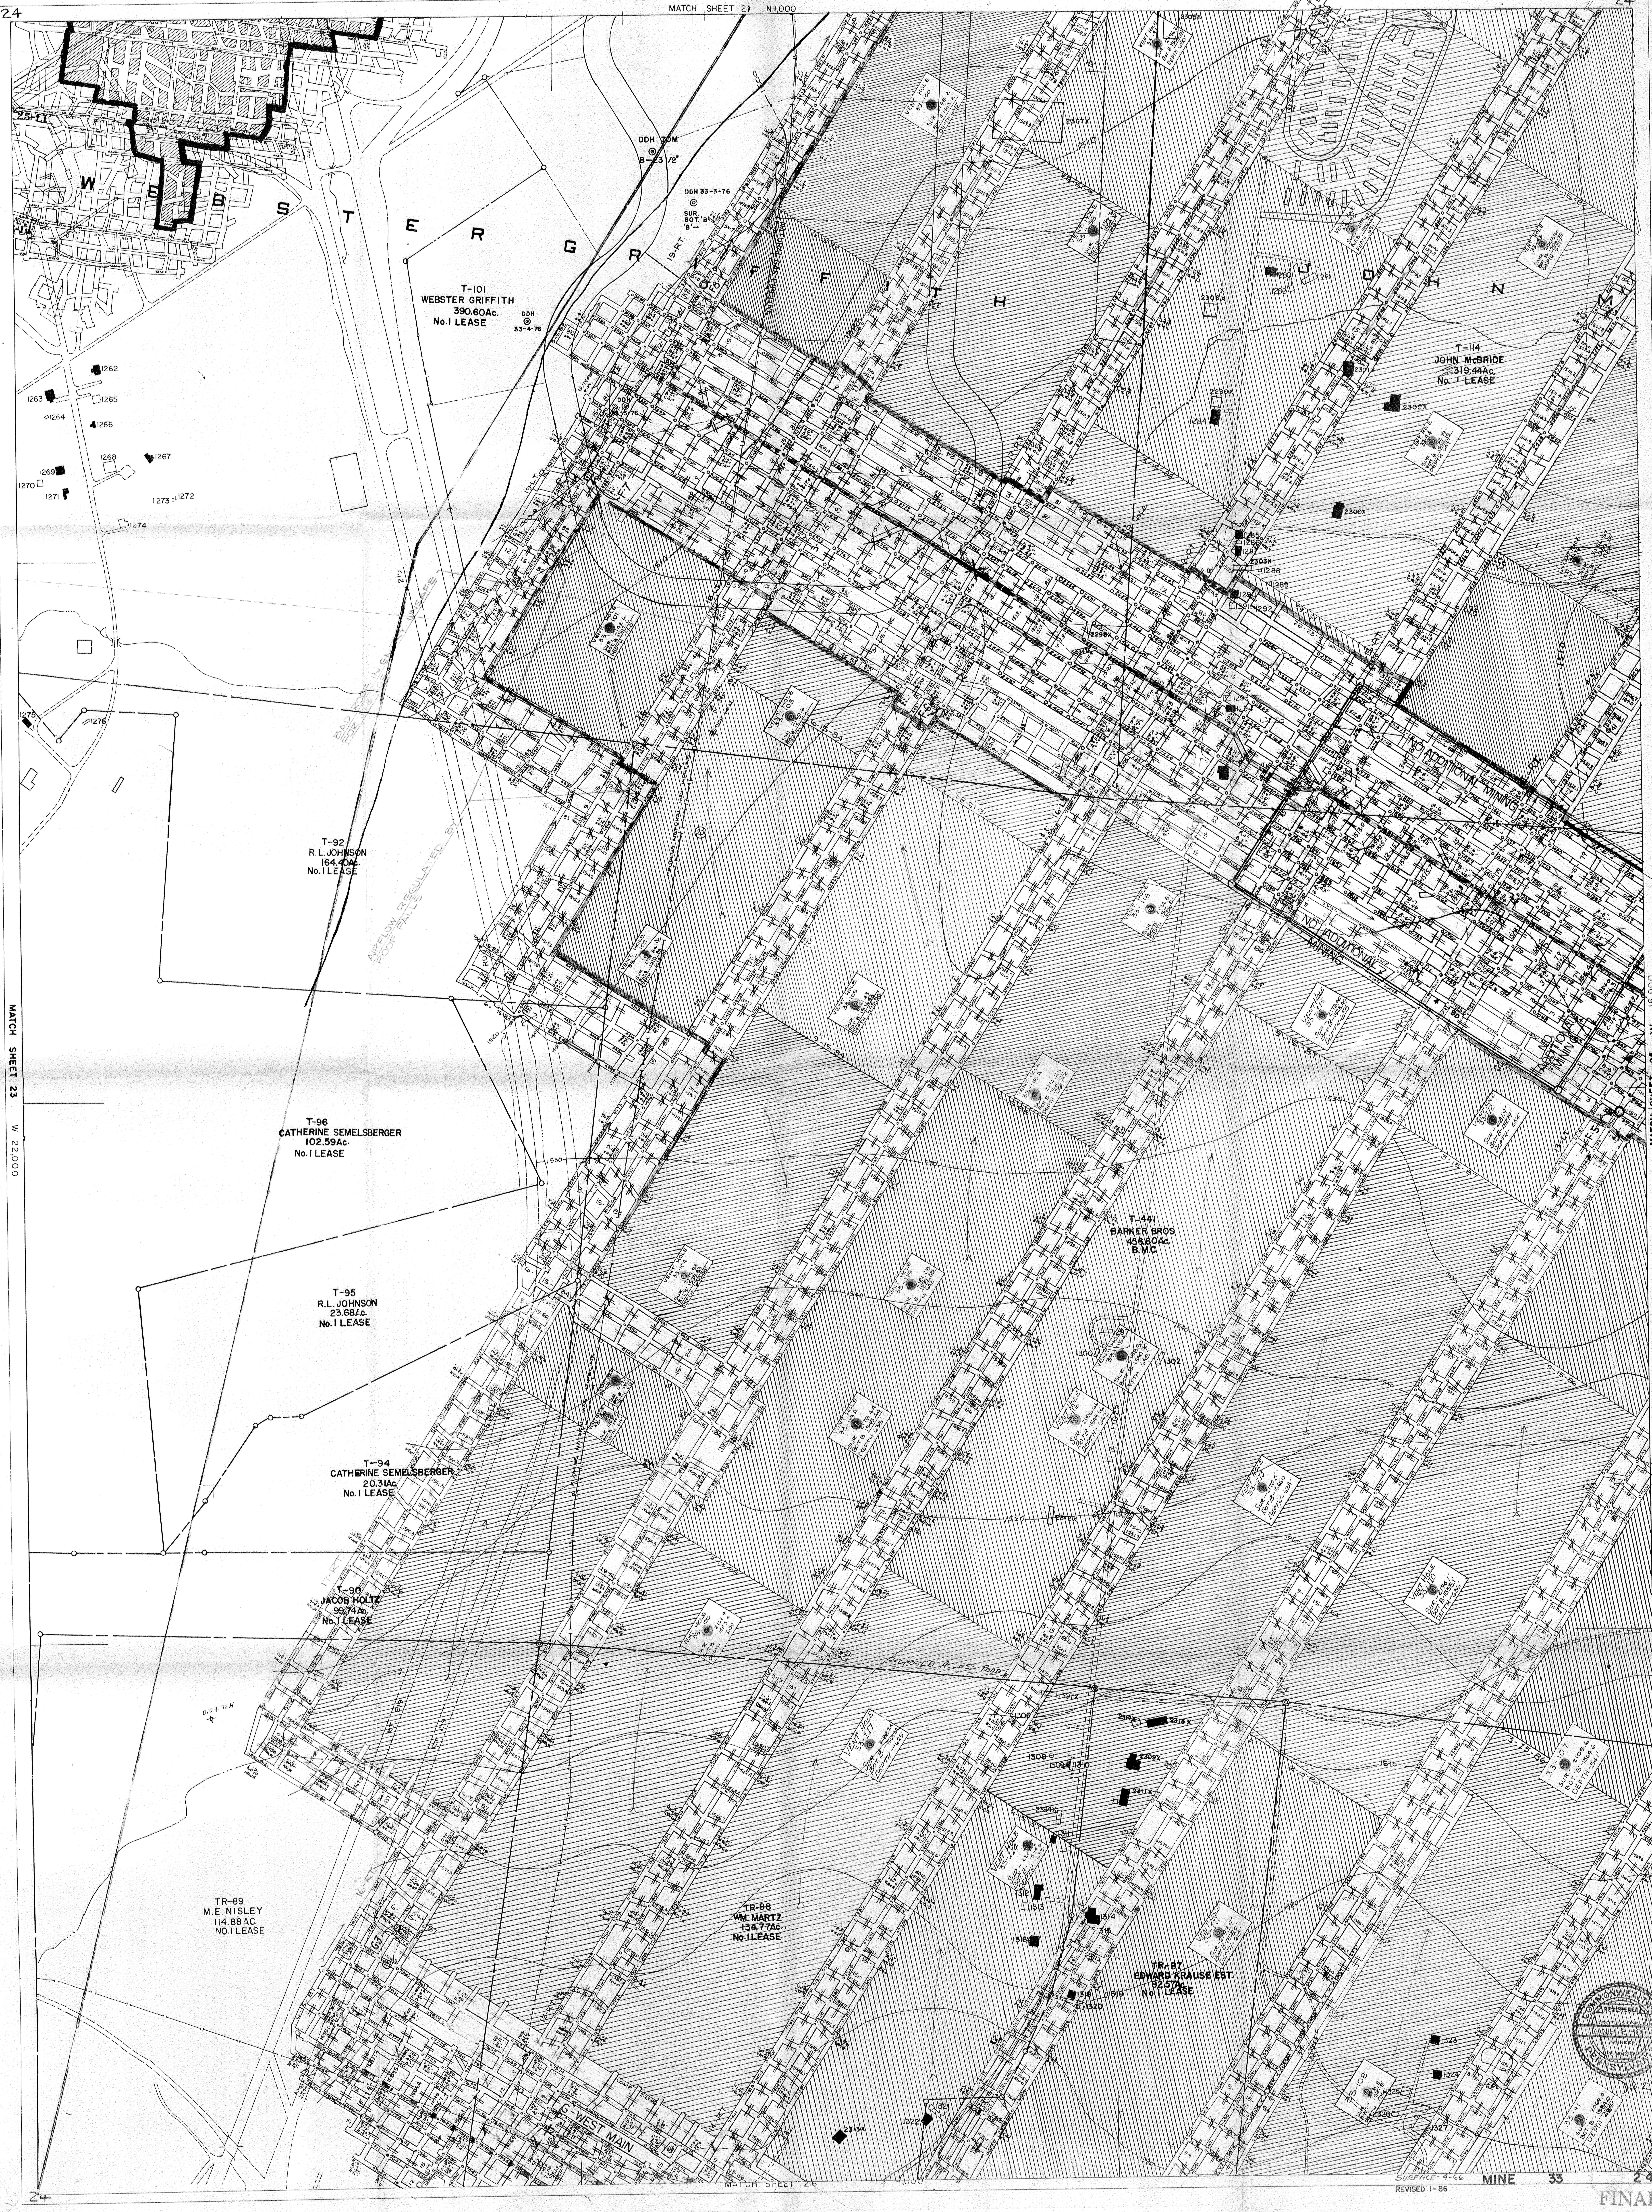

24
MATCH SHEET 21 N1,000
24
W E B S T E R G R I F F I T H
J O H N M
25-LT.
DDH ZOM B-23 1/2"
DDH 33-3-76 SUR. BOT. 'B' 'B'
T-101
WEBSTER GRIFFITH
390.60Ac.
No.1 LEASE
DDH 33-4-76
19-RT.
19-LT.
NATURAL GAS PIPELINE
VENT HOLE 33-100
VENT HOLE 33-98
VENT HOLE 33-101
VENT HOLE 33-103
2307X
2305X
2306X
2299X
2301X
2302X
2300X
2303X
2298X
1262
1263
1264
1265
1266
1267
1268
1269
1270
1271
1272
1273
1274
1275
1276
1280
1281
1282
1284
1285
1287
1288
1289
1290
1291
1292
T-114
JOHN McBRIDE
319.44Ac.
No. 1 LEASE
BAD ROOF IN ENTRY UNSAFE FOR TRAVEL
AIRFLOW REGULATED BY ROOF FALLS
PEOPLES NATURAL GAS PIPELINE
NO ADDITIONAL MINING
NO ADDITIONAL MINING
T-92
R.L. JOHNSON
164.40Ac.
No.1 LEASE
MATCH SHEET 23 W 22,000
T-96
CATHERINE SEMELSBERGER
102.59Ac.
No.1 LEASE
T-95
R.L. JOHNSON
23.68Ac.
No.1 LEASE
T-94
CATHERINE SEMELSBERGER
20.31Ac.
No.1 LEASE
T-90
JACOB HOLTZ
99.74Ac.
No.1 LEASE
MATCH SHEET 25 W 16,000
T-441
BARKER BROS
456.60Ac.
B.M.C.
VENT HOLE 33-105
VENT HOLE 33-118
VENT HOLE 33-118A
VENT HOLE 33-115
VENT HOLE 33-112
VENT HOLE 33-119
VENT HOLE 33-114
VENT HOLE 33-119A
VENT HOLE 33-116
VENT HOLE 33-113
VENT HOLE 33-110
VENT HOLE 33-120
VENT HOLE 33-117
VENT HOLE 33-124
VENT HOLE 33-121
33-107 SUR. 2105.6 BOT. B 1564.6 DEPTH 541'
33-108
33-91
1300
1302
2312X
PROPOSED ACCESS ROAD
1306
1307X
1308
1309
1310
1311
1312
1313
1314
1315
1316
1318
1319
1320
1321
1322
1323
1324
1325
1326
1327
2313X
2314X
2315X
2309X
2311X
2384X
D.D.H. 72 H
17-RT.
16-RT.
14-RT.
13-LT.
G-3
F-5
F-6
F-7
G-WEST MAIN
TR-89
M.E. NISLEY
114.88 AC.
No.1 LEASE
TR-88
WM. MARTZ
134.77Ac.
No.1 LEASE
TR-87
EDWARD KRAUSE EST.
82.57Ac.
No.1 LEASE
1530
1540
1550
1560
1570
1580
1590
MATCH SHEET 26 S 4,000
24

COMMONWEALTH OF PENNSYLVANIA
REGISTERED PROFESSIONAL ENGINEER
DANIEL E. HORN

D. E. Horn

SURFACE 4-66
REVISED 1-86

MINE 33 24

FINAL