


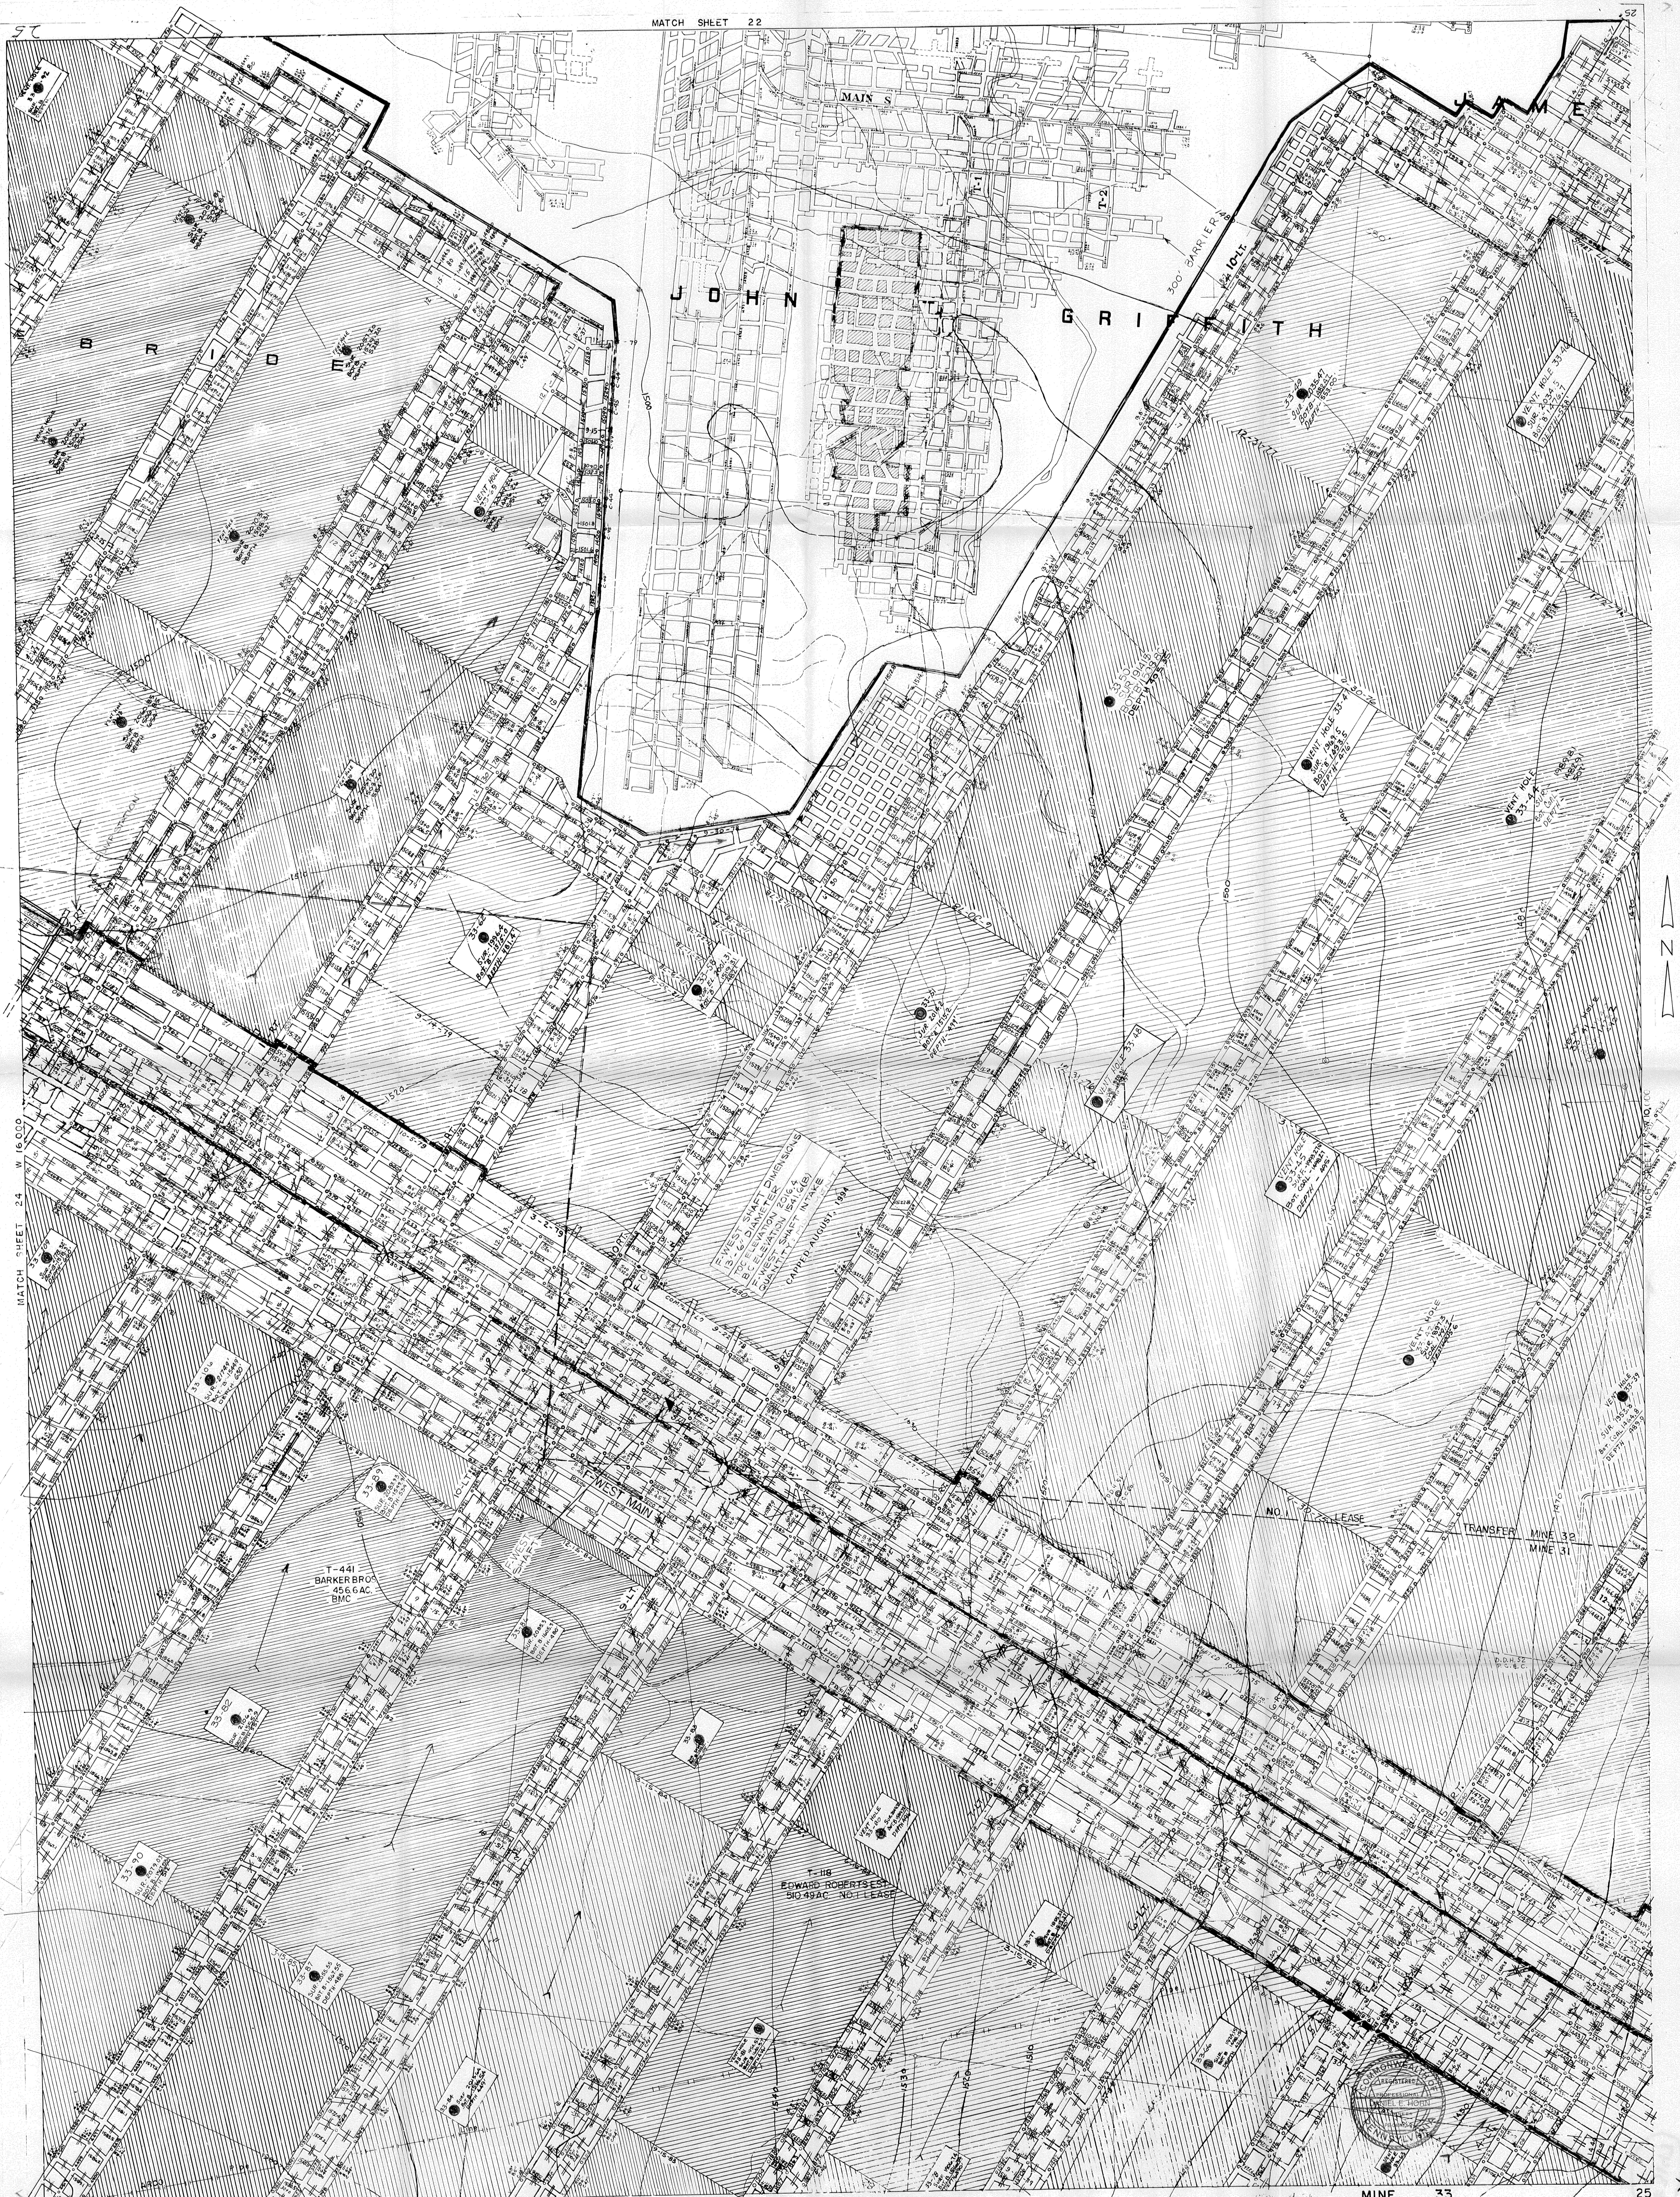

MATCH SHEET 24

MATCH SHEET 27

MINE 33

FINAL