


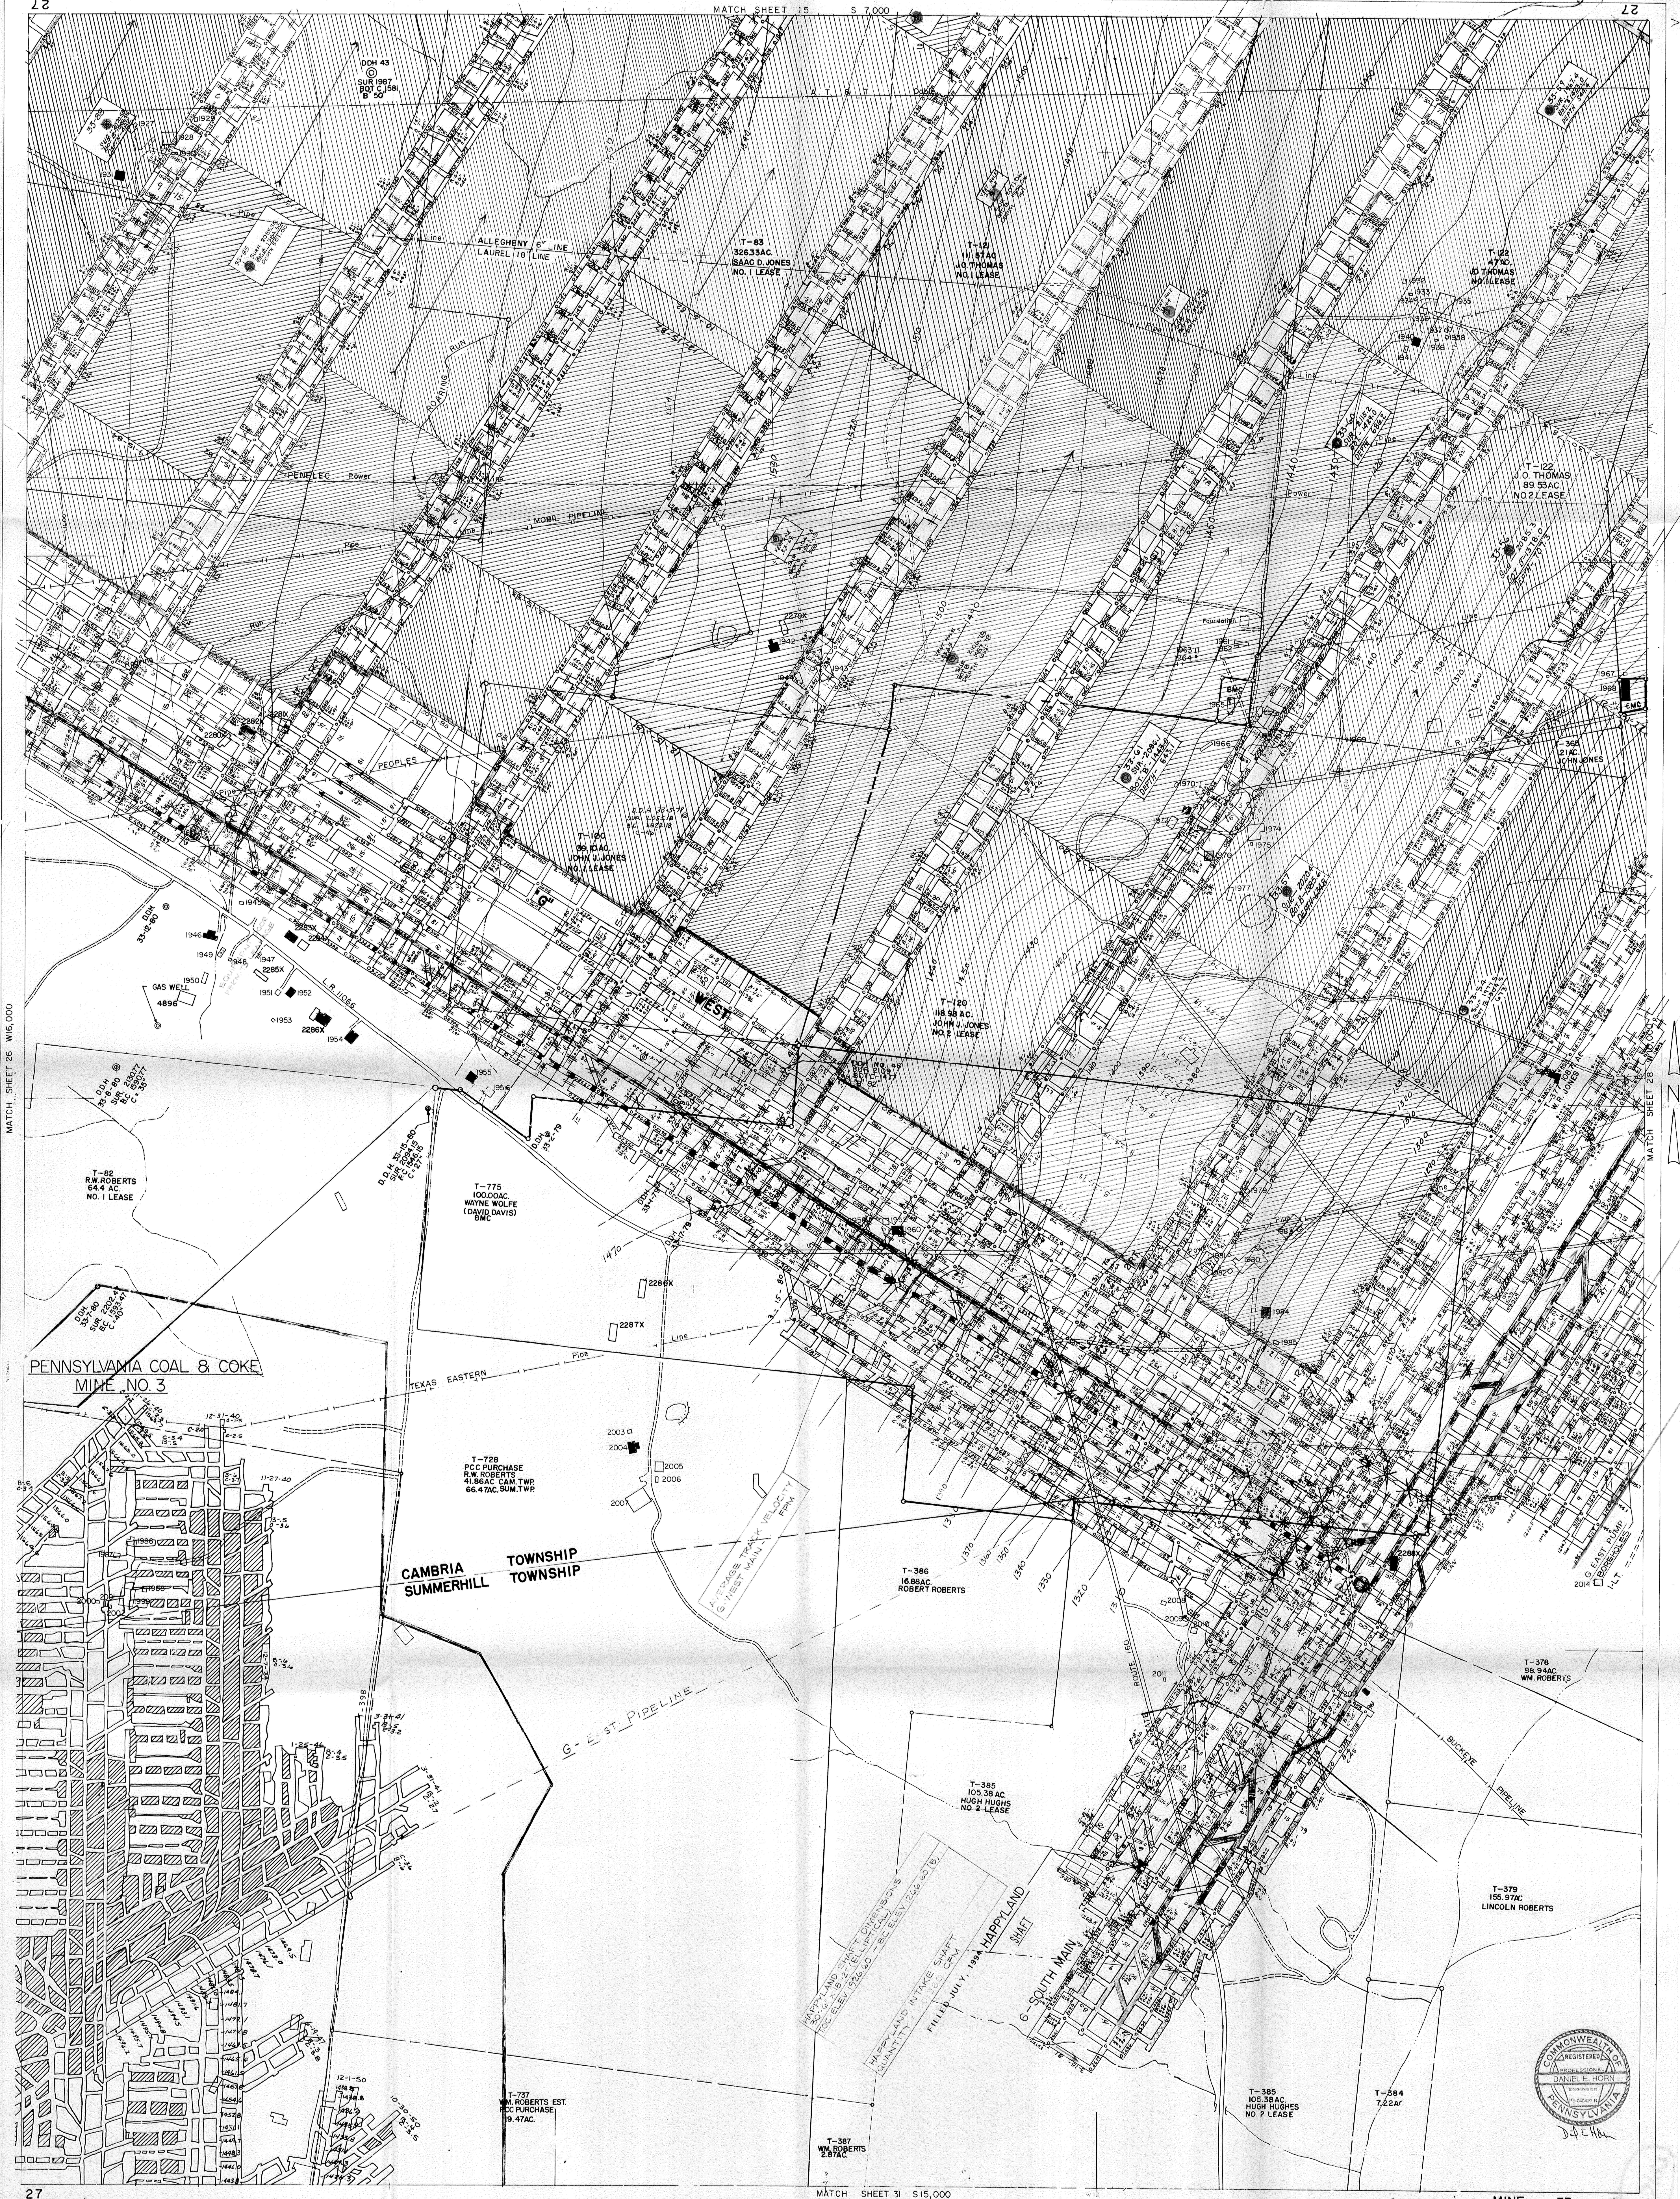

MATCH SHEET 26 W15,000

MATCH SHEET 28 W15,000

