


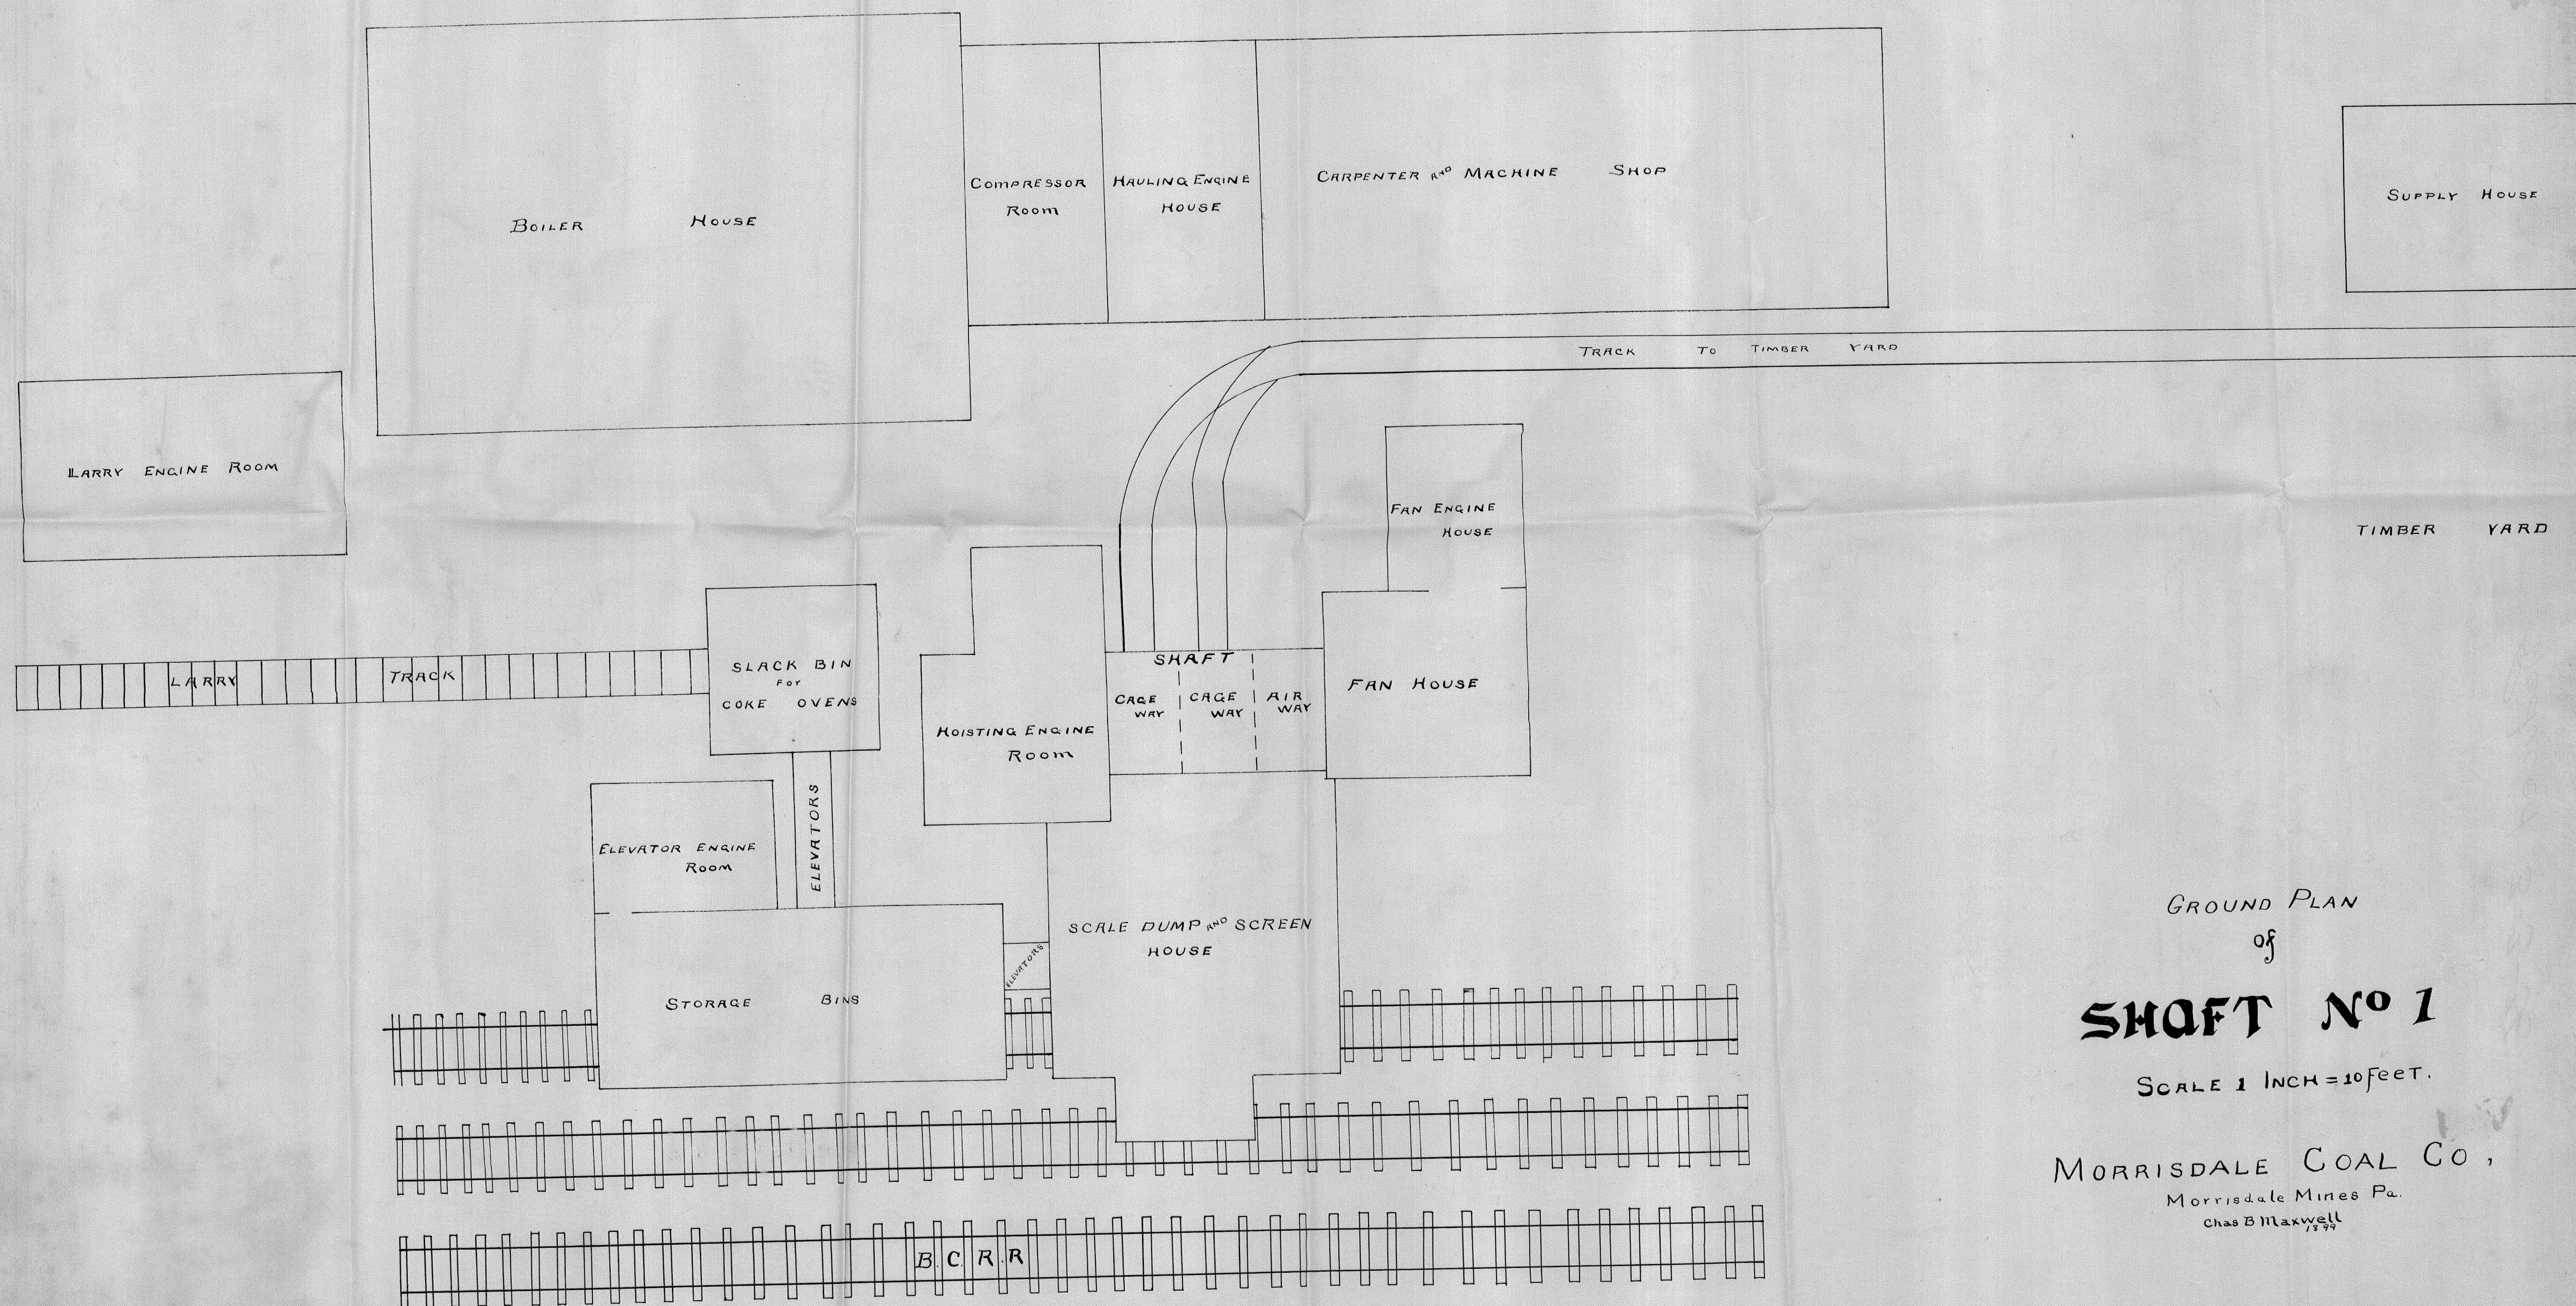

GROUND PLAN
of
SHAFT NO 1

SCALE 1 INCH = 10 FEET.

MORRISDALE COAL CO.,
Morrisdale Mines Pa.
Chas B Maxwell 1899

ALL THE ABOVE BUILDINGS WAS DESTROYED BY FIRE DEC. 15th 1899.