


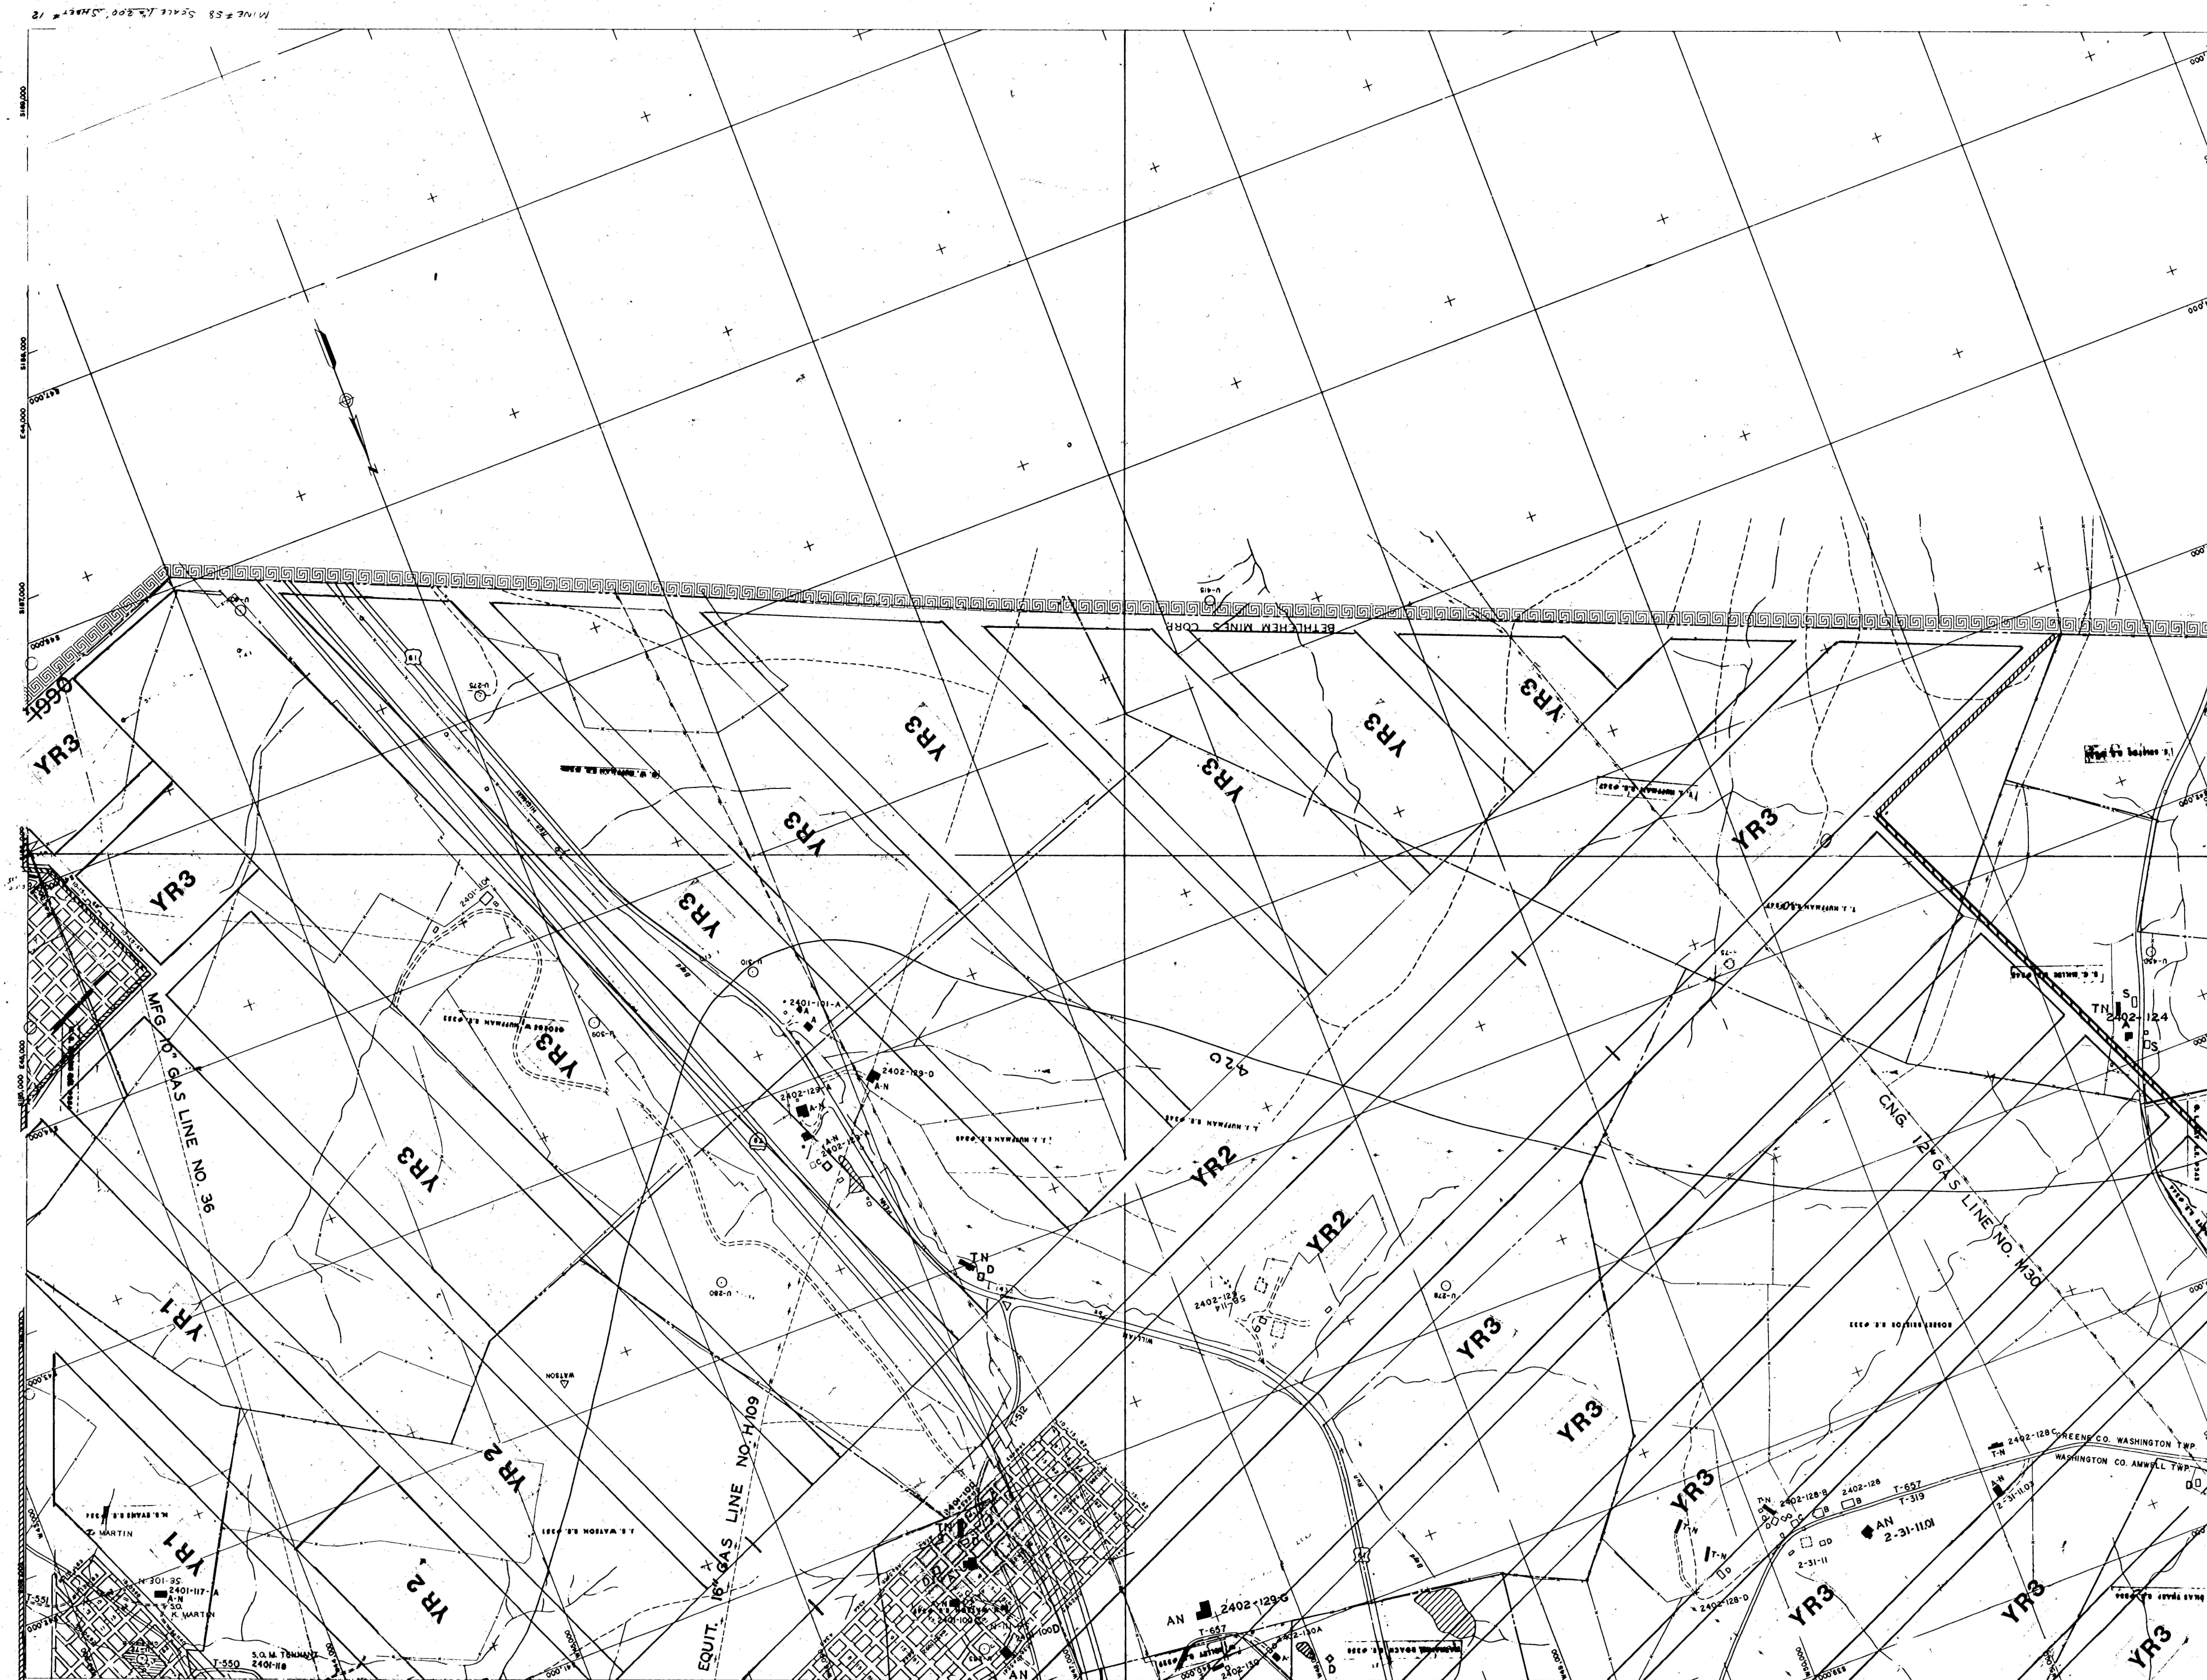

BETHENERGY MINES INC.
ELLSWORTH DIVISION
MINE NO. 58

WASHINGTON TWP. GREEN COUNTY
AMWELL TWP. WASHINGTON COUNTY

SCALE 1"=400' SURVEY DATE 3-7-88

PITTSBURGH COAL SEAM

LEGEND

- MINE BOUNDARY
- 5 YEAR PERMIT AREA & SUBSIDENCE CONTROL PLAN AREA
- A PRE 1966 HOUSE
- AN POST 1966 HOUSE
- T PRE 1966 TRAILER
- TN POST 1966 TRAILER
- B BARN
- C GARAGE
- D OUTBUILDING
- CB COMMERCIAL BUILDING
- PB PUBLIC BUILDING
- SUPPORT AREA
- PILLARS IN PLACE
- MAXIMUM ENTRY WIDTH
- GAS WELL
- GAS LINE

SEP 10 1991
Dept. of Environmental Resources
McMurray District Office

SHEET No 12