


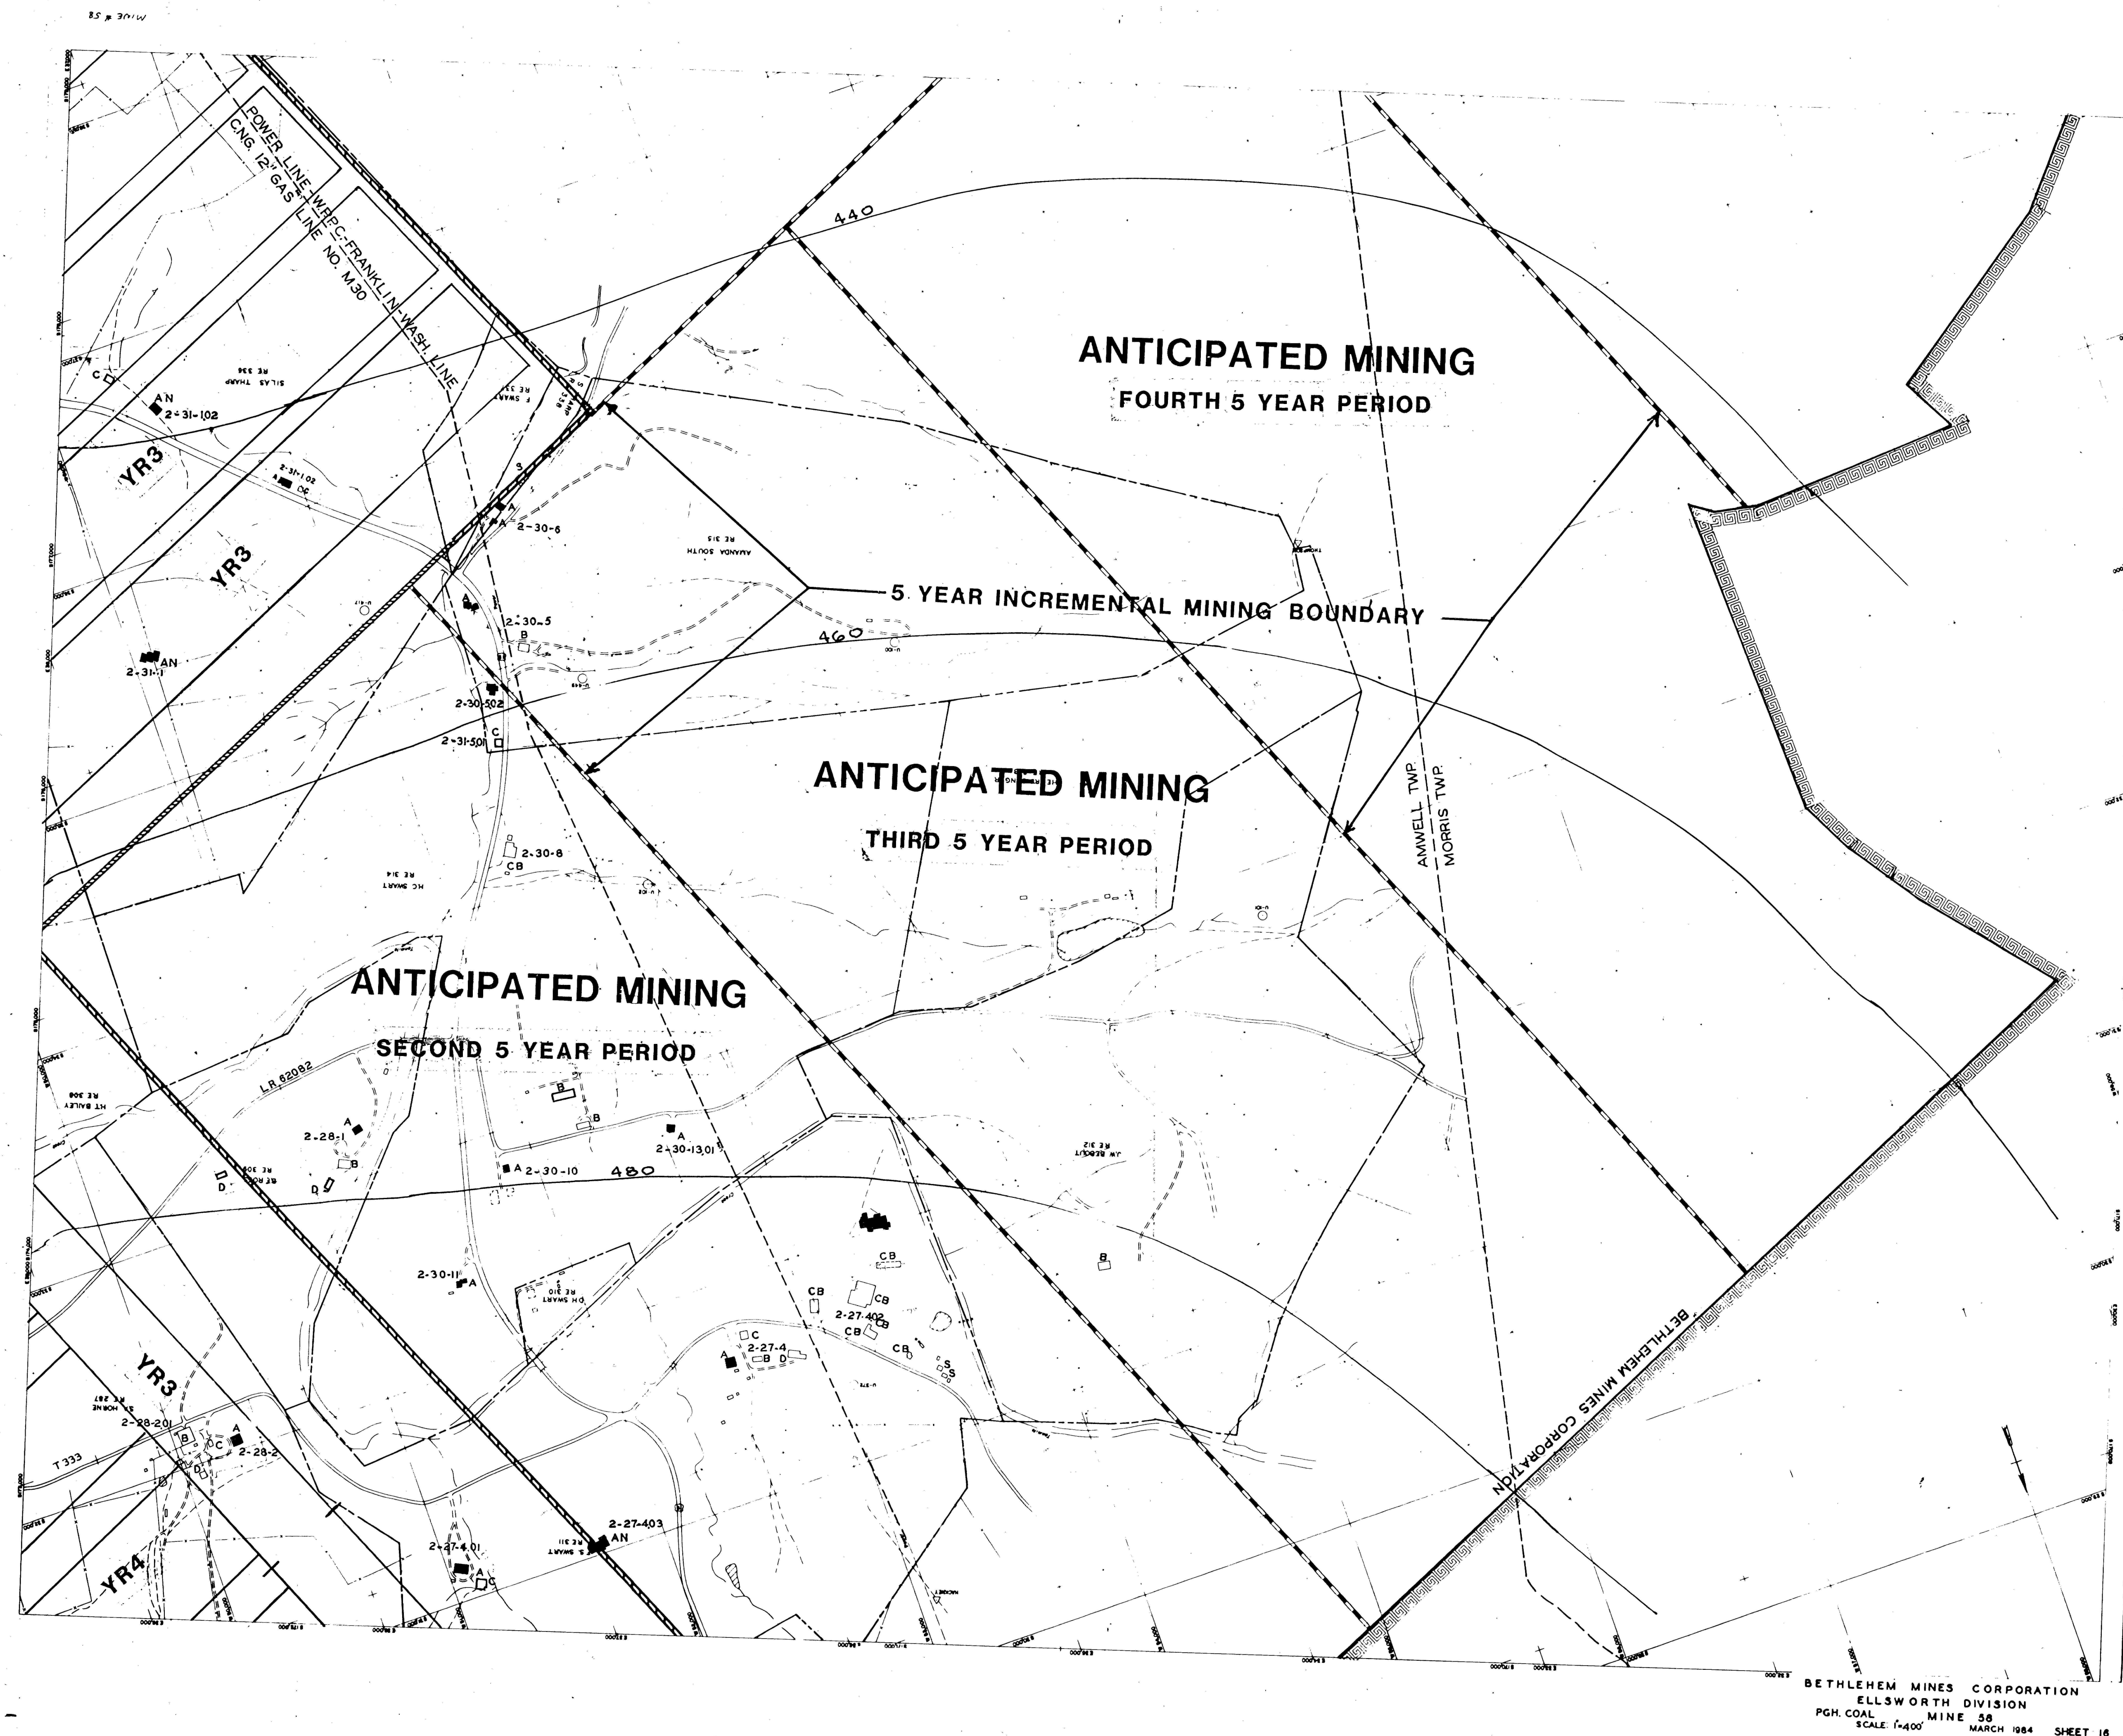

BETHENERGY MINES INC.
ELLSWORTH DIVISION
MINE NO. 58

AMWELL TWP.
MORRIS TWP.

WASHINGTON COUNTY
WASHINGTON COUNTY

SCALE 1"=400' SURVEY DATE 3-7-88

PITTSBURGH COAL SEAM

=LEGEND=

MINE BOUNDARY

5 YEAR PERMIT AREA & SUBSIDENCE CONTROL PLAN AREA

A PRE 1966 HOUSE

AN POST 1966 HOUSE

T PRE 1966 TRAILER

TN POST 1966 TRAILER

B BARN

C GARAGE

D OUTBUILDING

CB COMMERCIAL BUILDING

PB PUBLIC BUILDING

SUPPORT AREA

PILLARS IN PLACE

MAXIMUM ENTRY WIDTH 18"

GAS WELL

GAS LINE

SEP 10 1991

Dept. of Environmental Resources
McMurray District Office

BETHLEHEM MINES CORPORATION
ELLSWORTH DIVISION
PGH. COAL MINE 58
SCALE 1"=400' MARCH 1984 SHEET 16

SHEET No 16