


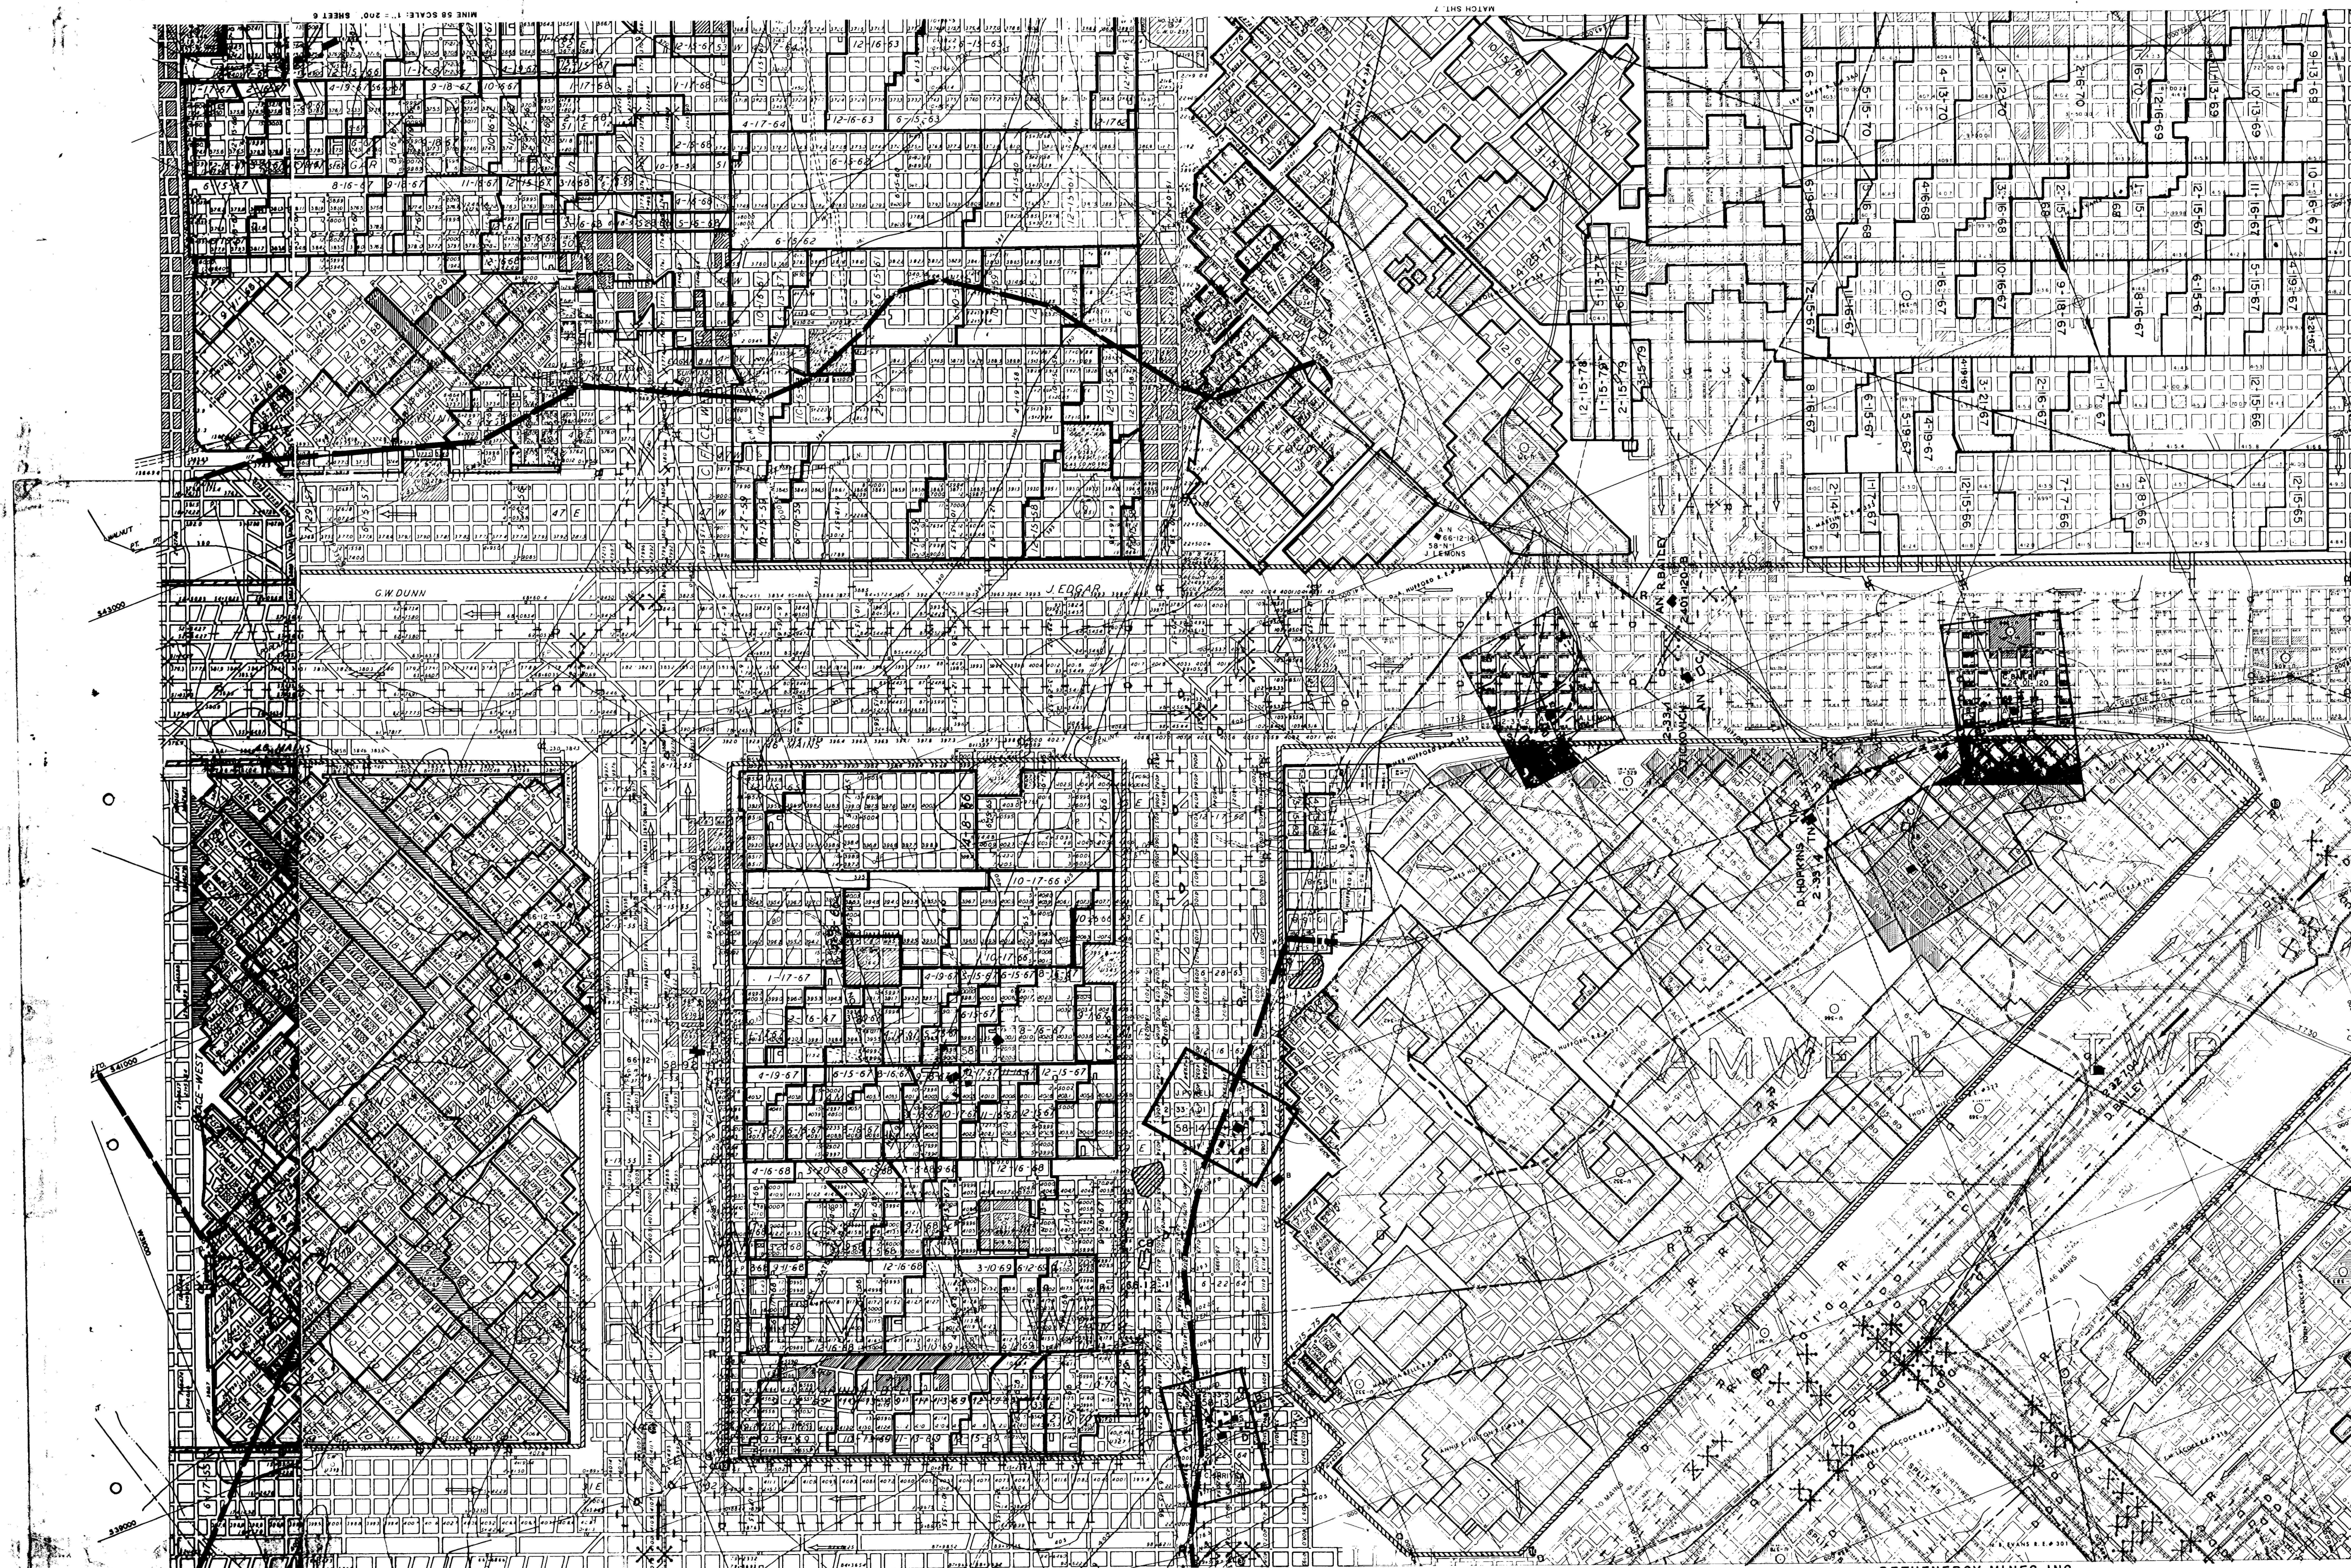

**BETHENERGY MINES INC.
ELLSWORTH DIVISION
MINE NO. 58**

AMWELL TWP. WASHINGTON COUNTY
WEST BETHLEHEM TWP. WASHINGTON COUNTY
WASHINGTON TWP. GREEN COUNTY
SCALE 1"=400' SURVEY DATE 3-7-88


PITTSBURGH COAL SEAM

= LEGEND =

- MINE BOUNDARY
- 5 YEAR PERMIT AREA & SUBSIDENCE CONTROL PLAN AREA
- A PRE 1966 HOUSE
- AN POST 1966 HOUSE
- T PRE 1966 TRAILER
- TN POST 1966 TRAILER
- B BARN
- C GARAGE
- D OUTBUILDING
- CB COMMERCIAL BUILDING
- PB PUBLIC BUILDING
- SUPPORT AREA
- PILLARS IN PLACE
- MAXIMUM ENTRY WIDTH 18'
- GAS WELL
- GAS LINE

SEP 10 1991

Dept. of Environmental Resources
McMurray District Office

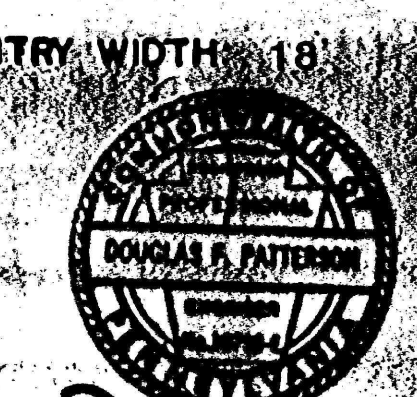

BETHENERGY MINES INC.
ELLSWORTH DIVISION
PGH. COAL MINE 58
SCALE: 1"=400' NOV. 1987

SHEET 6

SHEET No 6