


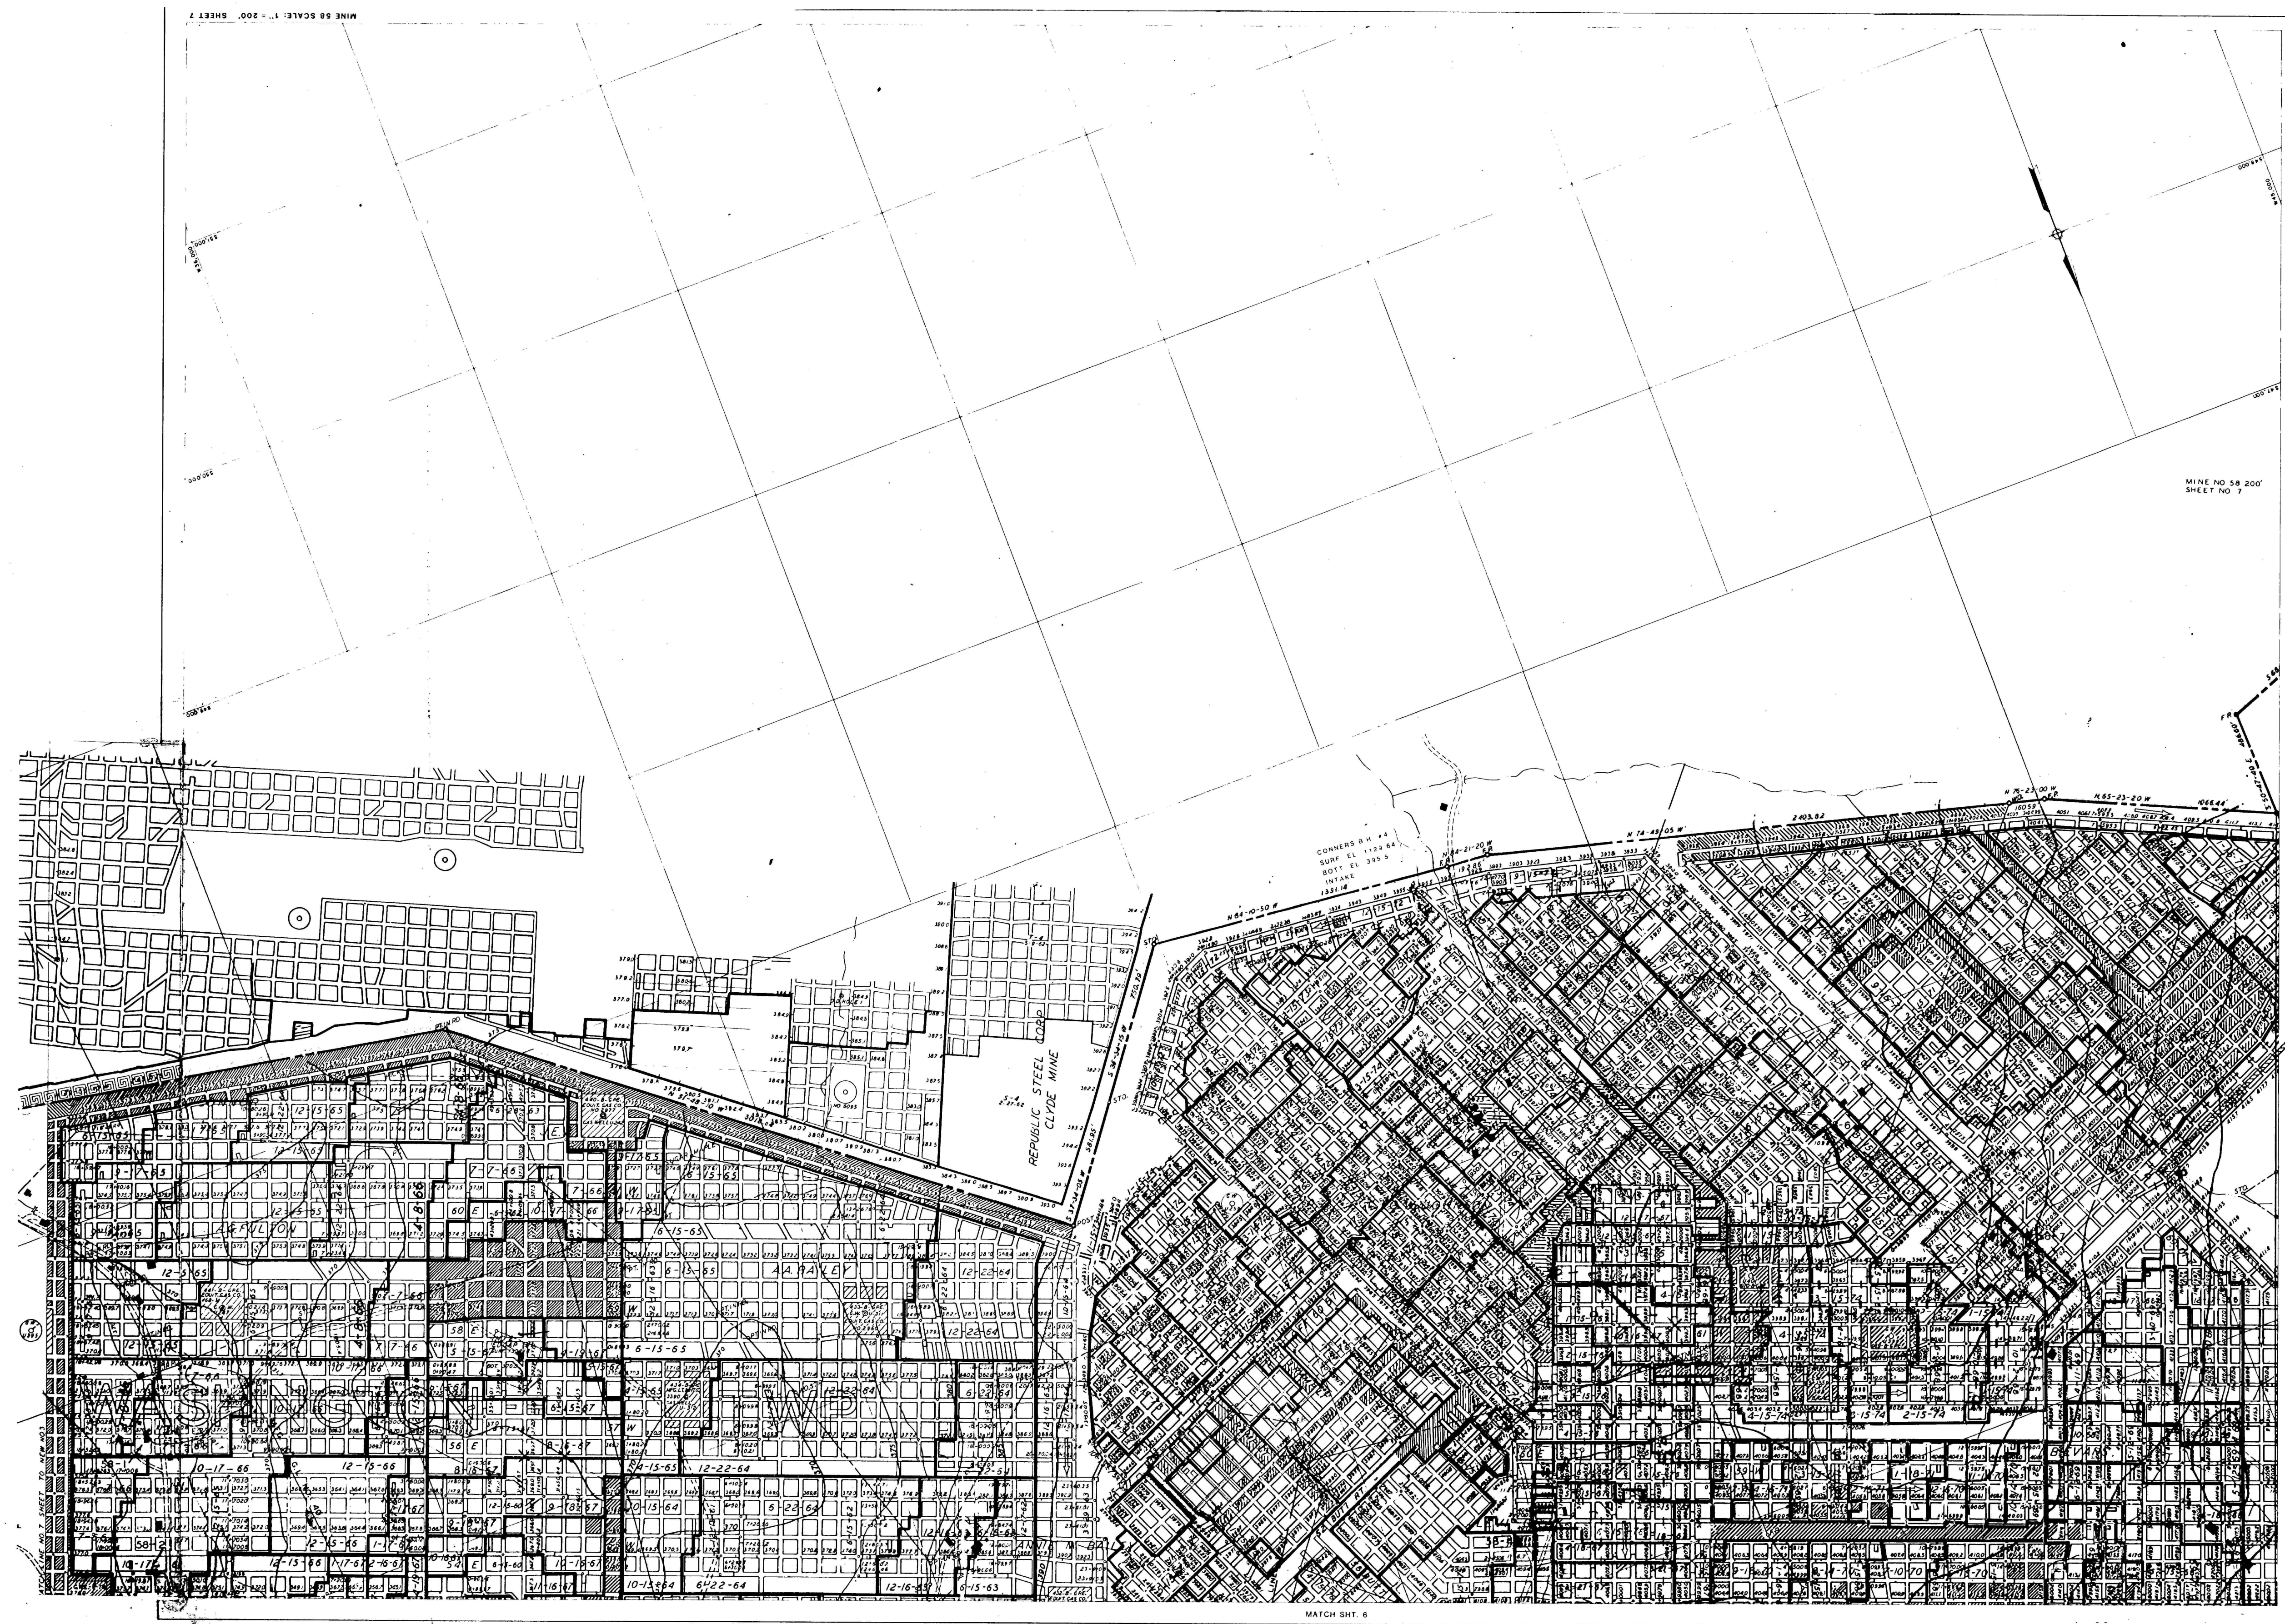

BETHENERGY MINES INC.
 ELLSWORTH DIVISION
 PGH. COAL MINE 58
 SCALE: 1"=400' NOV. 1987

SHEET 7

BETHENERGY MINES INC.
 ELLSWORTH DIVISION
 MINE NO. 58

WEST BETHLEHEM TWP. WASHINGTON COUNTY
 WASHINGTON TWP. GREEN COUNTY

SCALE 1"=400' SURVEY DATE 3-7-88


PITTSBURGH COAL SEAM

LEGEND

- MINE BOUNDARY
- 5 YEAR PERMIT AREA & SUBSIDENCE CONTROL PLAN AREA
- A PRE 1966 HOUSE
- AN POST 1966 HOUSE
- T PRE 1966 TRAILER
- TN POST 1966 TRAILER
- B BARN
- C GARAGE
- D OUTBUILDING
- CB COMMERCIAL BUILDING
- PB PUBLIC BUILDING
- SUPPORT AREA
- PILLARS IN PLACE
- MAXIMUM ENTRY WIDTH
- GAS WELL
- GAS LINE

RESERVED
 SEP 10 1991

Dept. of Environmental Resources
 Murray District Office

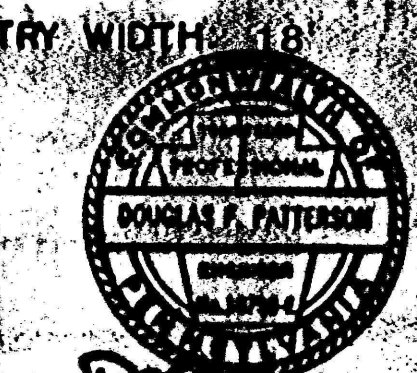

SHEET No 7