

MAP OF WAVERLY MINE

OF S. J. MOUNTZ & CO.

in Gulick Township, Clearfield County, Pa.


H. S. Shillingford,

Mining Engineer.

Scale 1"=100'

Original filed June 7-1920

CHRISTIAN STAKE
KILLANING COAL CO.

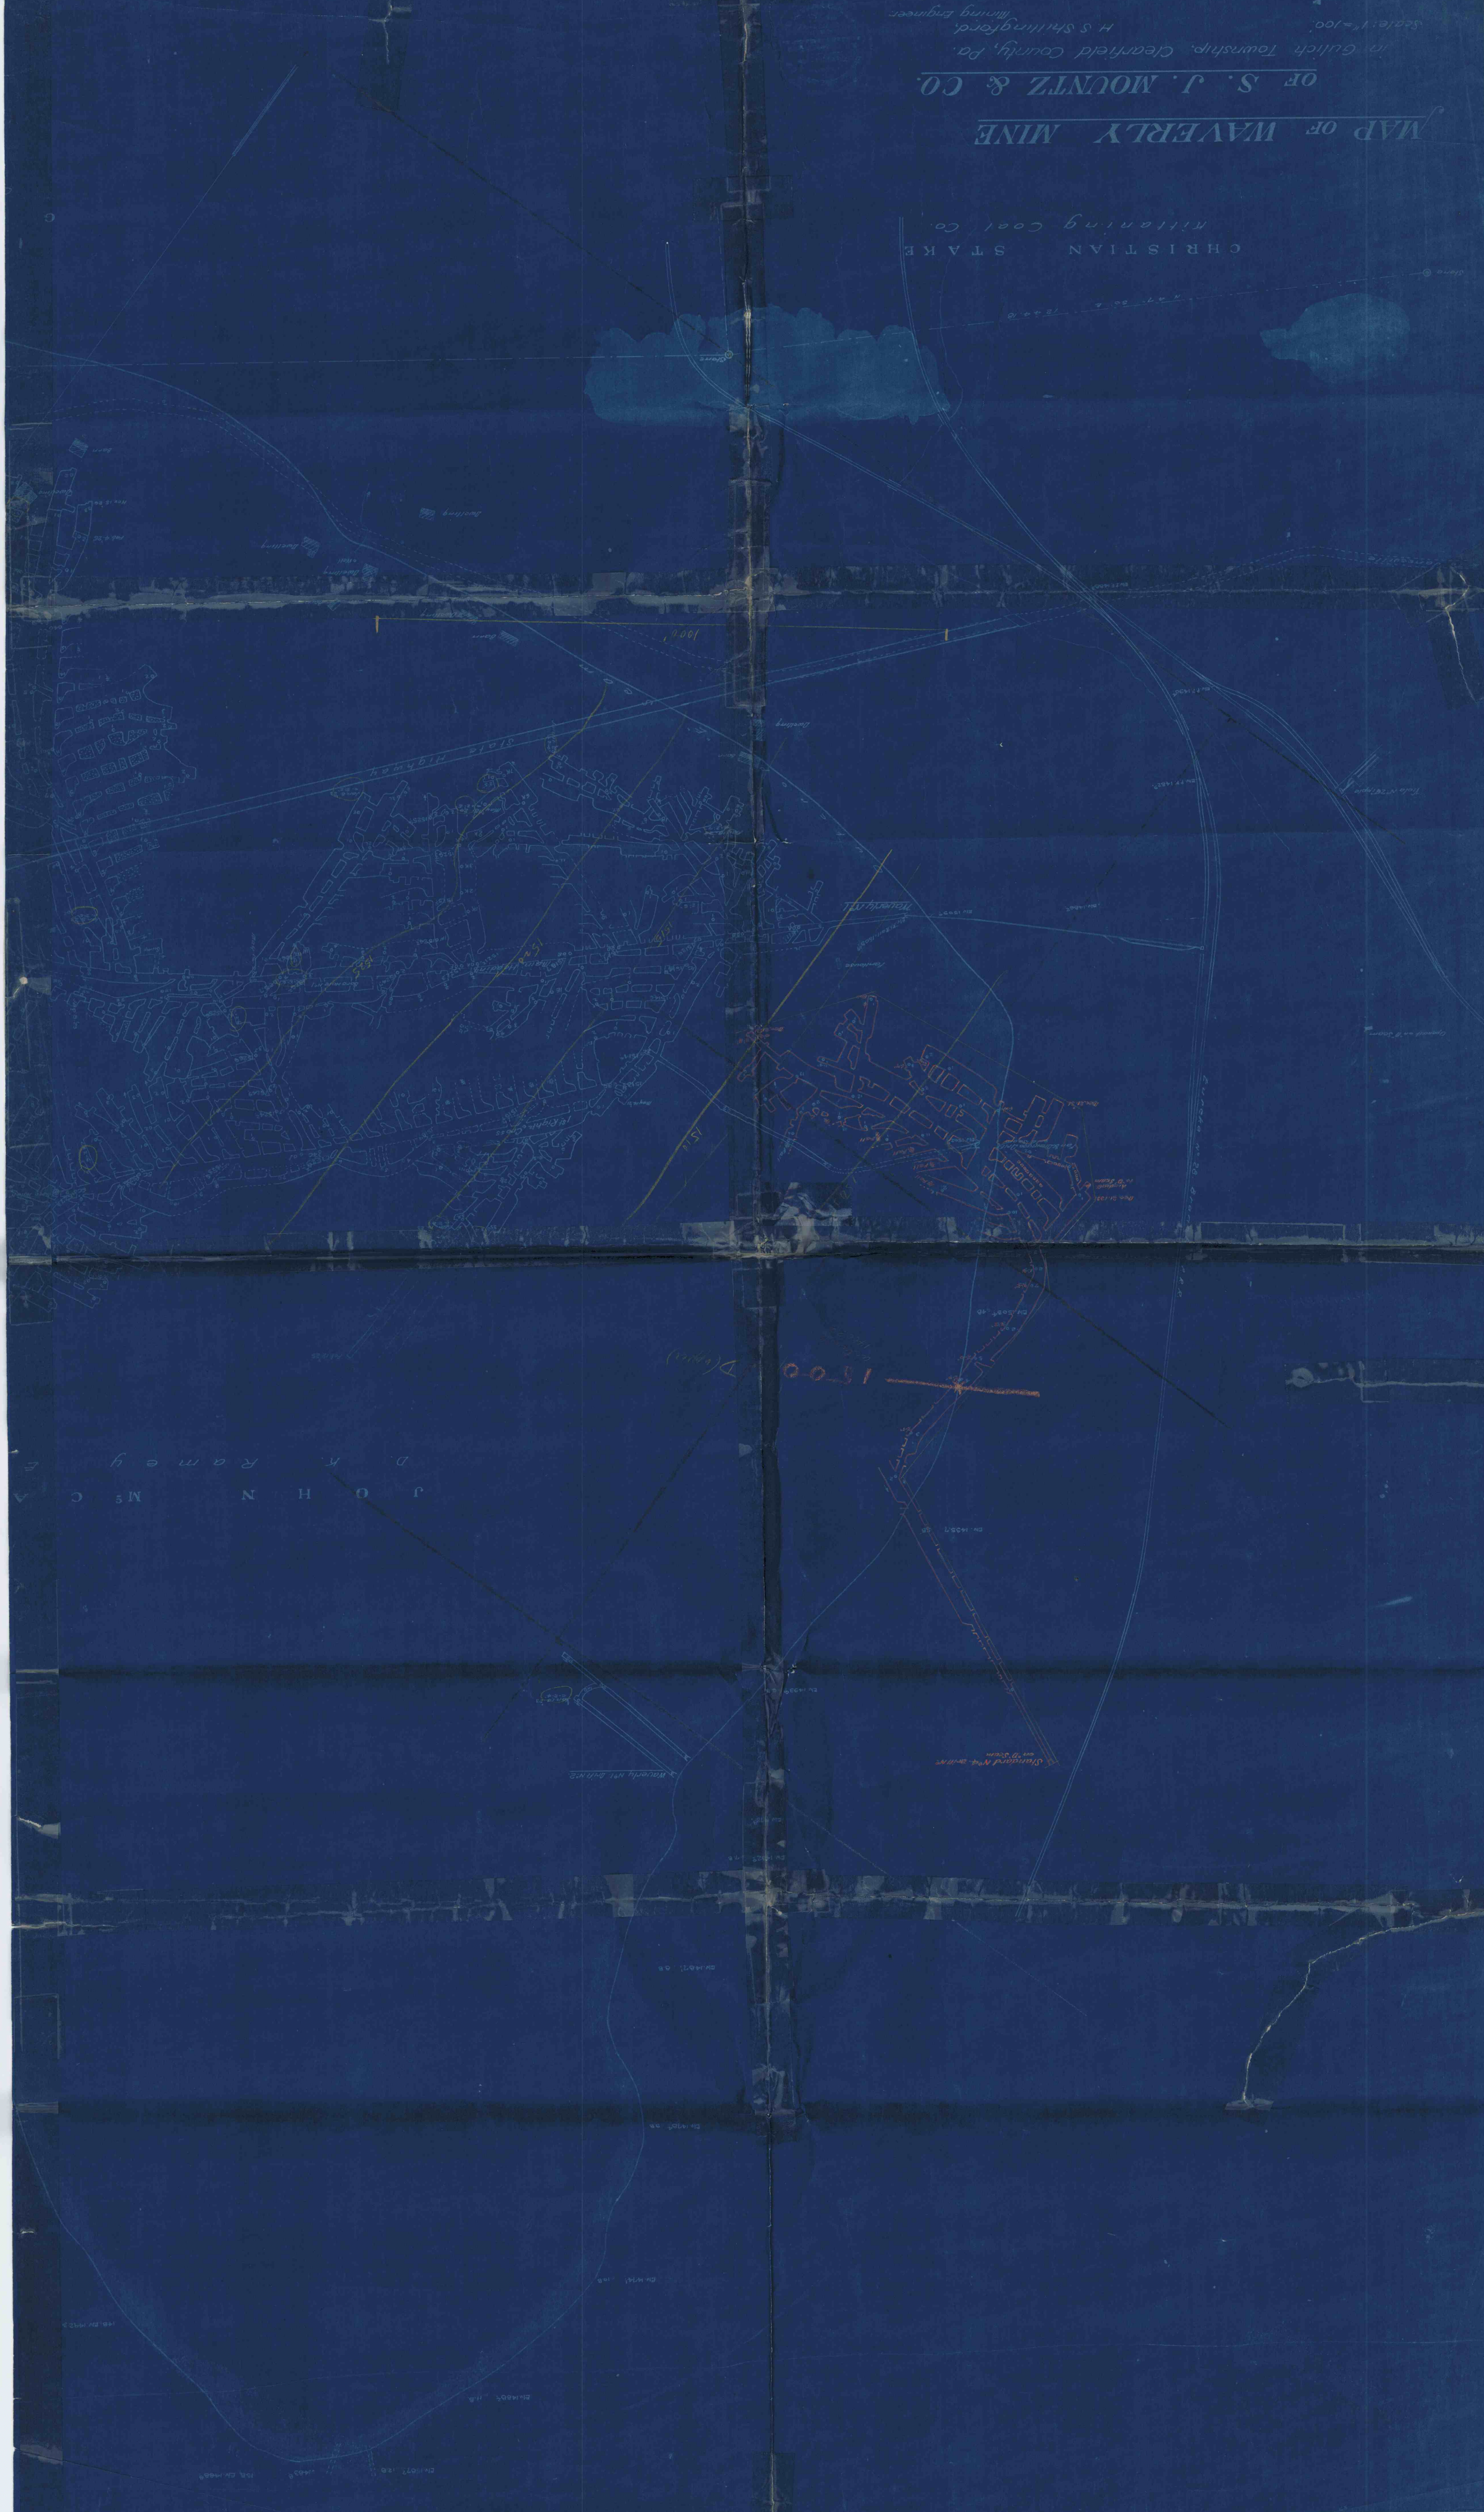

J O H N
M S C
D K R a m e y