


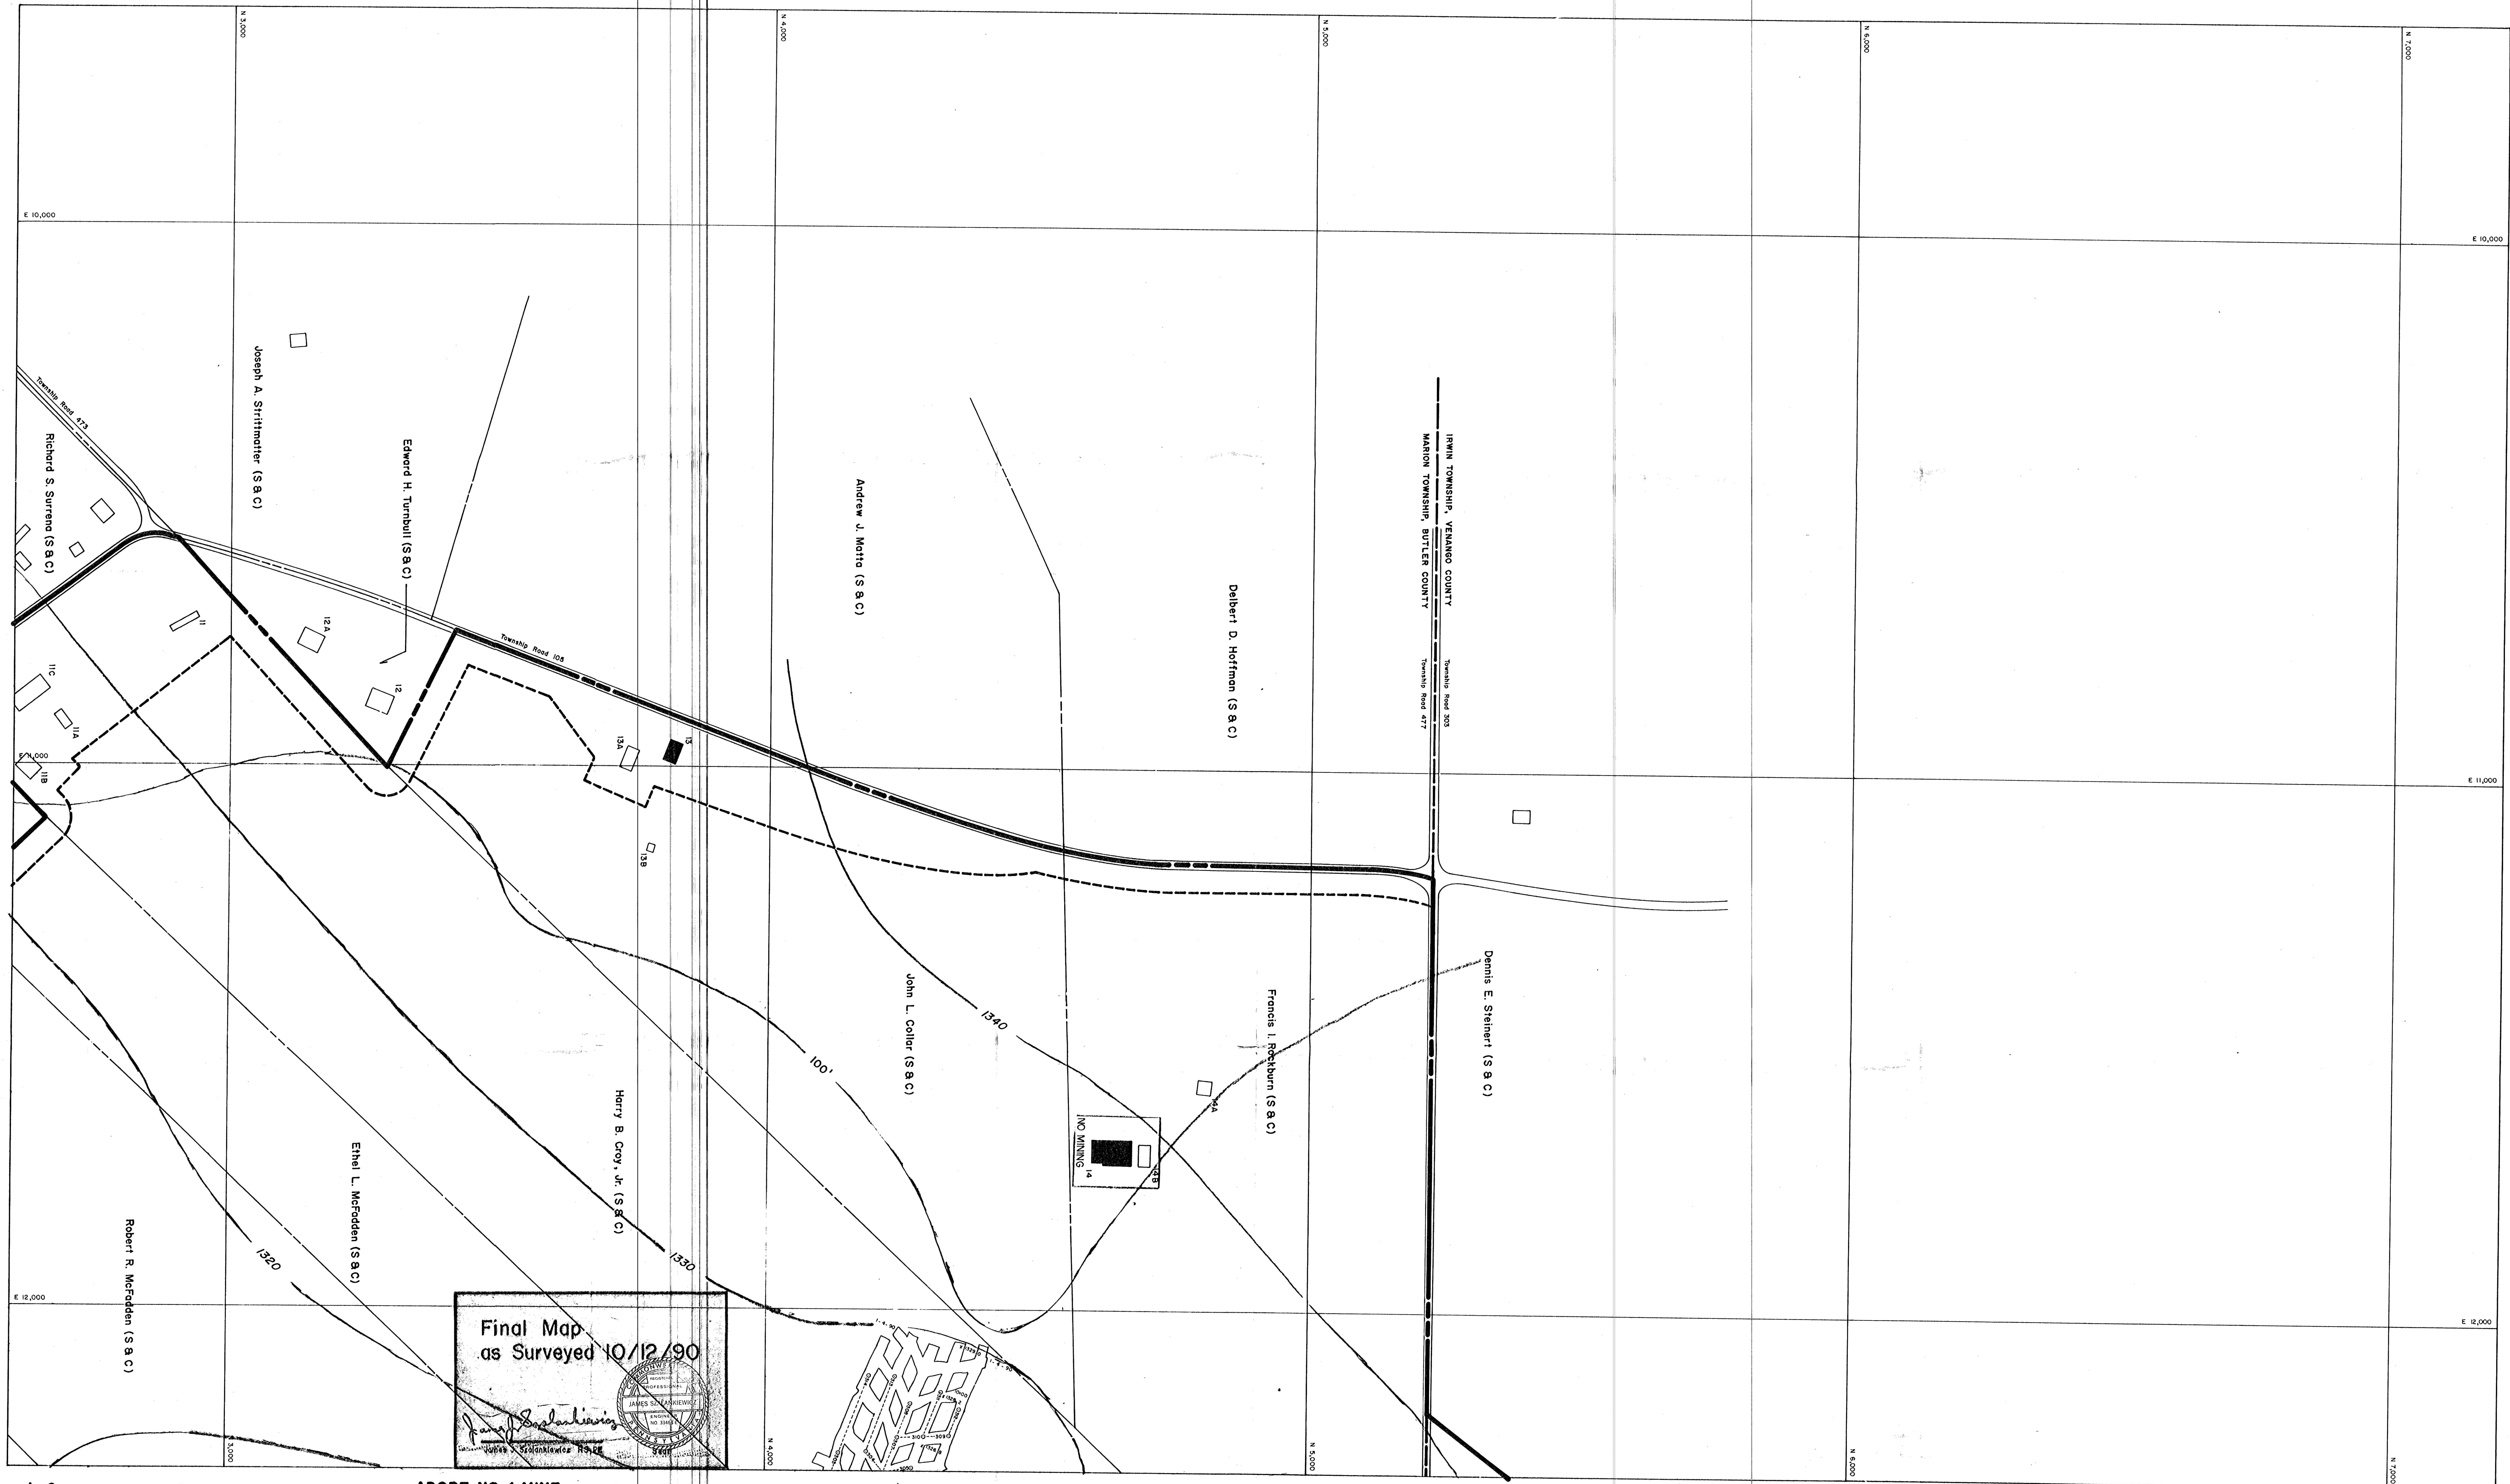

A - 2

ADOBE NO. 1 MINE
MARION & IRWIN TWPS.
BUTLER & VENANGO COS.
SCALE: 1" = 100' POSTING DATE: 1 - 4 - 90

ADOBE MINING COMPANY
PROJECTION NO. 3
MINING PERIOD: 2 - 1 - 90 to 8 - 1 - 90
#24
5-25-99
C.C.

BROOKVILLE COAL SEAM