


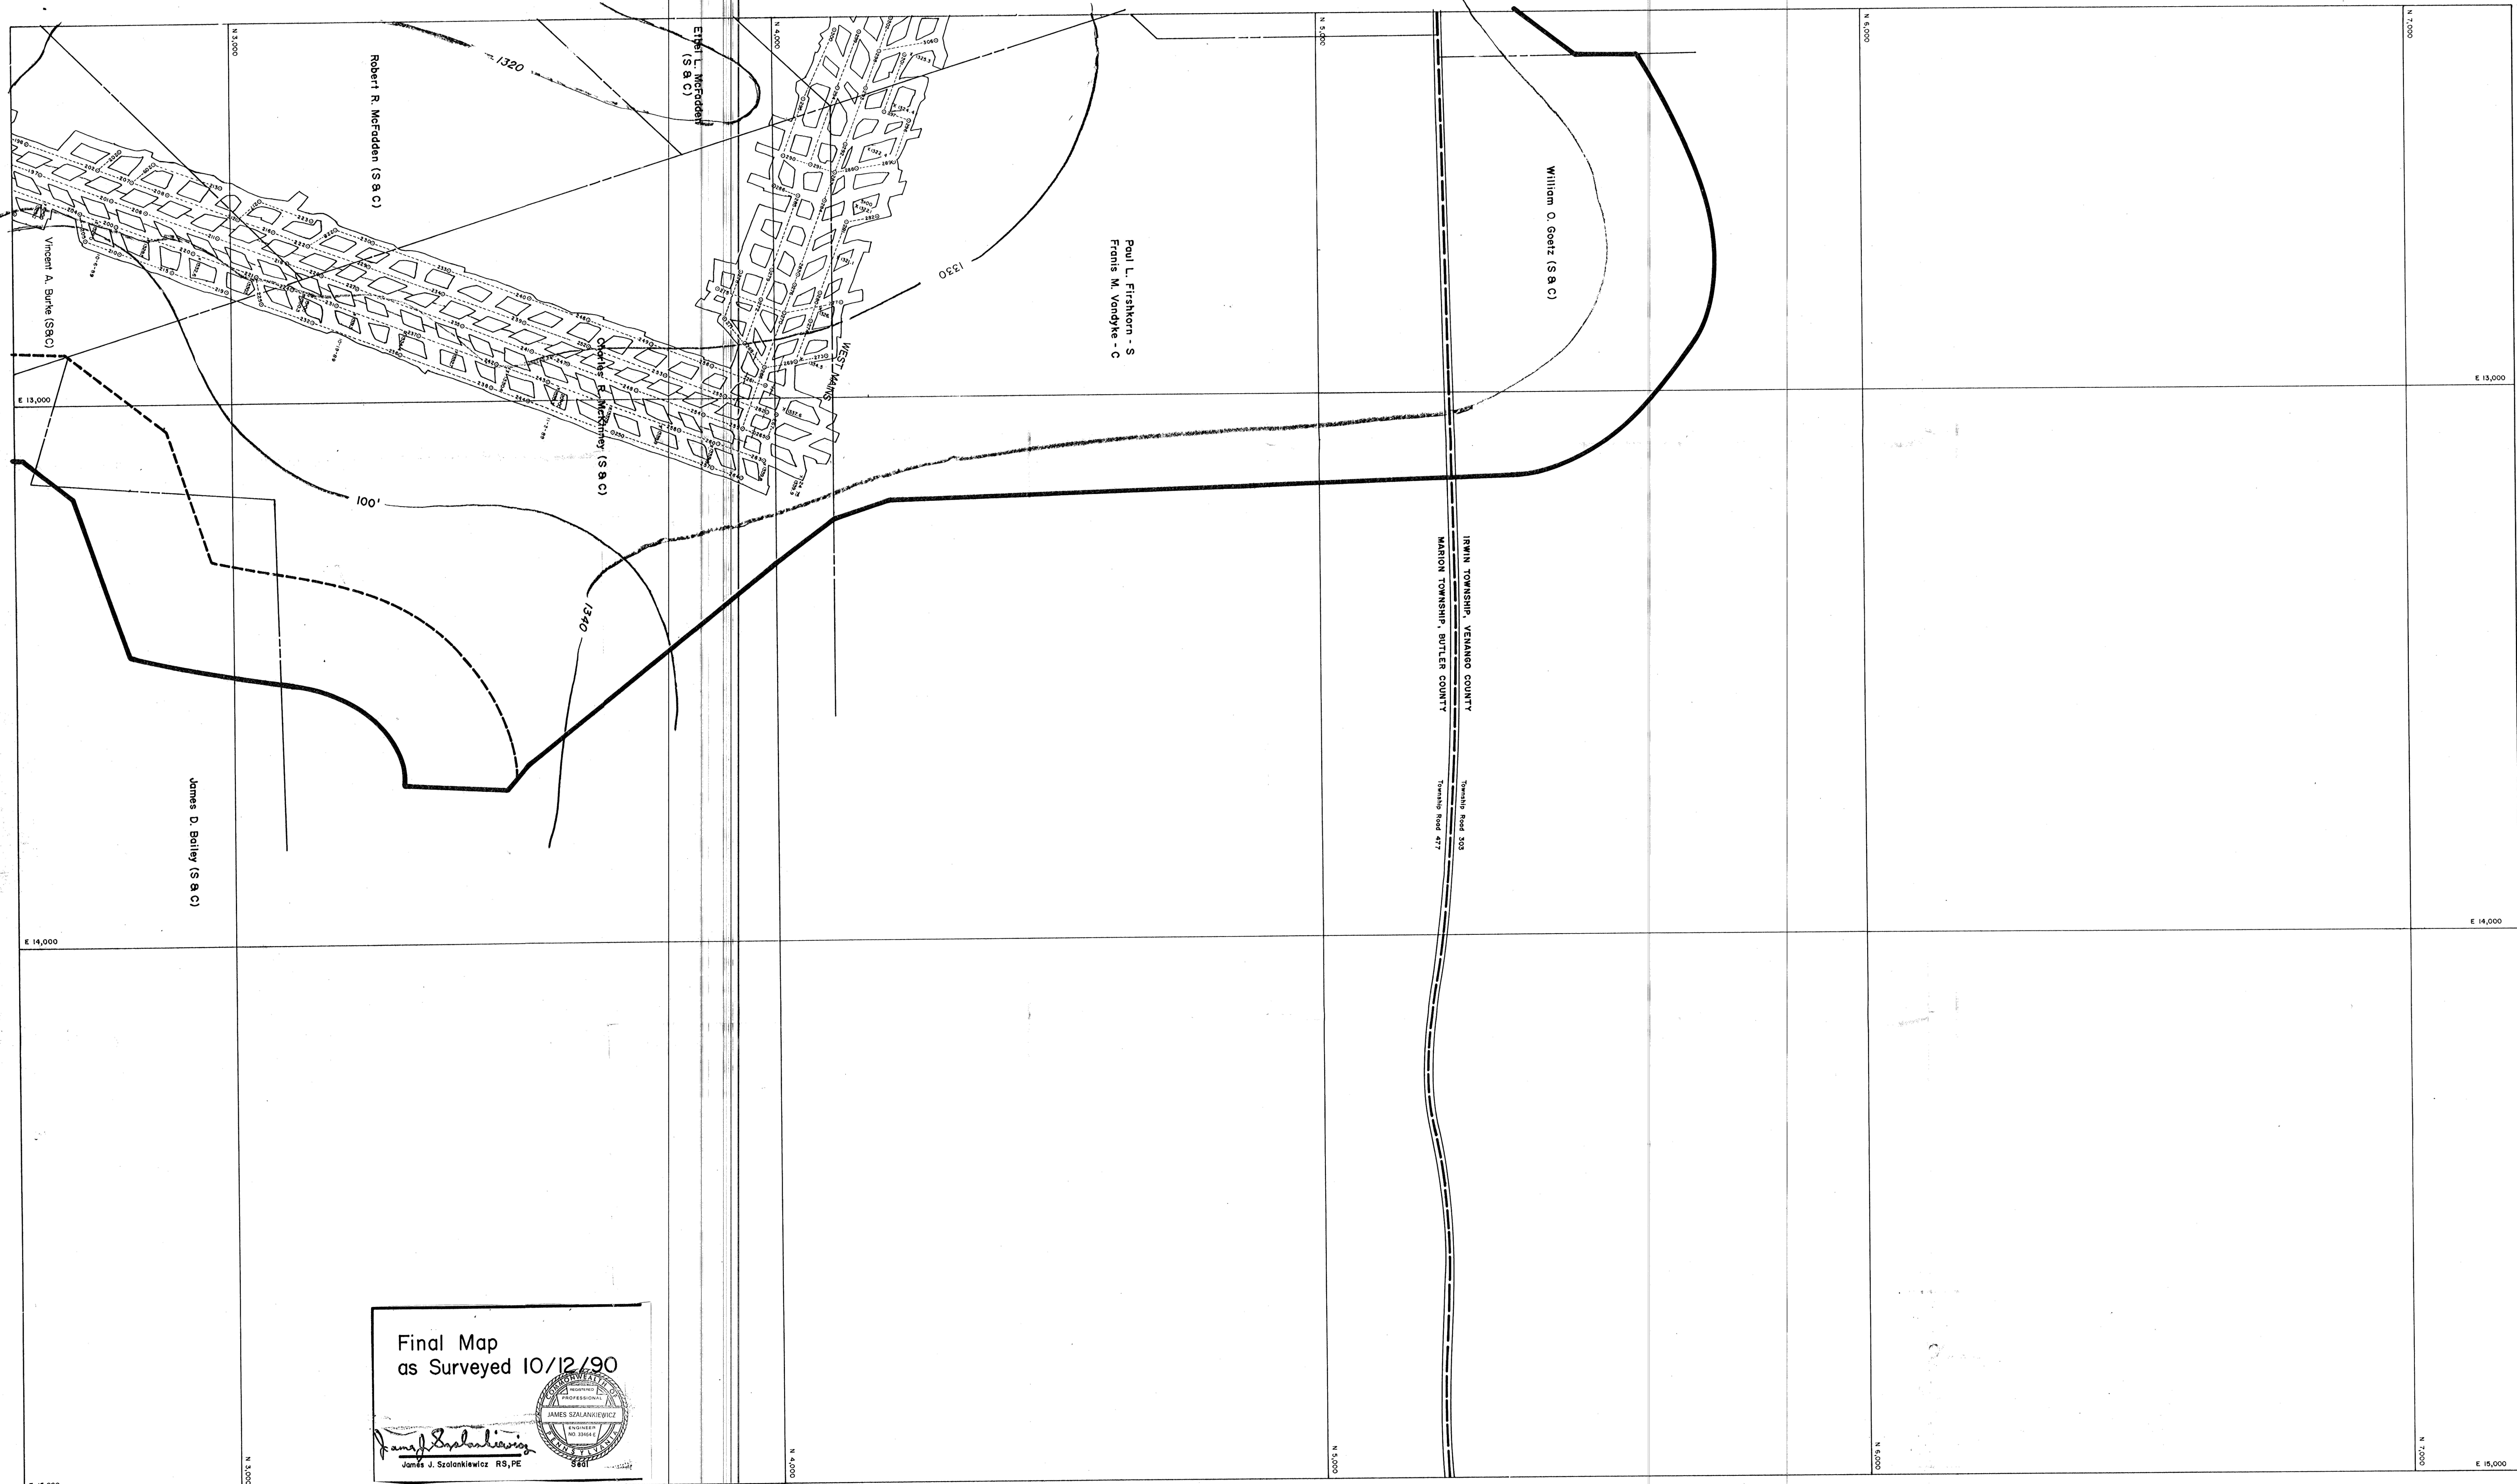

A - 3

Final Map
as Surveyed 10/12/90

James J. Szalankiewicz
James J. Szalankiewicz RS, PE

ADOBE NO. 1 MINE
MARION & IRWIN TOWNSHIPS.
BUTLER & VENANGO COS.
SCALE: 1" = 100' POSTING DATE: 1 - 4 - 90

ADOBE MINING COMPANY
PROJECTION NO. 3
MINING PERIOD: 2-1-90 to 8-1-90

24
5-25-99
C.C.

BROOKVILLE COAL SEAM