


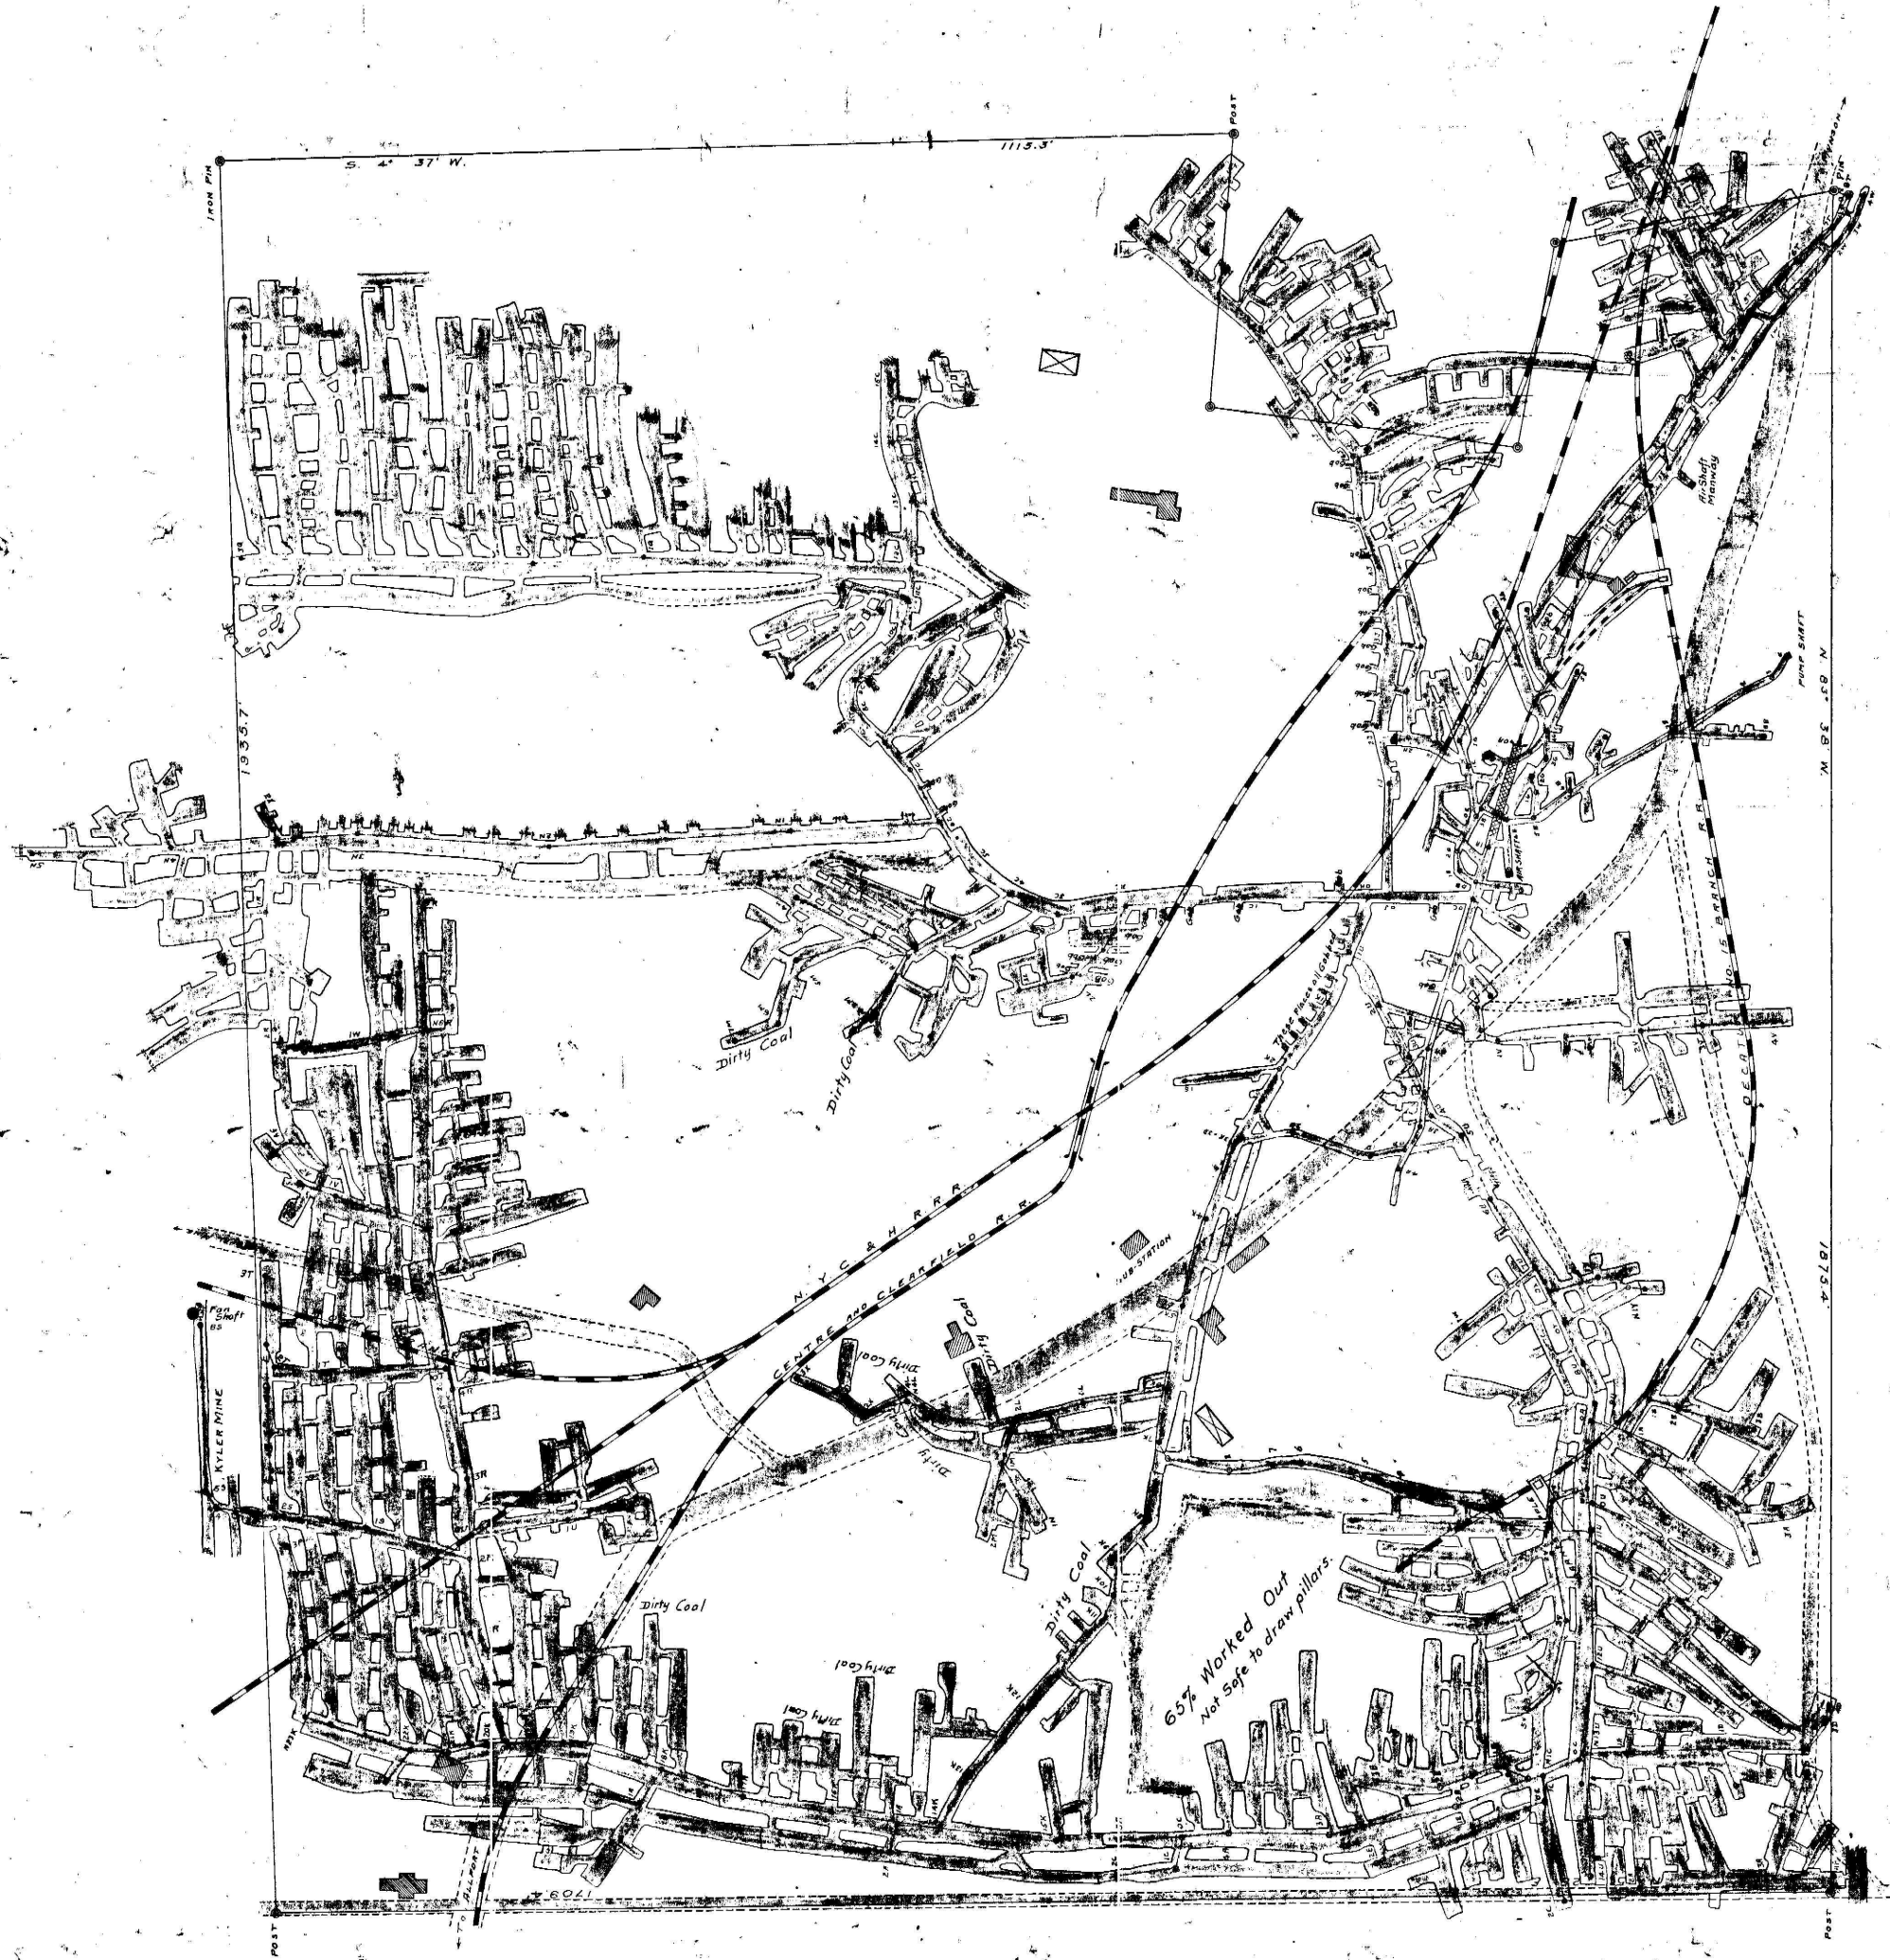

MAP OF LEADER SLOPE,

near
MUNSON, CLEARFIELD COUNTY,
Pennsylvania.

Scale 1" = 100 ft

Surveyed by
Mining Engineer

Surveyed by
Mining Engineer

Revised to Feb. 13, 1922.
Dec. 22, 1925.
June 17, 1931.