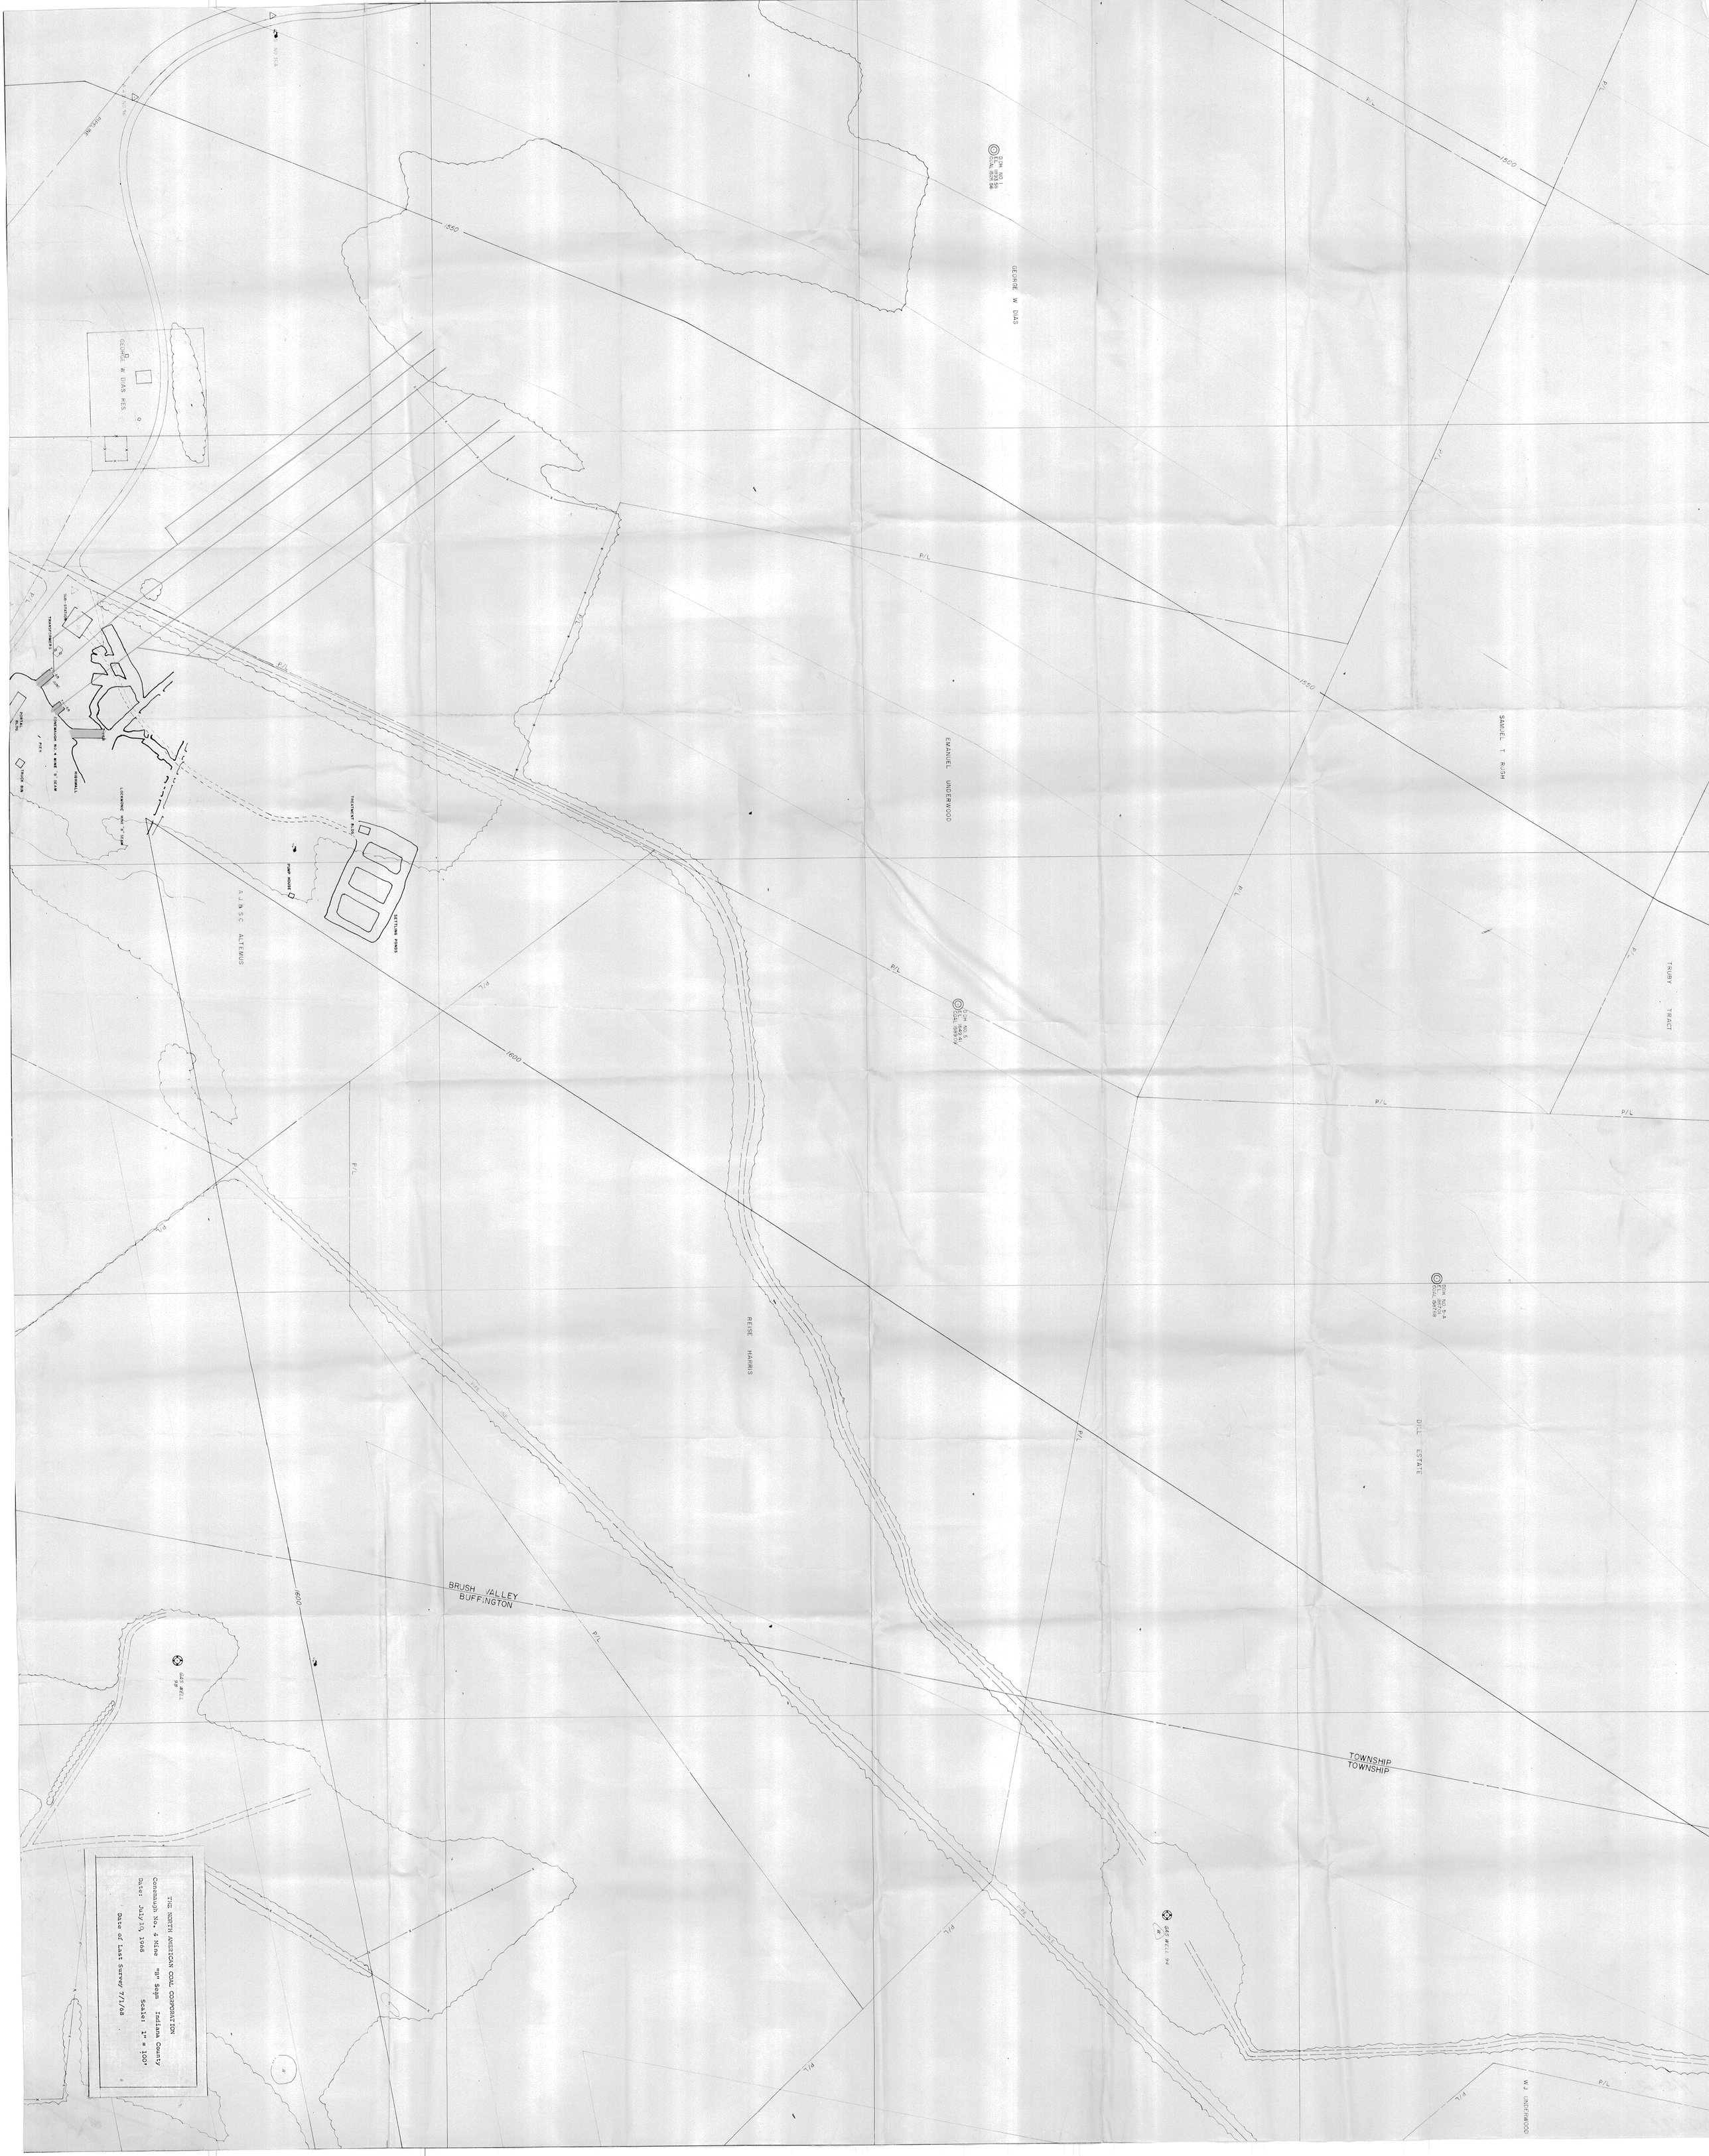THE NORTH AMERICAN COAL CORPORATION
Conemaugh No. 4 Mine "B" Seam Indiana County
Date: July 10, 1968 Scale: 1" = 100'
Date of Last Survey 7/1/68
GEORGE W DIAS RES.
GEORGE W DIAS
EMANUEL UNDERWOOD
SAMUEL T. RUGH
TRUBY TRACT
DILL ESTATE
REISE HARRIS
A.J.&S.C. ALTEMUS
W J UNDERWOOD
BRUSH VALLEY
BUFFINGTON
TOWNSHIP
TOWNSHIP
PIPELINE
PIPE LINE
P/L
1500
1550
1600
DDH NO 1 EL 1893.56 COAL 1526.56
DDH NO 5 EL 1649.41 COAL 1589.09
DDH NO 5-A EL 1867.01 COAL 1587.68
GAS WELL 98
GAS WELL 94
SUB-STATION
TRANSFORMERS
PORTAL BLDG.
CONEMAUGH NO. 4 MINE "B" SEAM
PIER
TRUCK BIN
HIGHWALL
LOCKMONIC MINE "B" SEAM
TREATMENT BLDG.
PUMP HOUSE
SETTLING PONDS