


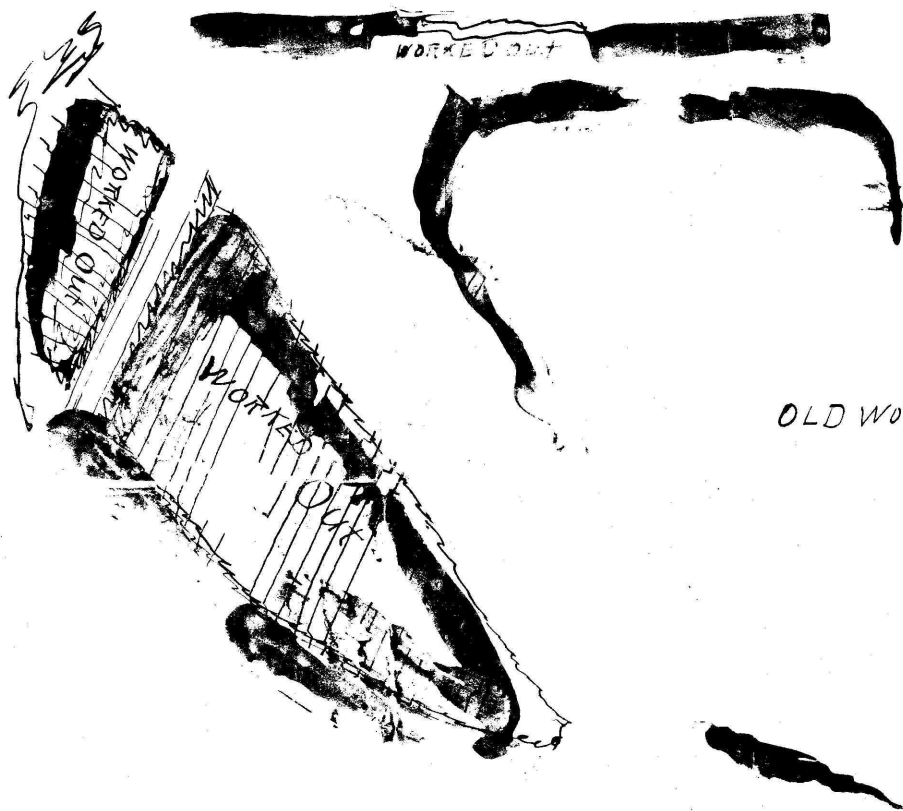

Pittsburg vein.
72 inches

6-1-20 SHOWING ONLY
OPEN FIBS AND STUMPS
STANDING.