


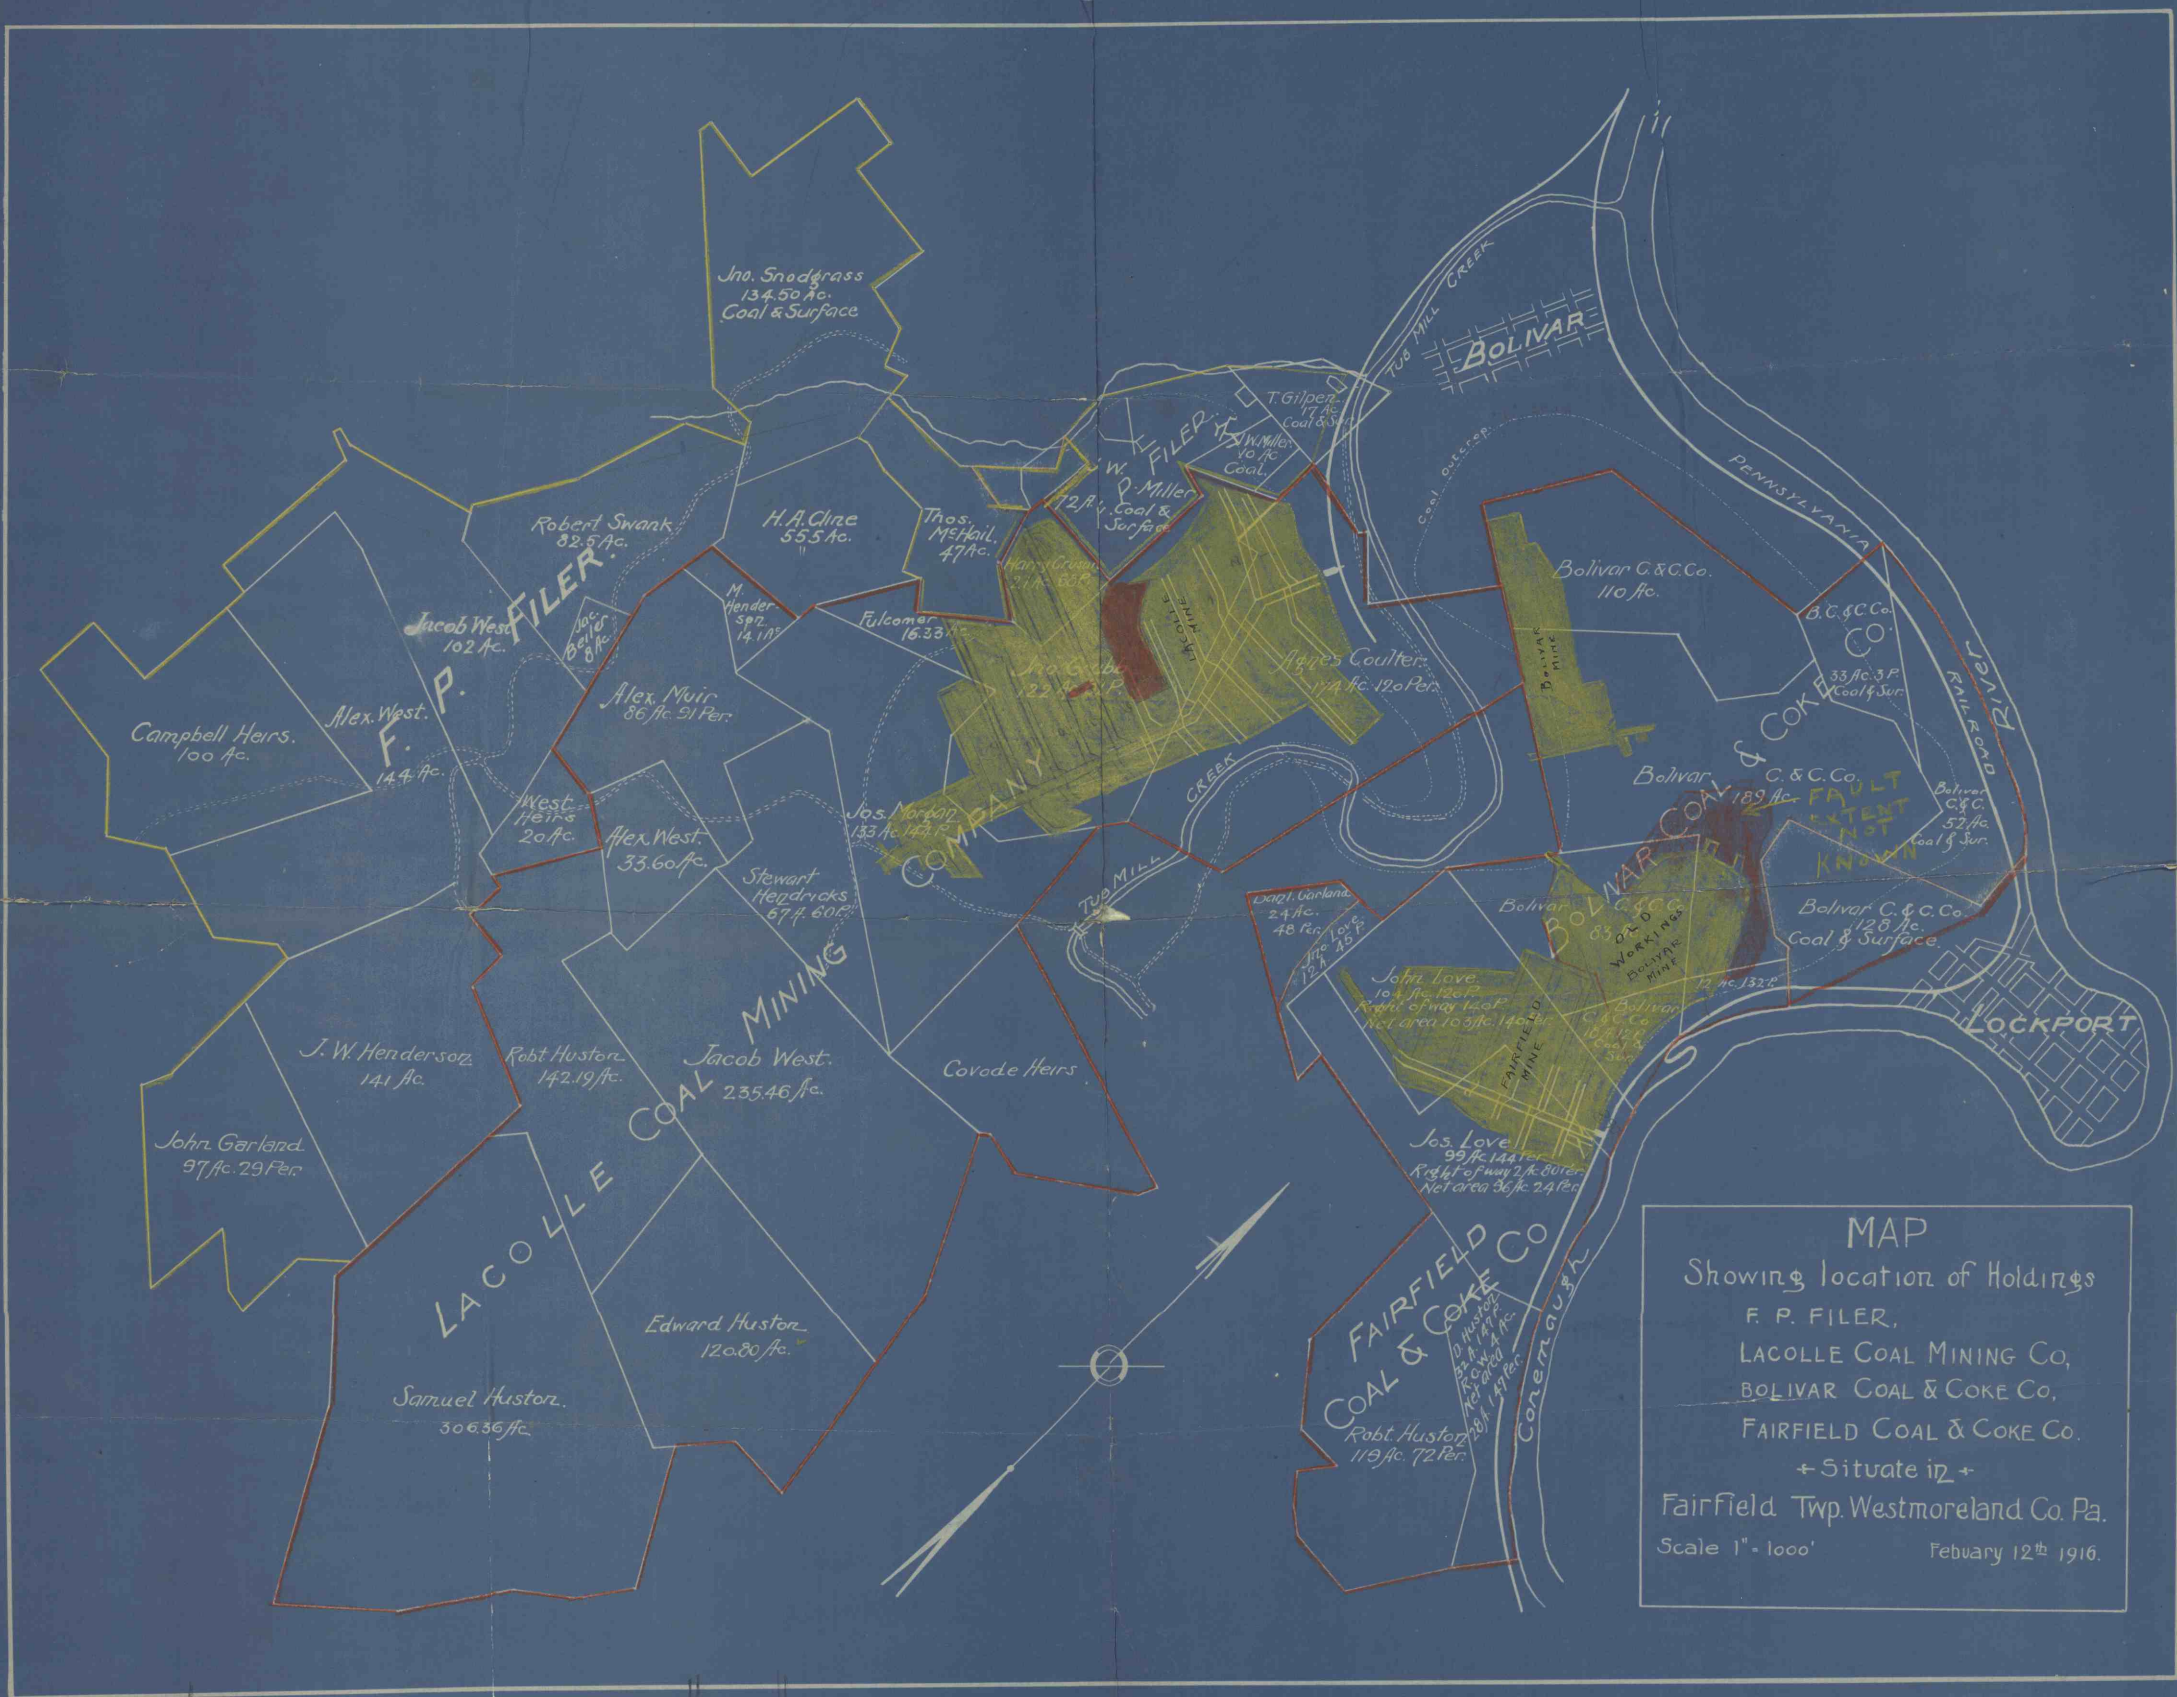

Jno. Snodgrass
134.50 Ac.
Coal & Surface

Robert Swank
82.5 Ac.

H. A. Clive
55.5 Ac.

Thos. McHail
47 Ac.

T. Gilper
17 Ac.
Coal & Surface

W. Miller
10 Ac.
Coal

W. Miller
12 Ac.
Coal & Surface



Agnes Coulter
114 Ac.
Coal & Surface

Bolivar C. & C. Co.
110 Ac.

B. C. & C. Co.
33 Ac.
Coal & Surface

Bolivar C. & C. Co.
52 Ac.
Coal & Surface

Bolivar C. & C. Co.
128 Ac.
Coal & Surface

FILER
Jacob West
102 Ac.
F. P. FILER
Alex. West
14.4 Ac.

Campbell Heirs.
100 Ac.

West Heirs
20 Ac.

Alex. Muir
86 Ac.
91 Per.

Alex. West
33.60 Ac.

Jos. Morgan
133 Ac.
143 Per.

Stewart Hendricks
67 Ac.
60 Per.

J. W. Henderson
141 Ac.

Robt. Huston
142.19 Ac.

Jacob West
235.46 Ac.

Covade Heirs

John Garland
97 Ac.
29 Per.

Samuel Huston
306.36 Ac.

Edward Huston
120.80 Ac.

24 Ac.
48 Per.

104 Ac.
120 Per.
Right of way 140 Per.
Net area 103 Ac.
140 Per.

Jos. Love
99 Ac.
144 Per.
Right of way 2 Ac.
80 Per.
Net area 96 Ac.
24 Per.

FAIRFIELD
COAL & COKE CO.
Robt. Huston
119 Ac.
72 Per.

Conemaugh

MAP
Showing location of Holdings
F. P. FILER,
LACOLLE COAL MINING Co,
BOLIVAR COAL & COKE Co,
FAIRFIELD COAL & COKE Co.
+ Situate in +
Fairfield Twp. Westmoreland Co. Pa.
Scale 1" = 1000' February 12th 1916.