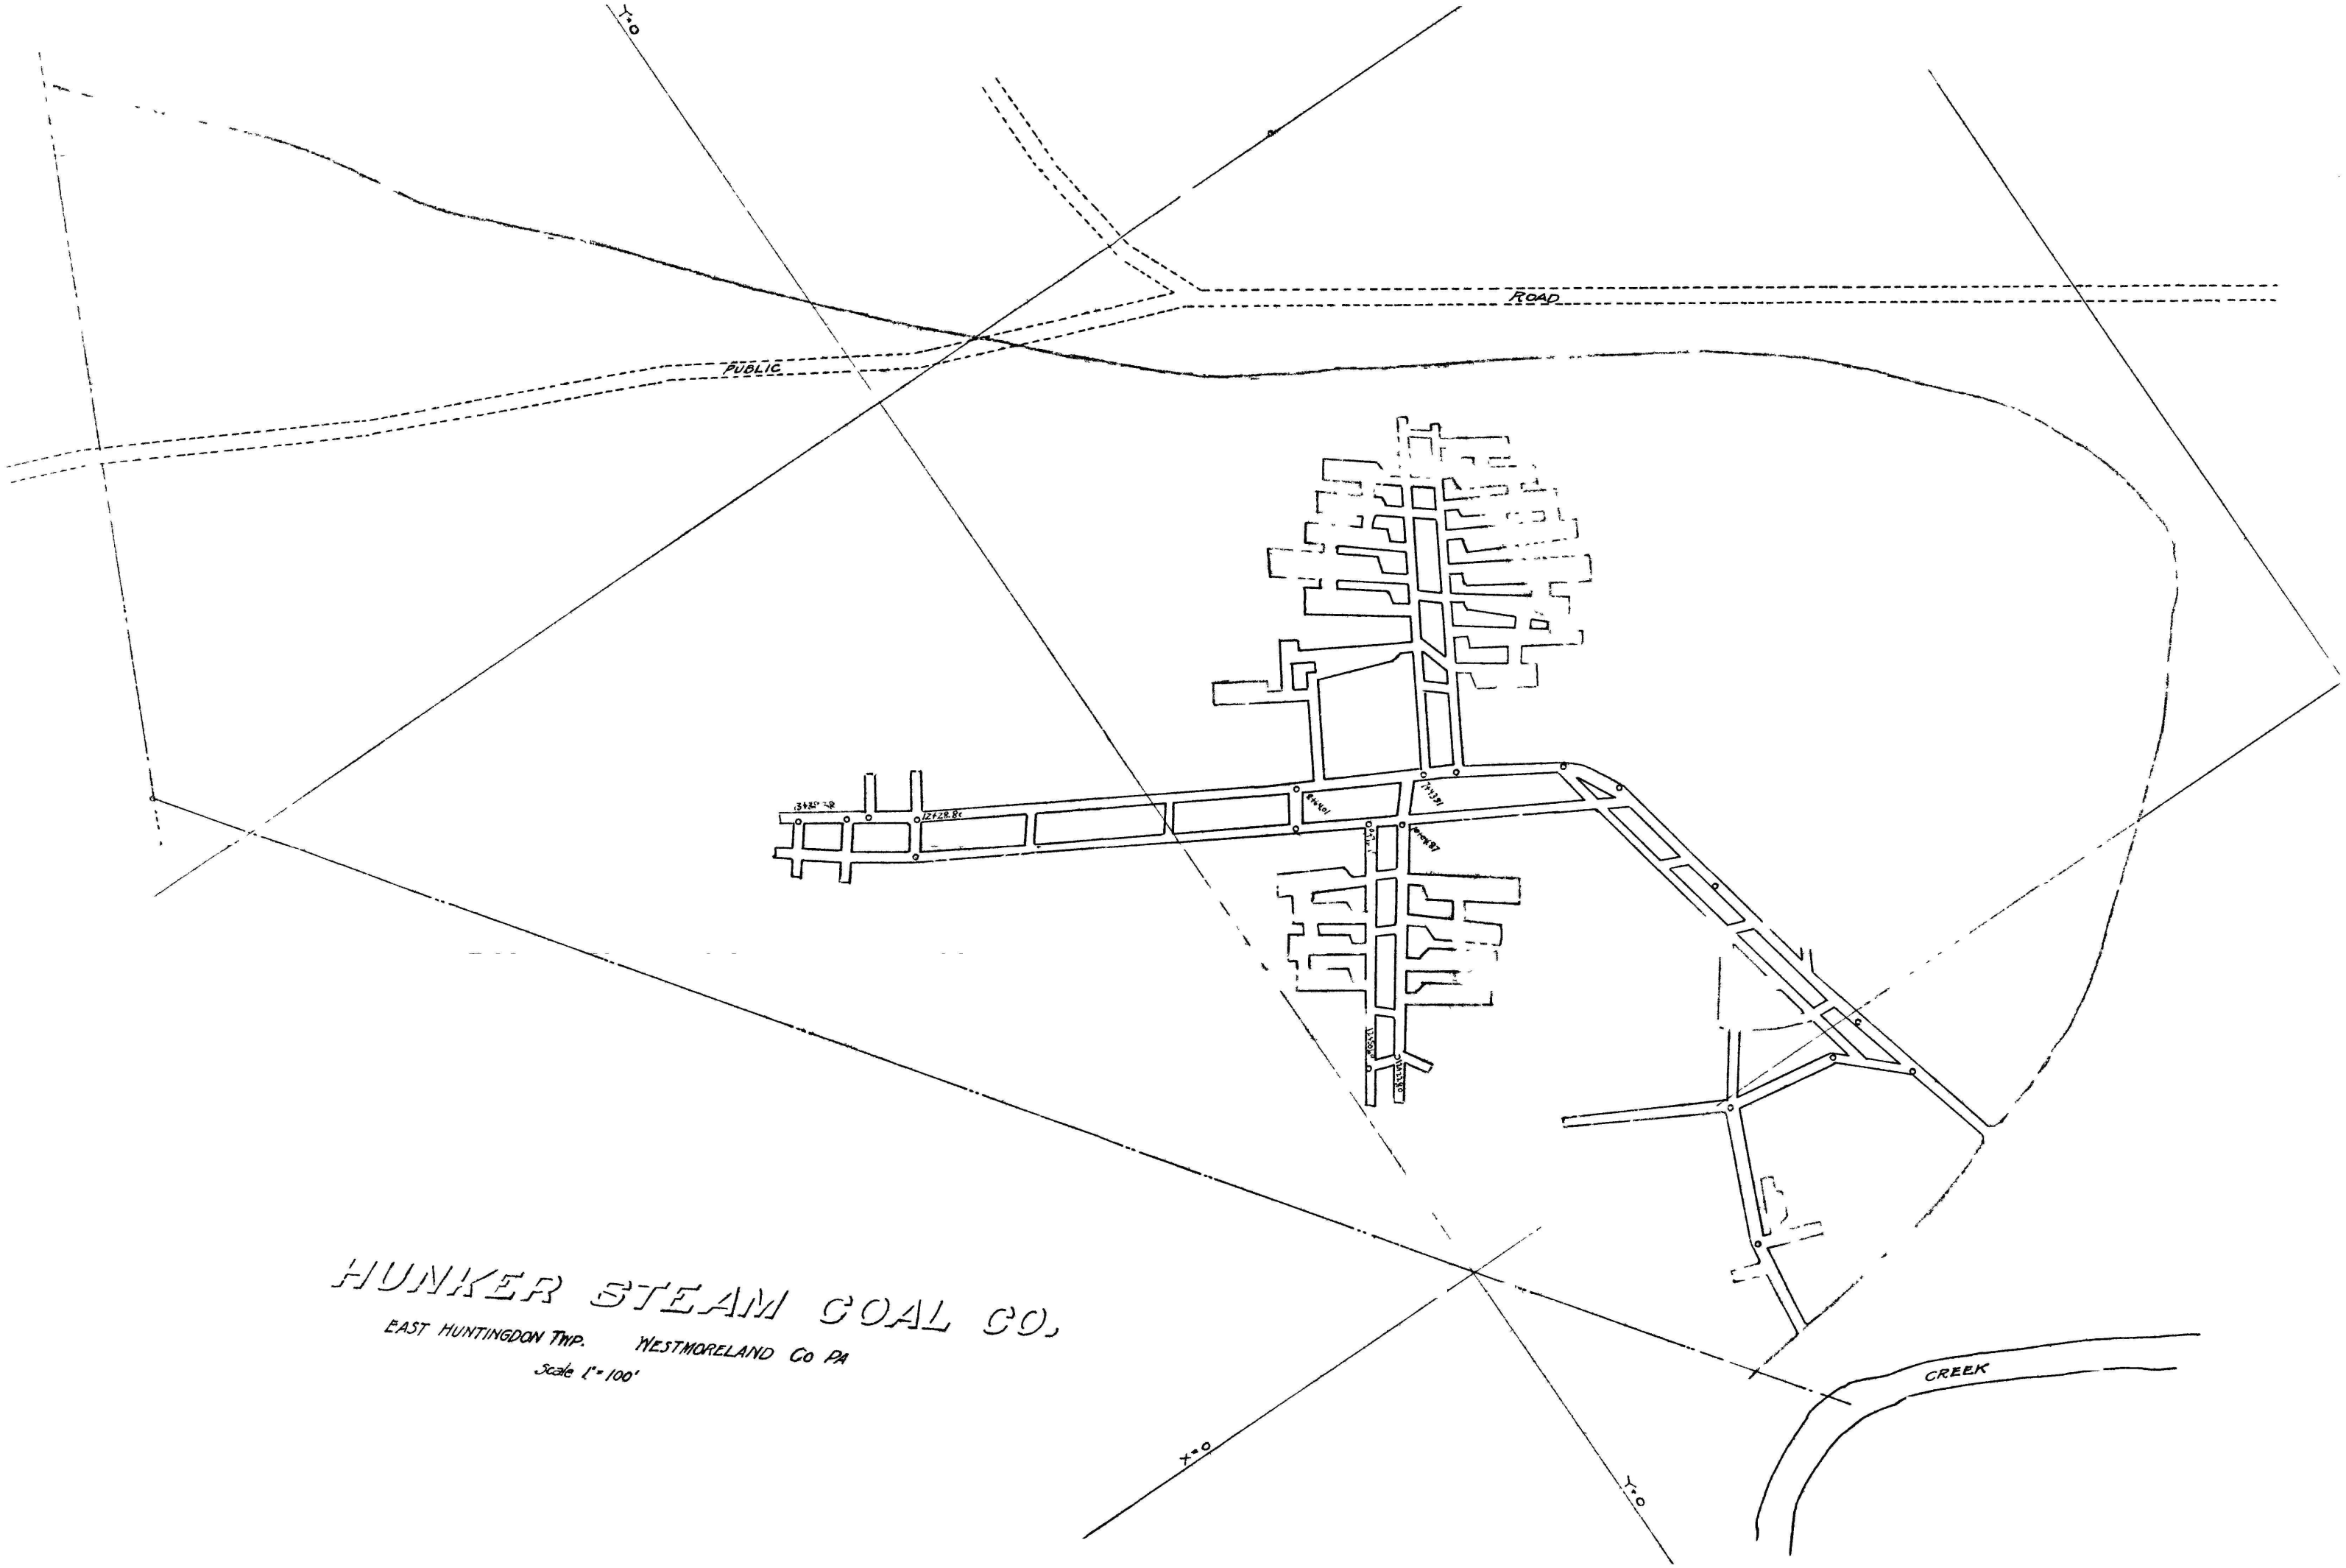

HUNKER STEAM COAL CO.

EAST HUNTINGDON TWP. WESTMORELAND CO PA

Scale 1" = 100'