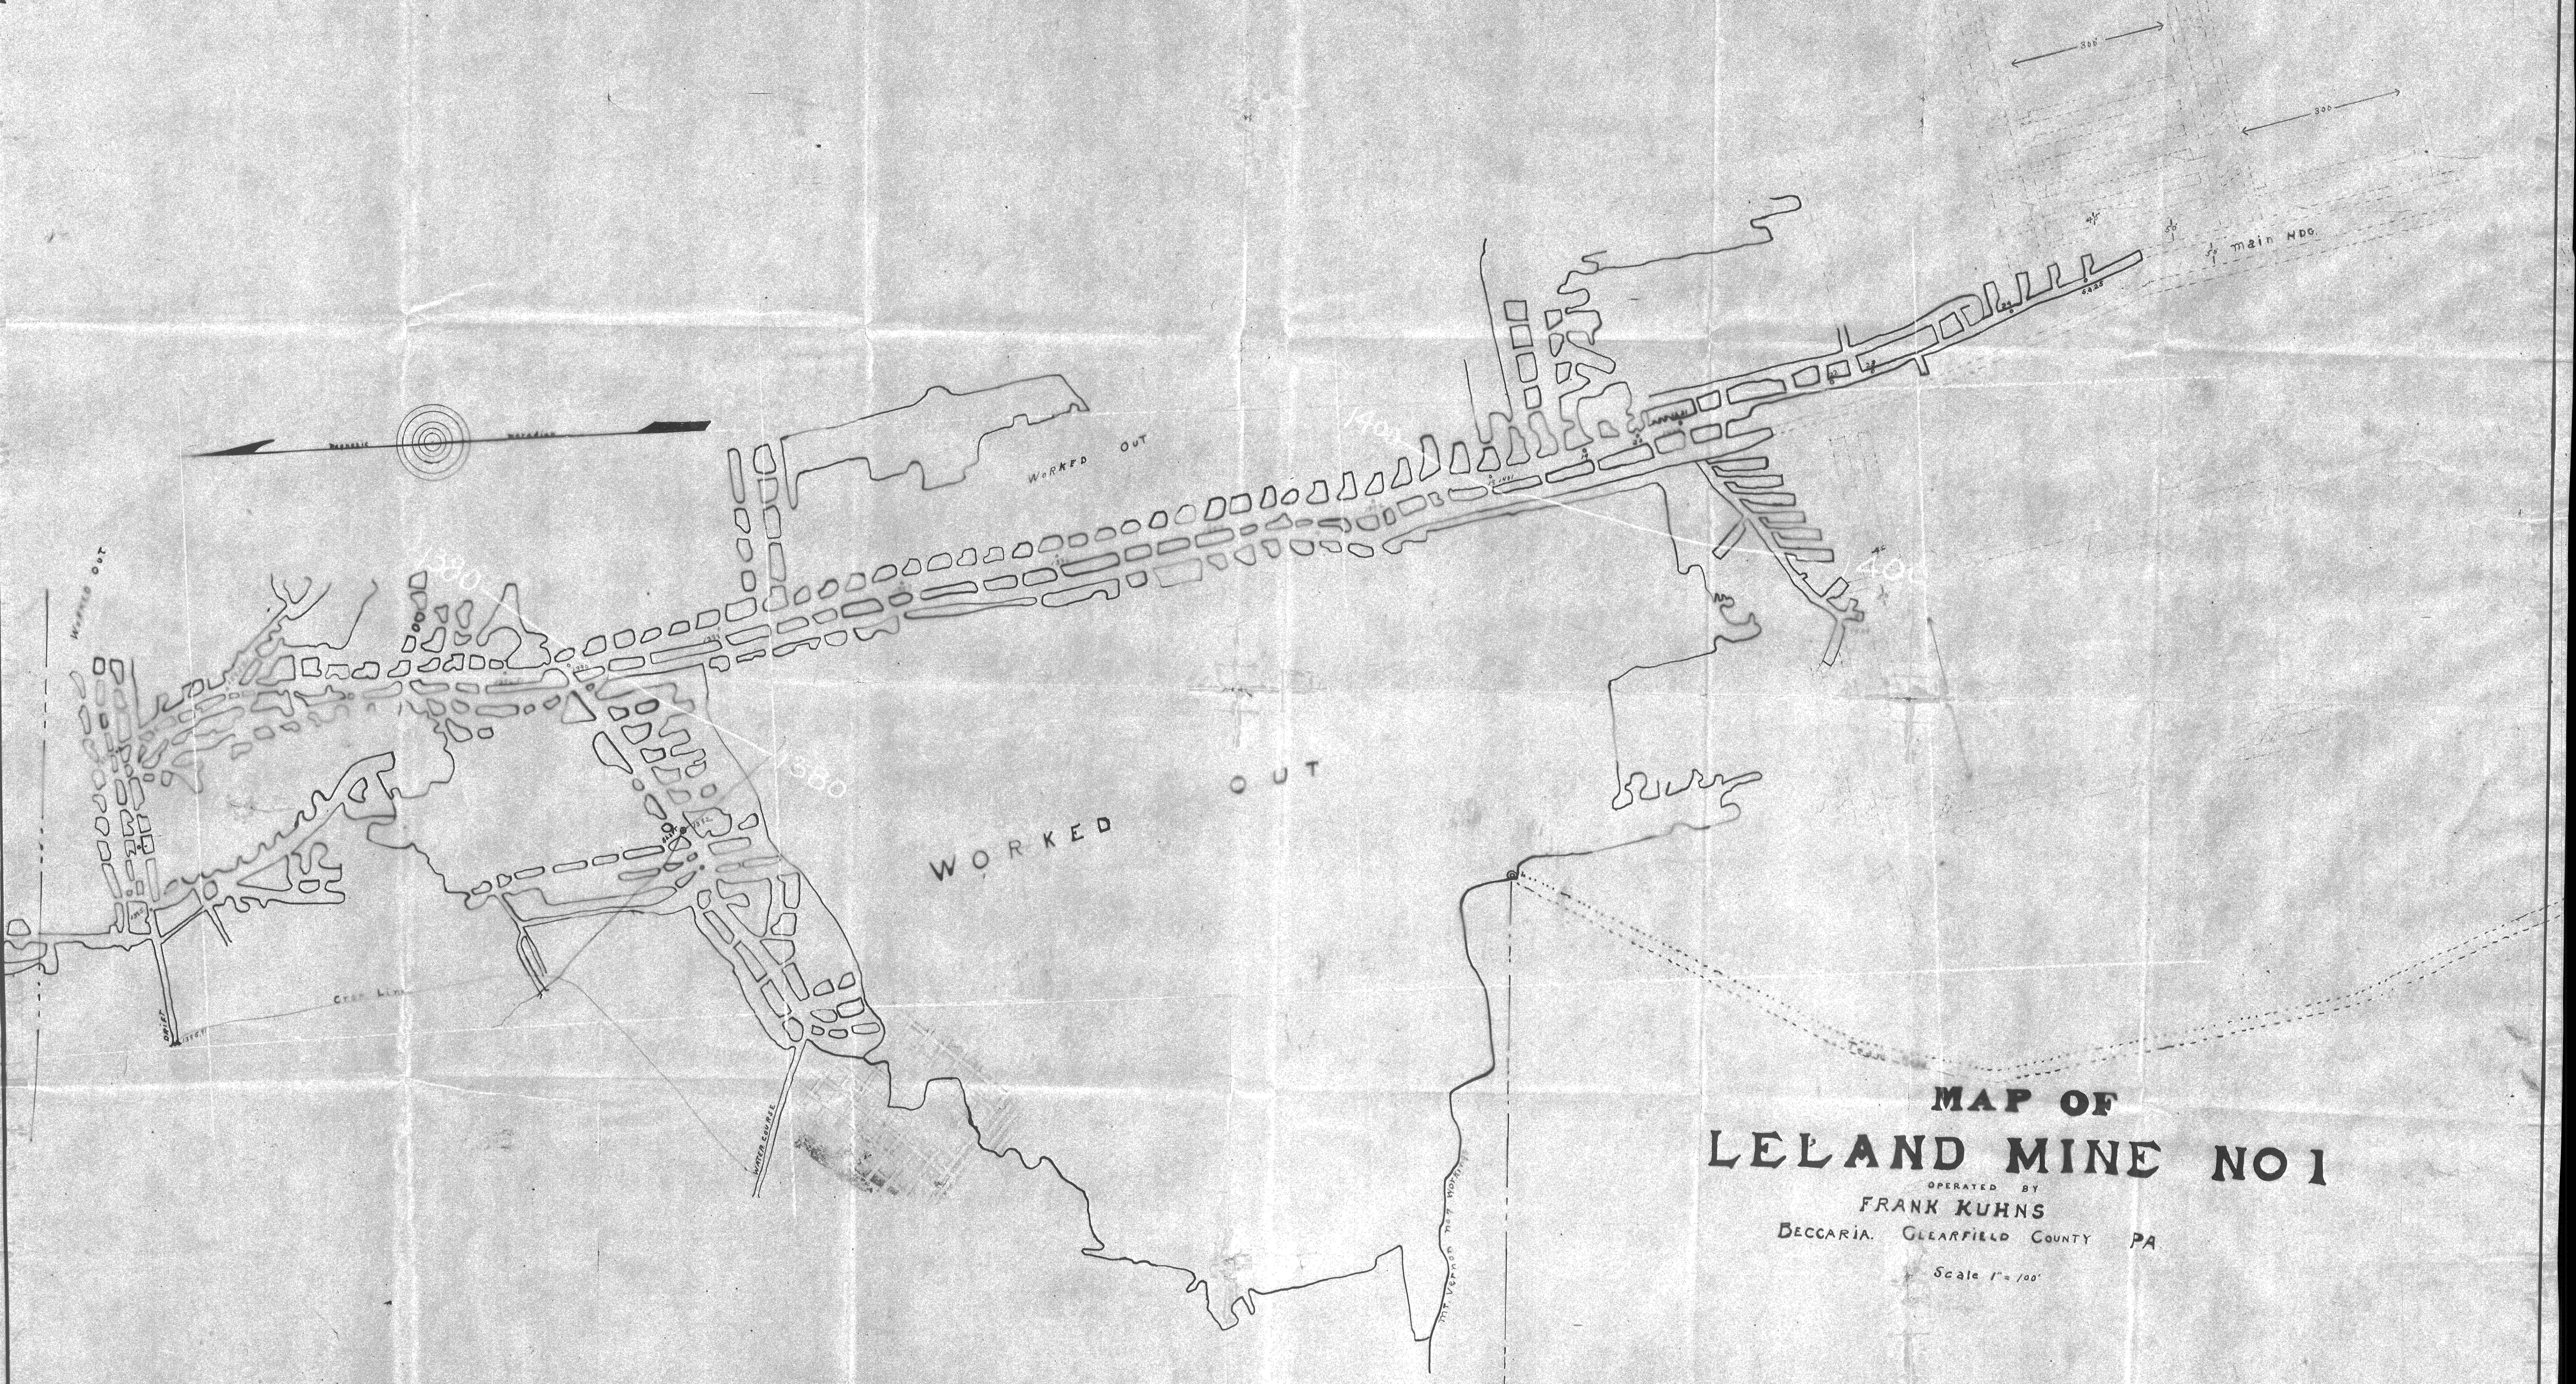
Magnetic Meridian
WORKED OUT
WORKED OUT
WORKED OUT
1380
1380
1380
1400
1400
SHAFT
1382
DRIFT
1355.41
Crop Line
WATER COURSE
Mt. Vernon No 7 Work
300
300
main HDG.

MAP OF
LELAND MINE NO 1

OPERATED BY
FRANK KUHNS
BECCARIA. CLEARFIELD COUNTY PA

Scale 1" = 100'