


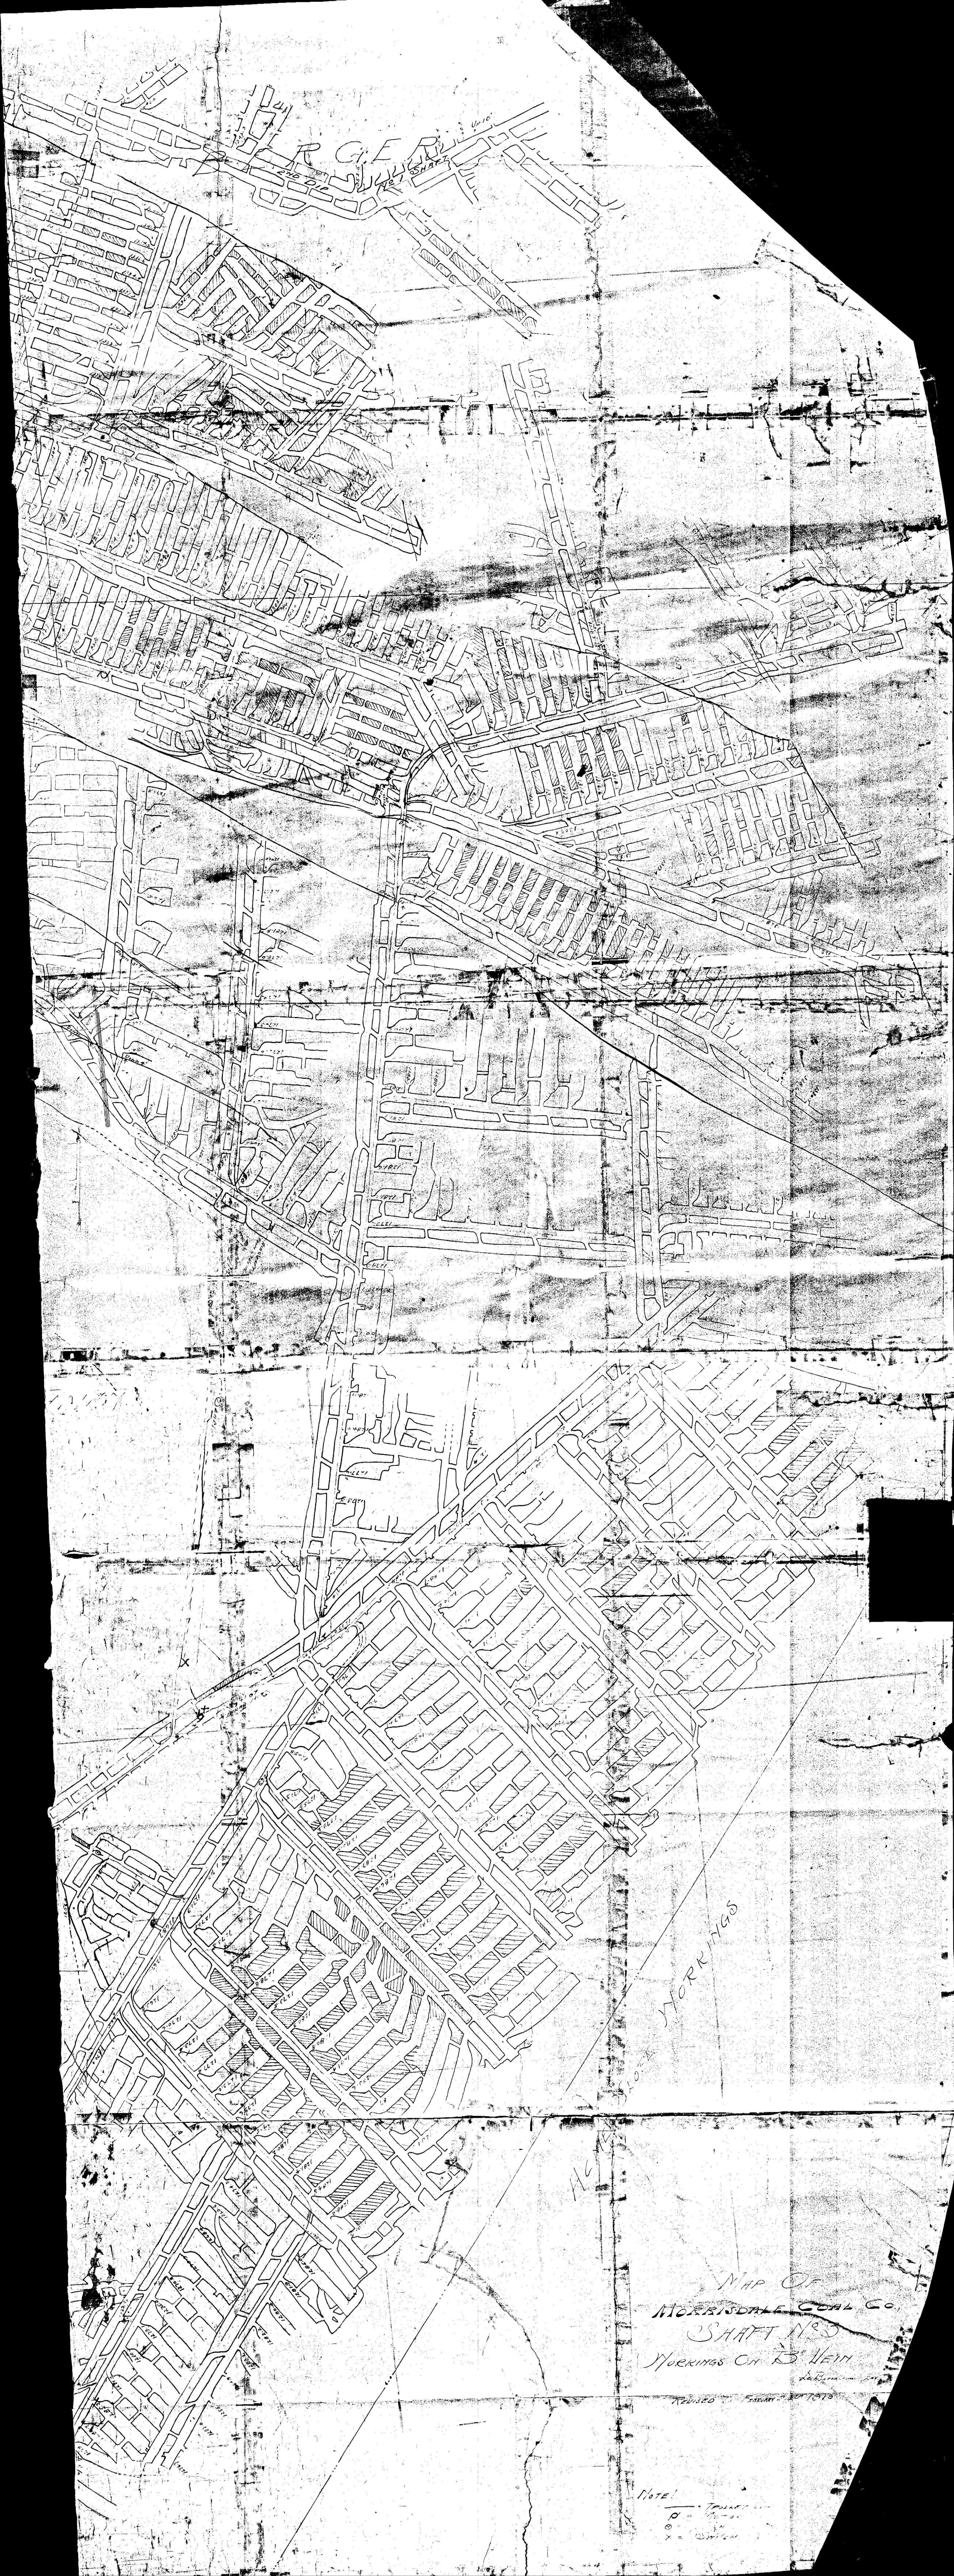

MAP OF
MORRISDALE COAL CO.
WORKINGS ON B. WEIN

NOTE:
O = Tunnel
X = Shaft