

MINING - OPERATIONS

"E" SEAM


F. J. YEAGER ESTATE

SITUATED IN CONEMAUGH TOWNSHIP, SOMERSET CO. PA.

SCALE 1"=100'

MAY 1ST, 1939.

L. H. ALTEMUS, R.S.

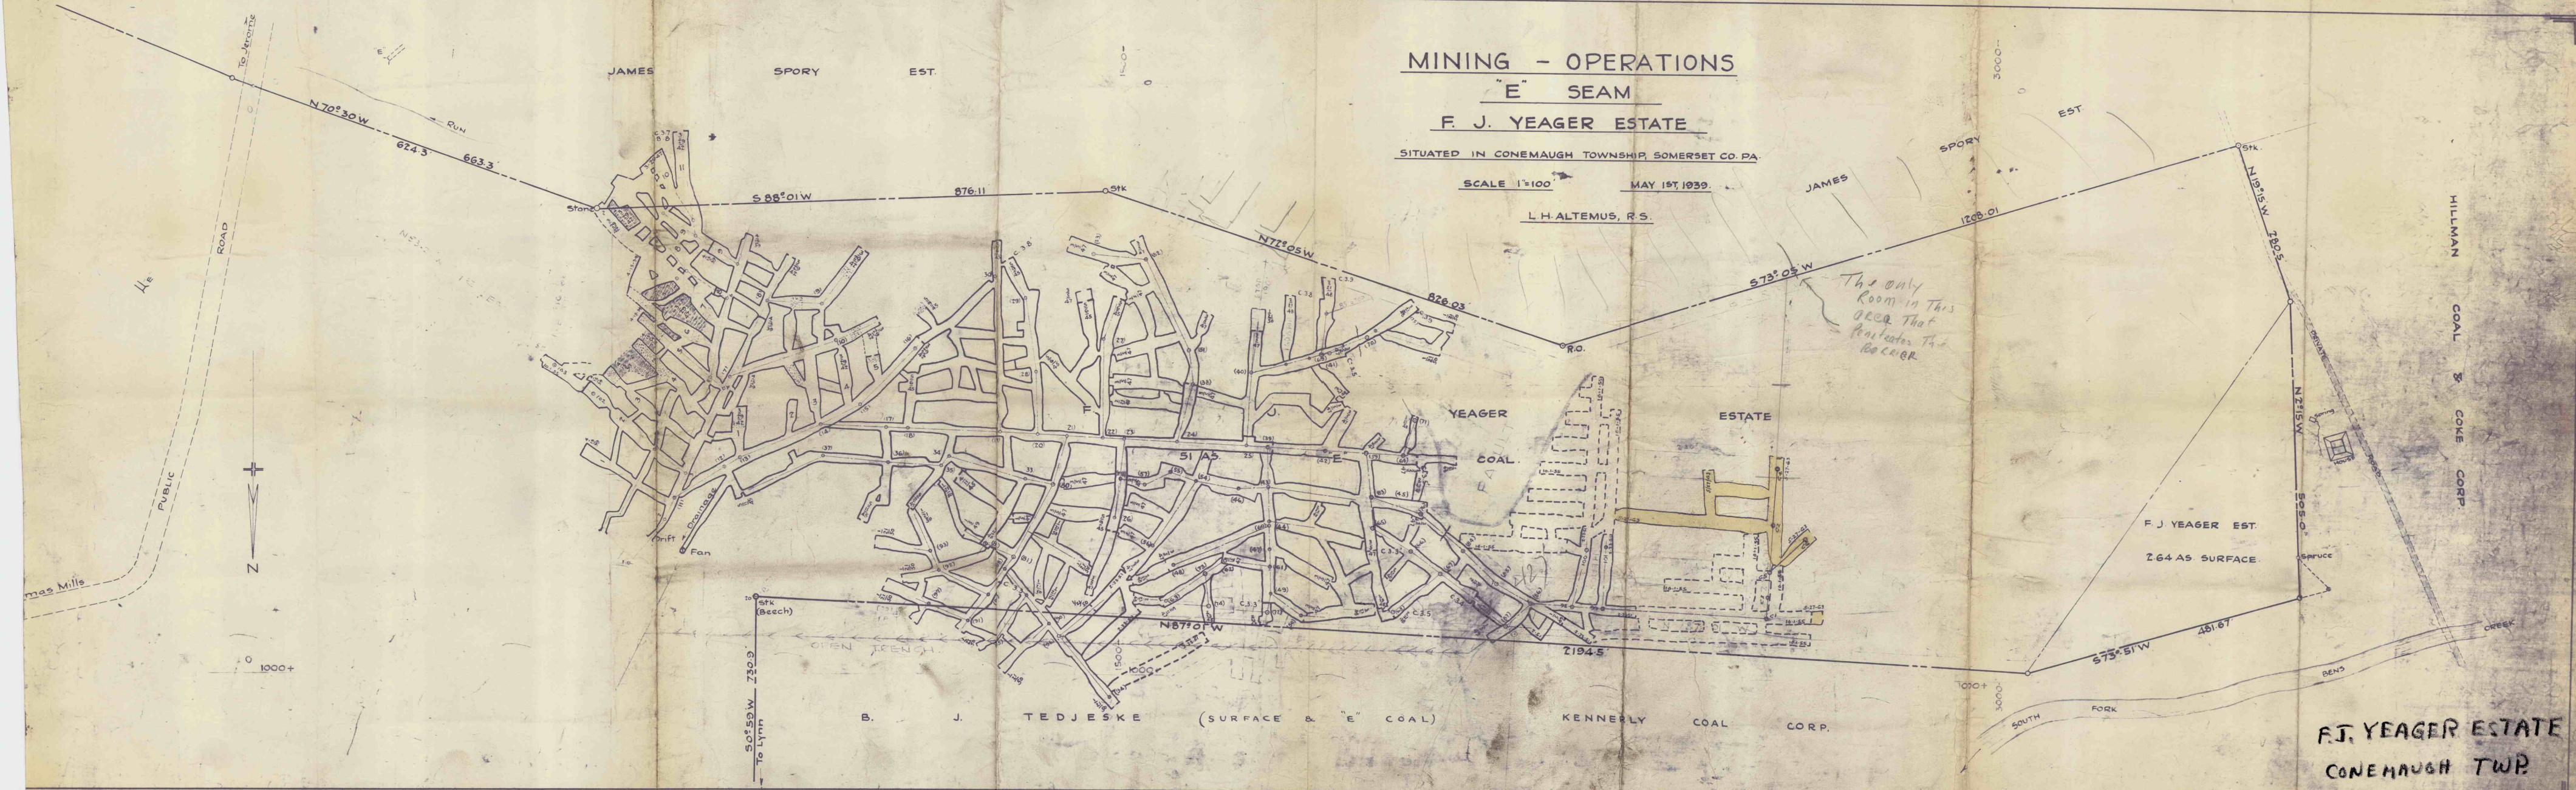

The only room in this area that penetrates the rockier

F. J. YEAGER ESTATE
CONEMAUGH TWP.