


STONES

RACHEL REED TRACT

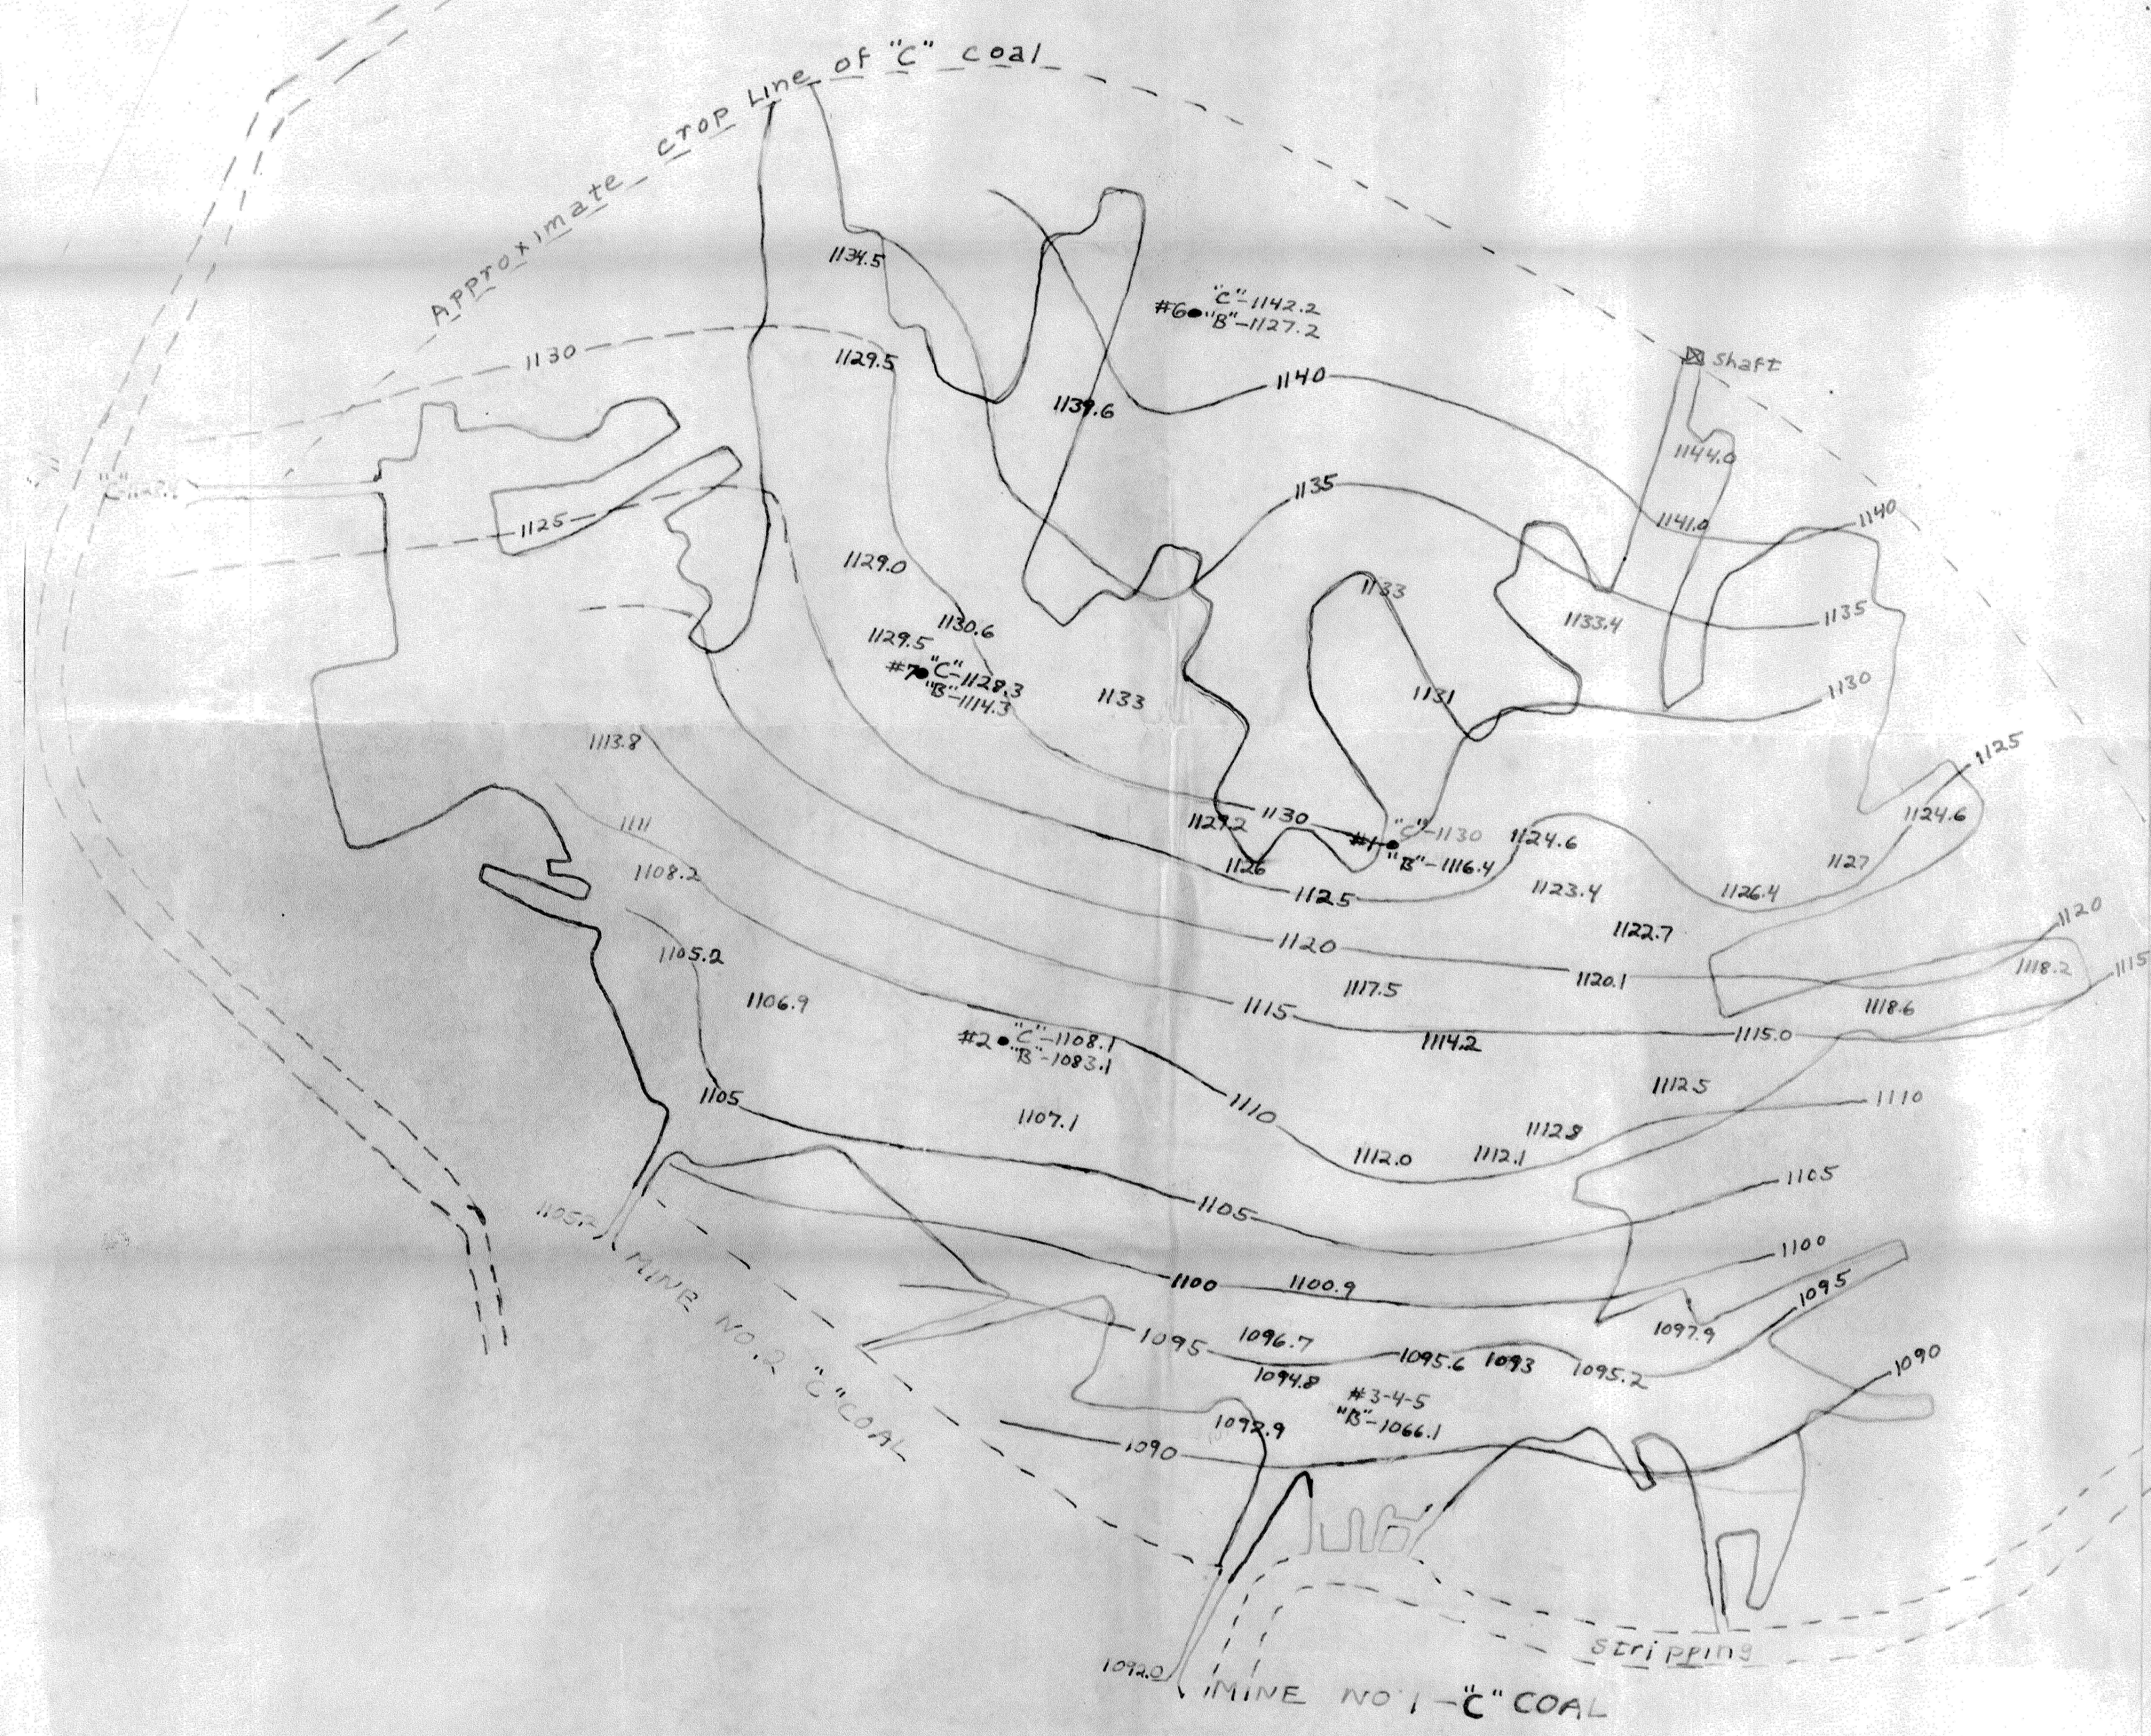

IRWIN HILL MINES
BIRGE RUN - CLINTON CO.
STOWE - FULLER REFRACTORIES CO.
1926

Structure Contours Added
to Map 12/7/44 - R.M.F. - Pa. Geol. Surv.

SCALE 100 FT = 1 INCH

0 100 200 FEET

#8 "B" - 1062.7
#8 "A" - 1038.2