

Clay and Coal workings

WEST BRANCH FIRE BRICK Co.

Renovo, Pa. INDEX NO. 26-2-6

Scale 10 ft. per inch


Boundaries from 1880 to 1885

Surveyed from 1880 to 1885

October, 1910

Paul P. Lyon

Surveyor

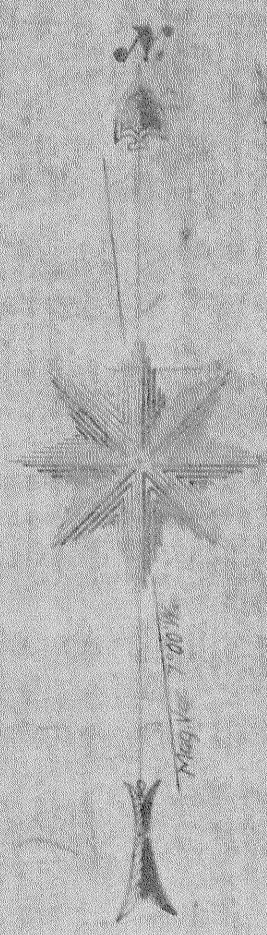

JOHN OLDDEN, No. 3890

JOHN OLDDEN, No. 3890

