


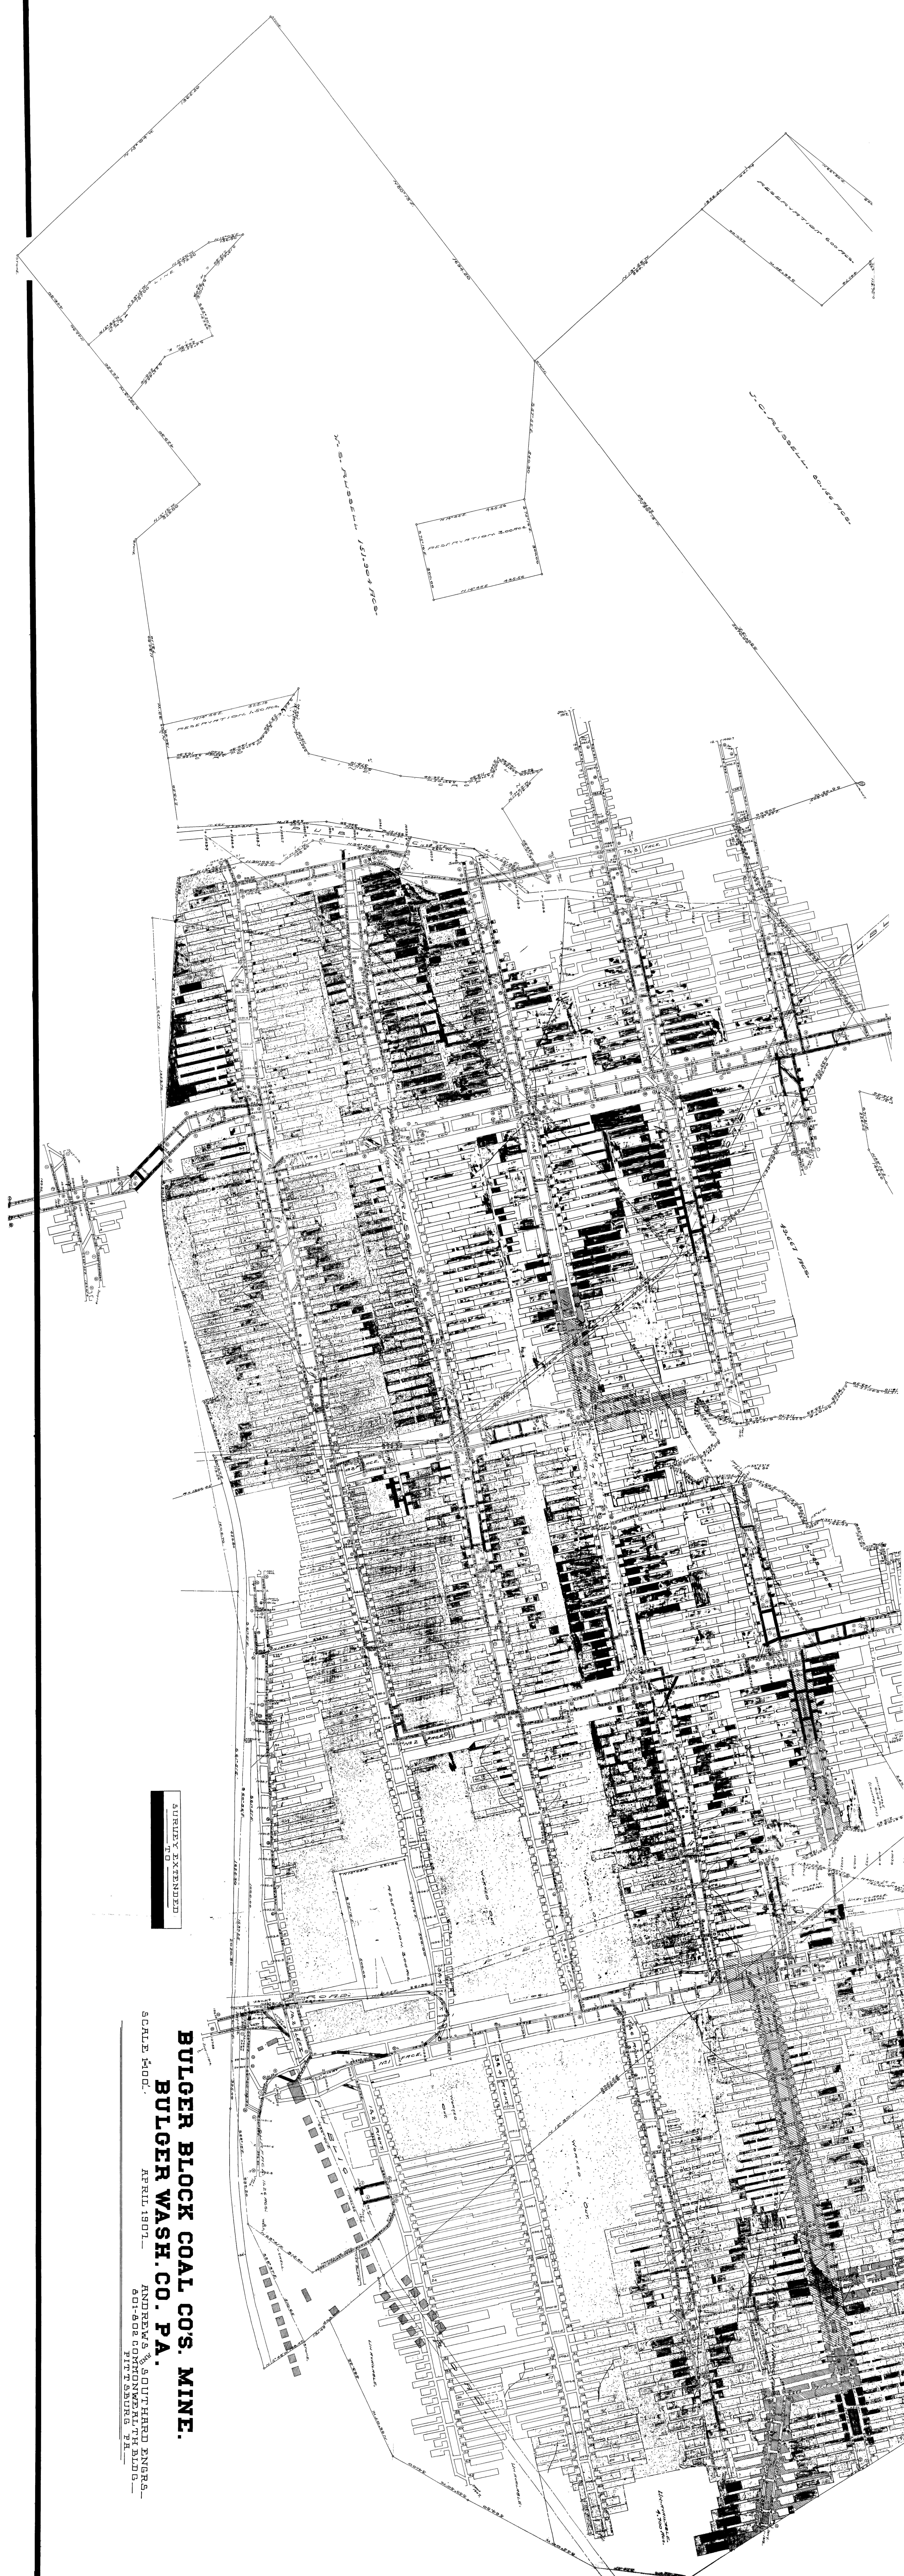

SURVEY EXTENDED
TO

BULGER BLOCK COAL COS. MINE.
BULGER WASH. CO. PA.
SCALE 1"=100'.
APRIL 1907.
ANDREW S. SOUTHWARD ENGINEER
601-602 COMMONWEALTH BLDG.
PITTSBURG, PA.