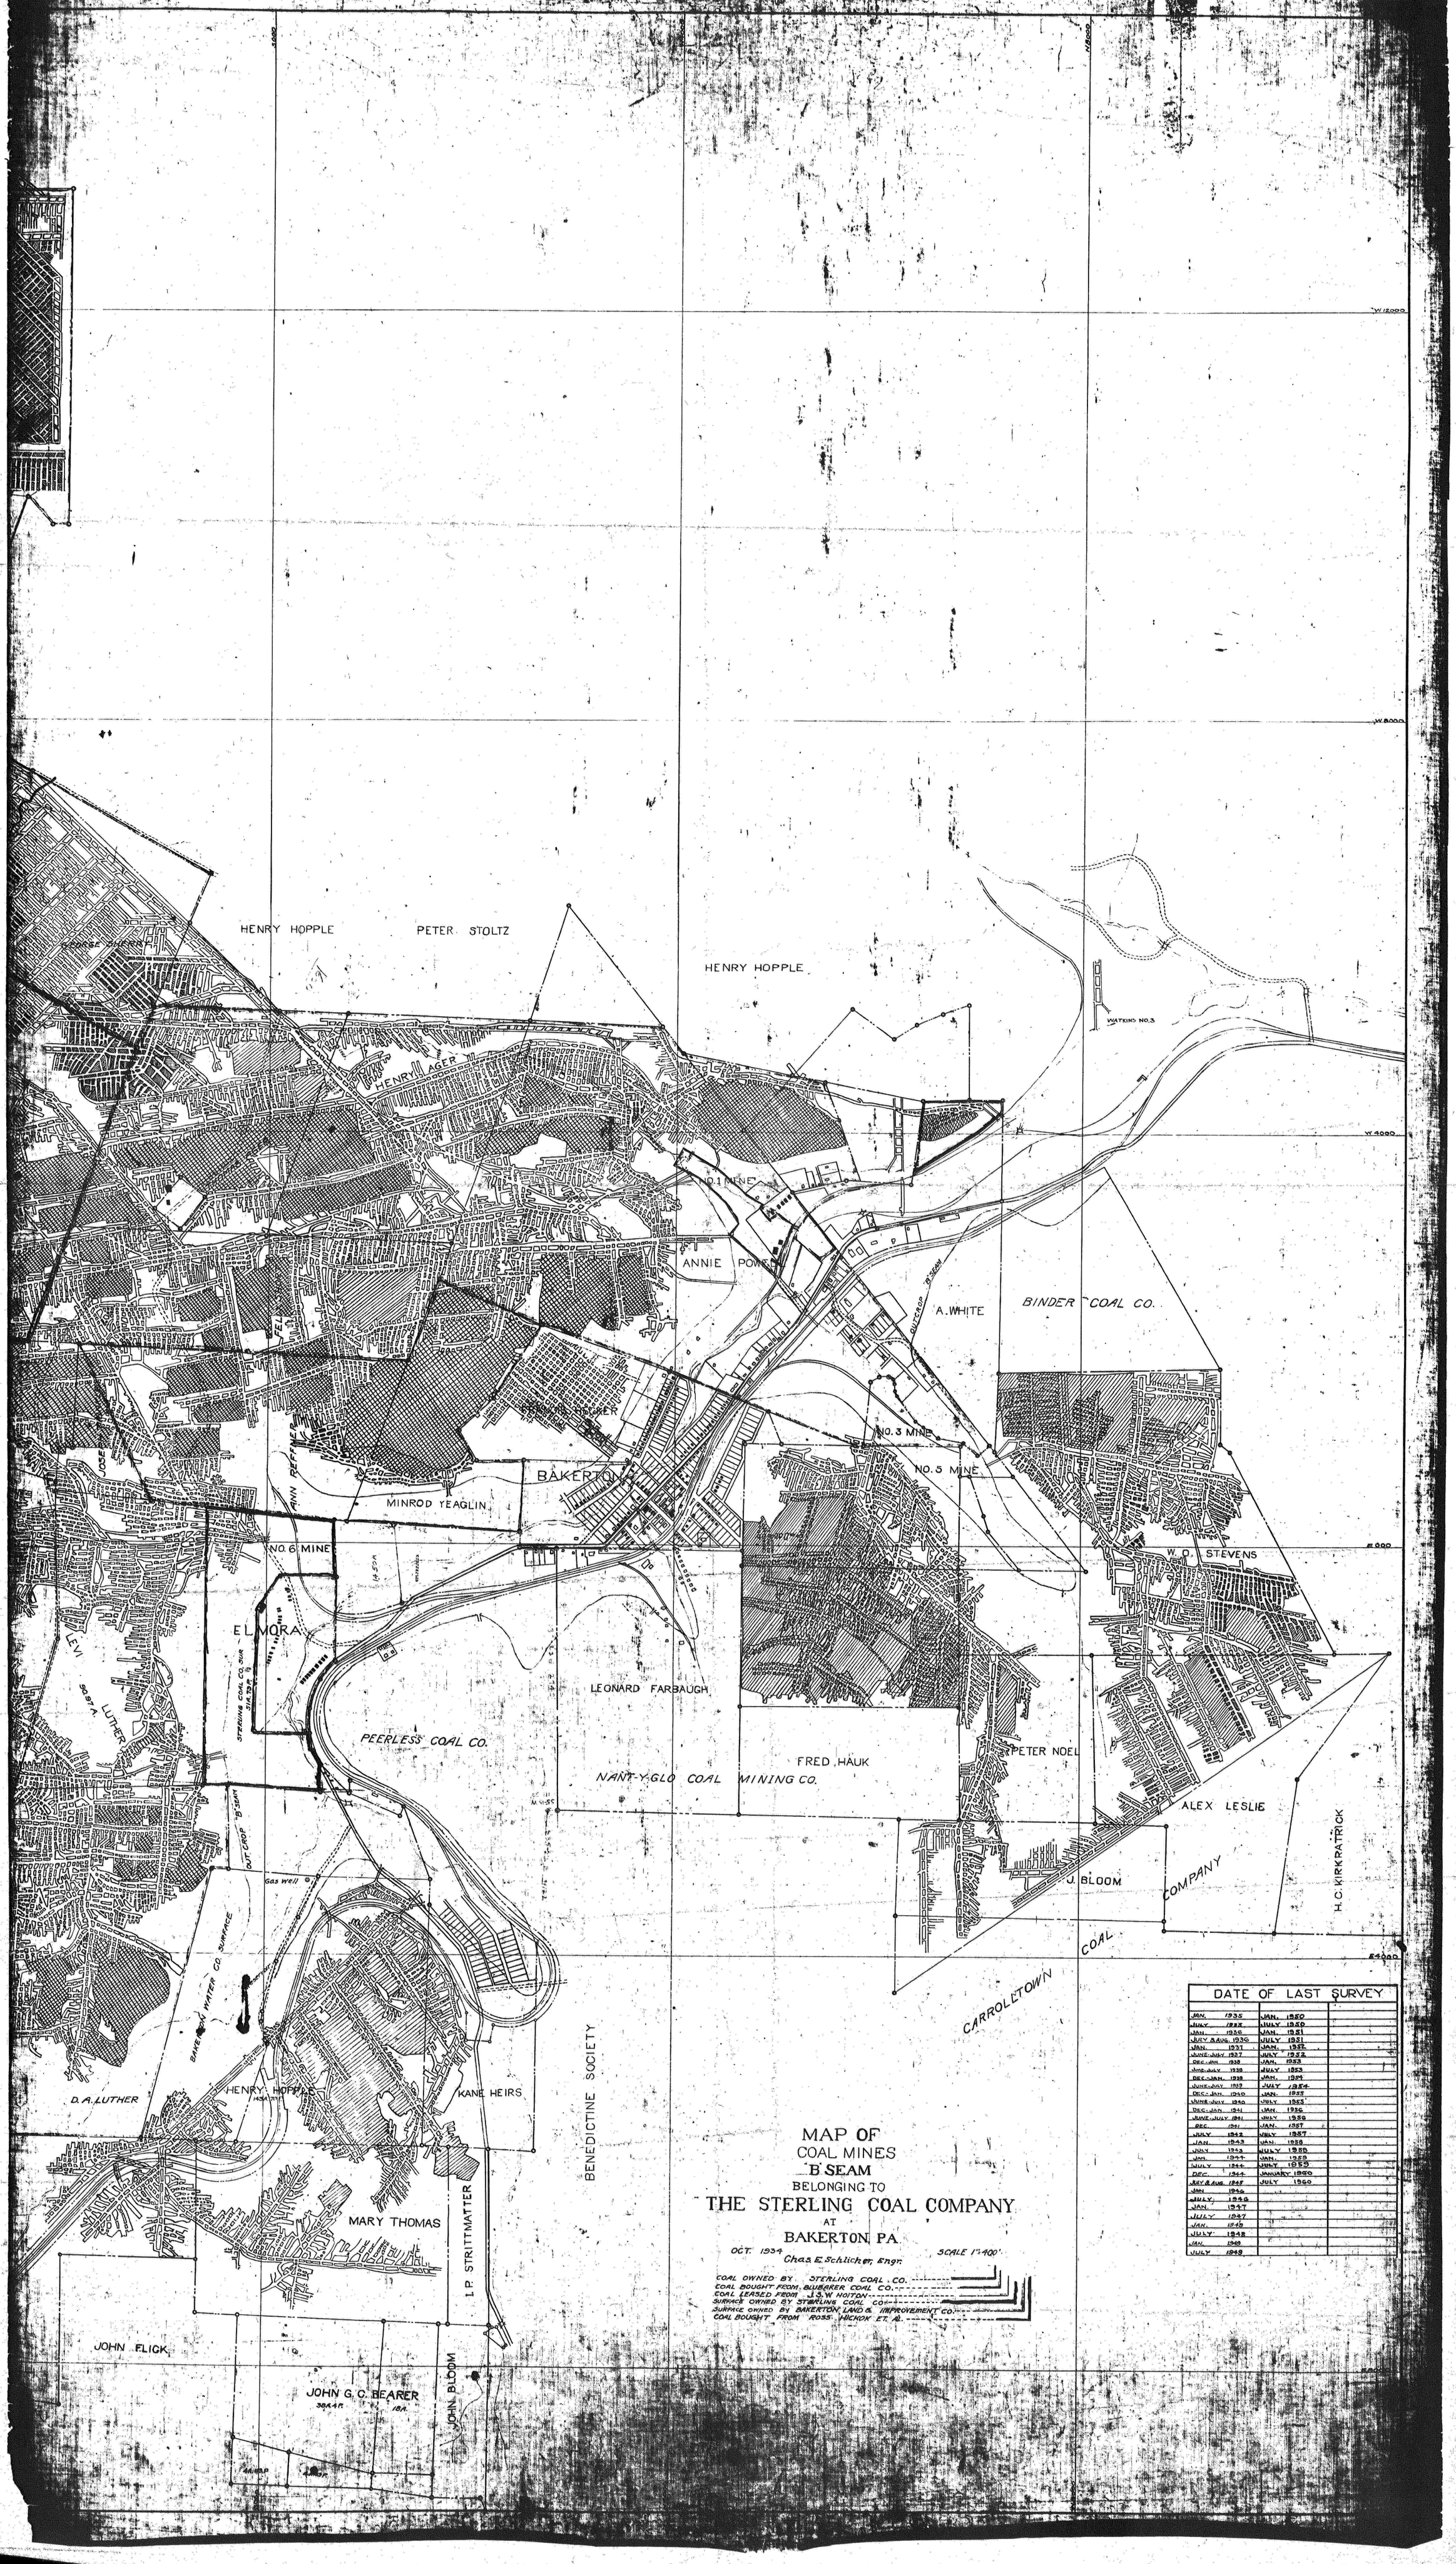
HENRY HOPPLE
PETER STOLTZ
HENRY HOPPLE
HENRY LAGER
WATKINS NO.3
NO.1 MINE
ANNIE POWELL
A. WHITE
BINDER COAL CO.
OUTCROP "B" SEAM
NO.3 MINE
NO.5 MINE
BAKERTON
MINROD YEAGLIN
NO.6 MINE
W. O. STEVENS
ELMORA
LEONARD FARBAUGH
PEERLESS COAL CO.
FRED HAUK
PETER NOEL
NANT-Y-GLO COAL MINING CO.
ALEX LESLIE
J. BLOOM
COMPANY
H. C. KIRKPATRICK
COAL
CARROLLTOWN
STERLING COAL CO. SUR.
STA. TOP
OUT CROP "B" SEAM
Gas well
BAKERTON WATER CO. SURFACE
D. A. LUTHER
HENRY HOPPLE
KANE HEIRS
BENEDICTINE SOCIETY
MARY THOMAS
I. P. STRITTMATTER
JOHN FLICK
JOHN G. C. BEARER
JOHN BLOOM
W 12000
W 8000
W 4000
E 000
E 4000
DATE OF LAST SURVEY
JAN. 1935 — JAN. 1950
JULY 1935 — JULY 1950
JAN. 1936 — JAN. 1951
JULY & AUG. 1936 — JULY 1951
JAN. 1937 — JAN. 1952
JUNE-JULY 1937 — JULY 1952
DEC-JAN 1938 — JAN. 1953
JUNE-JULY 1938 — JULY 1953
DEC.-JAN. 1939 — JAN. 1954
JUNE-JULY 1939 — JULY 1954
DEC.-JAN. 1940 — JAN. 1955
JUNE-JULY 1940 — JULY 1955
DEC.-JAN. 1941 — JAN. 1956
JUNE-JULY 1941 — JULY 1956
DEC. 1941 — JAN. 1957
JULY 1942 — JULY 1957
JAN. 1943 — JAN. 1958
JULY 1943 — JULY 1958
JAN. 1944 — JAN. 1959
JULY 1944 — JULY 1959
DEC. 1944 — JANUARY 1960
JULY & AUG. 1945 — JULY 1960
JAN. 1946
JULY 1946
JAN. 1947
JULY 1947
JAN. 1948
JULY 1948
JAN. 1949
JULY 1949
MAP OF
COAL MINES
"B" SEAM
BELONGING TO
THE STERLING COAL COMPANY
AT
BAKERTON PA.
OCT. 1934
Chas. E. Schlicher, Engr.
SCALE 1" = 400'
COAL OWNED BY STERLING COAL CO.
COAL BOUGHT FROM BLUBARER COAL CO.
COAL LEASED FROM J. S. W. HOITON
SURFACE OWNED BY STERLING COAL CO.
SURFACE OWNED BY BAKERTON LAND & IMPROVEMENT CO.
COAL BOUGHT FROM ROSS HICKOK ET. AL.