


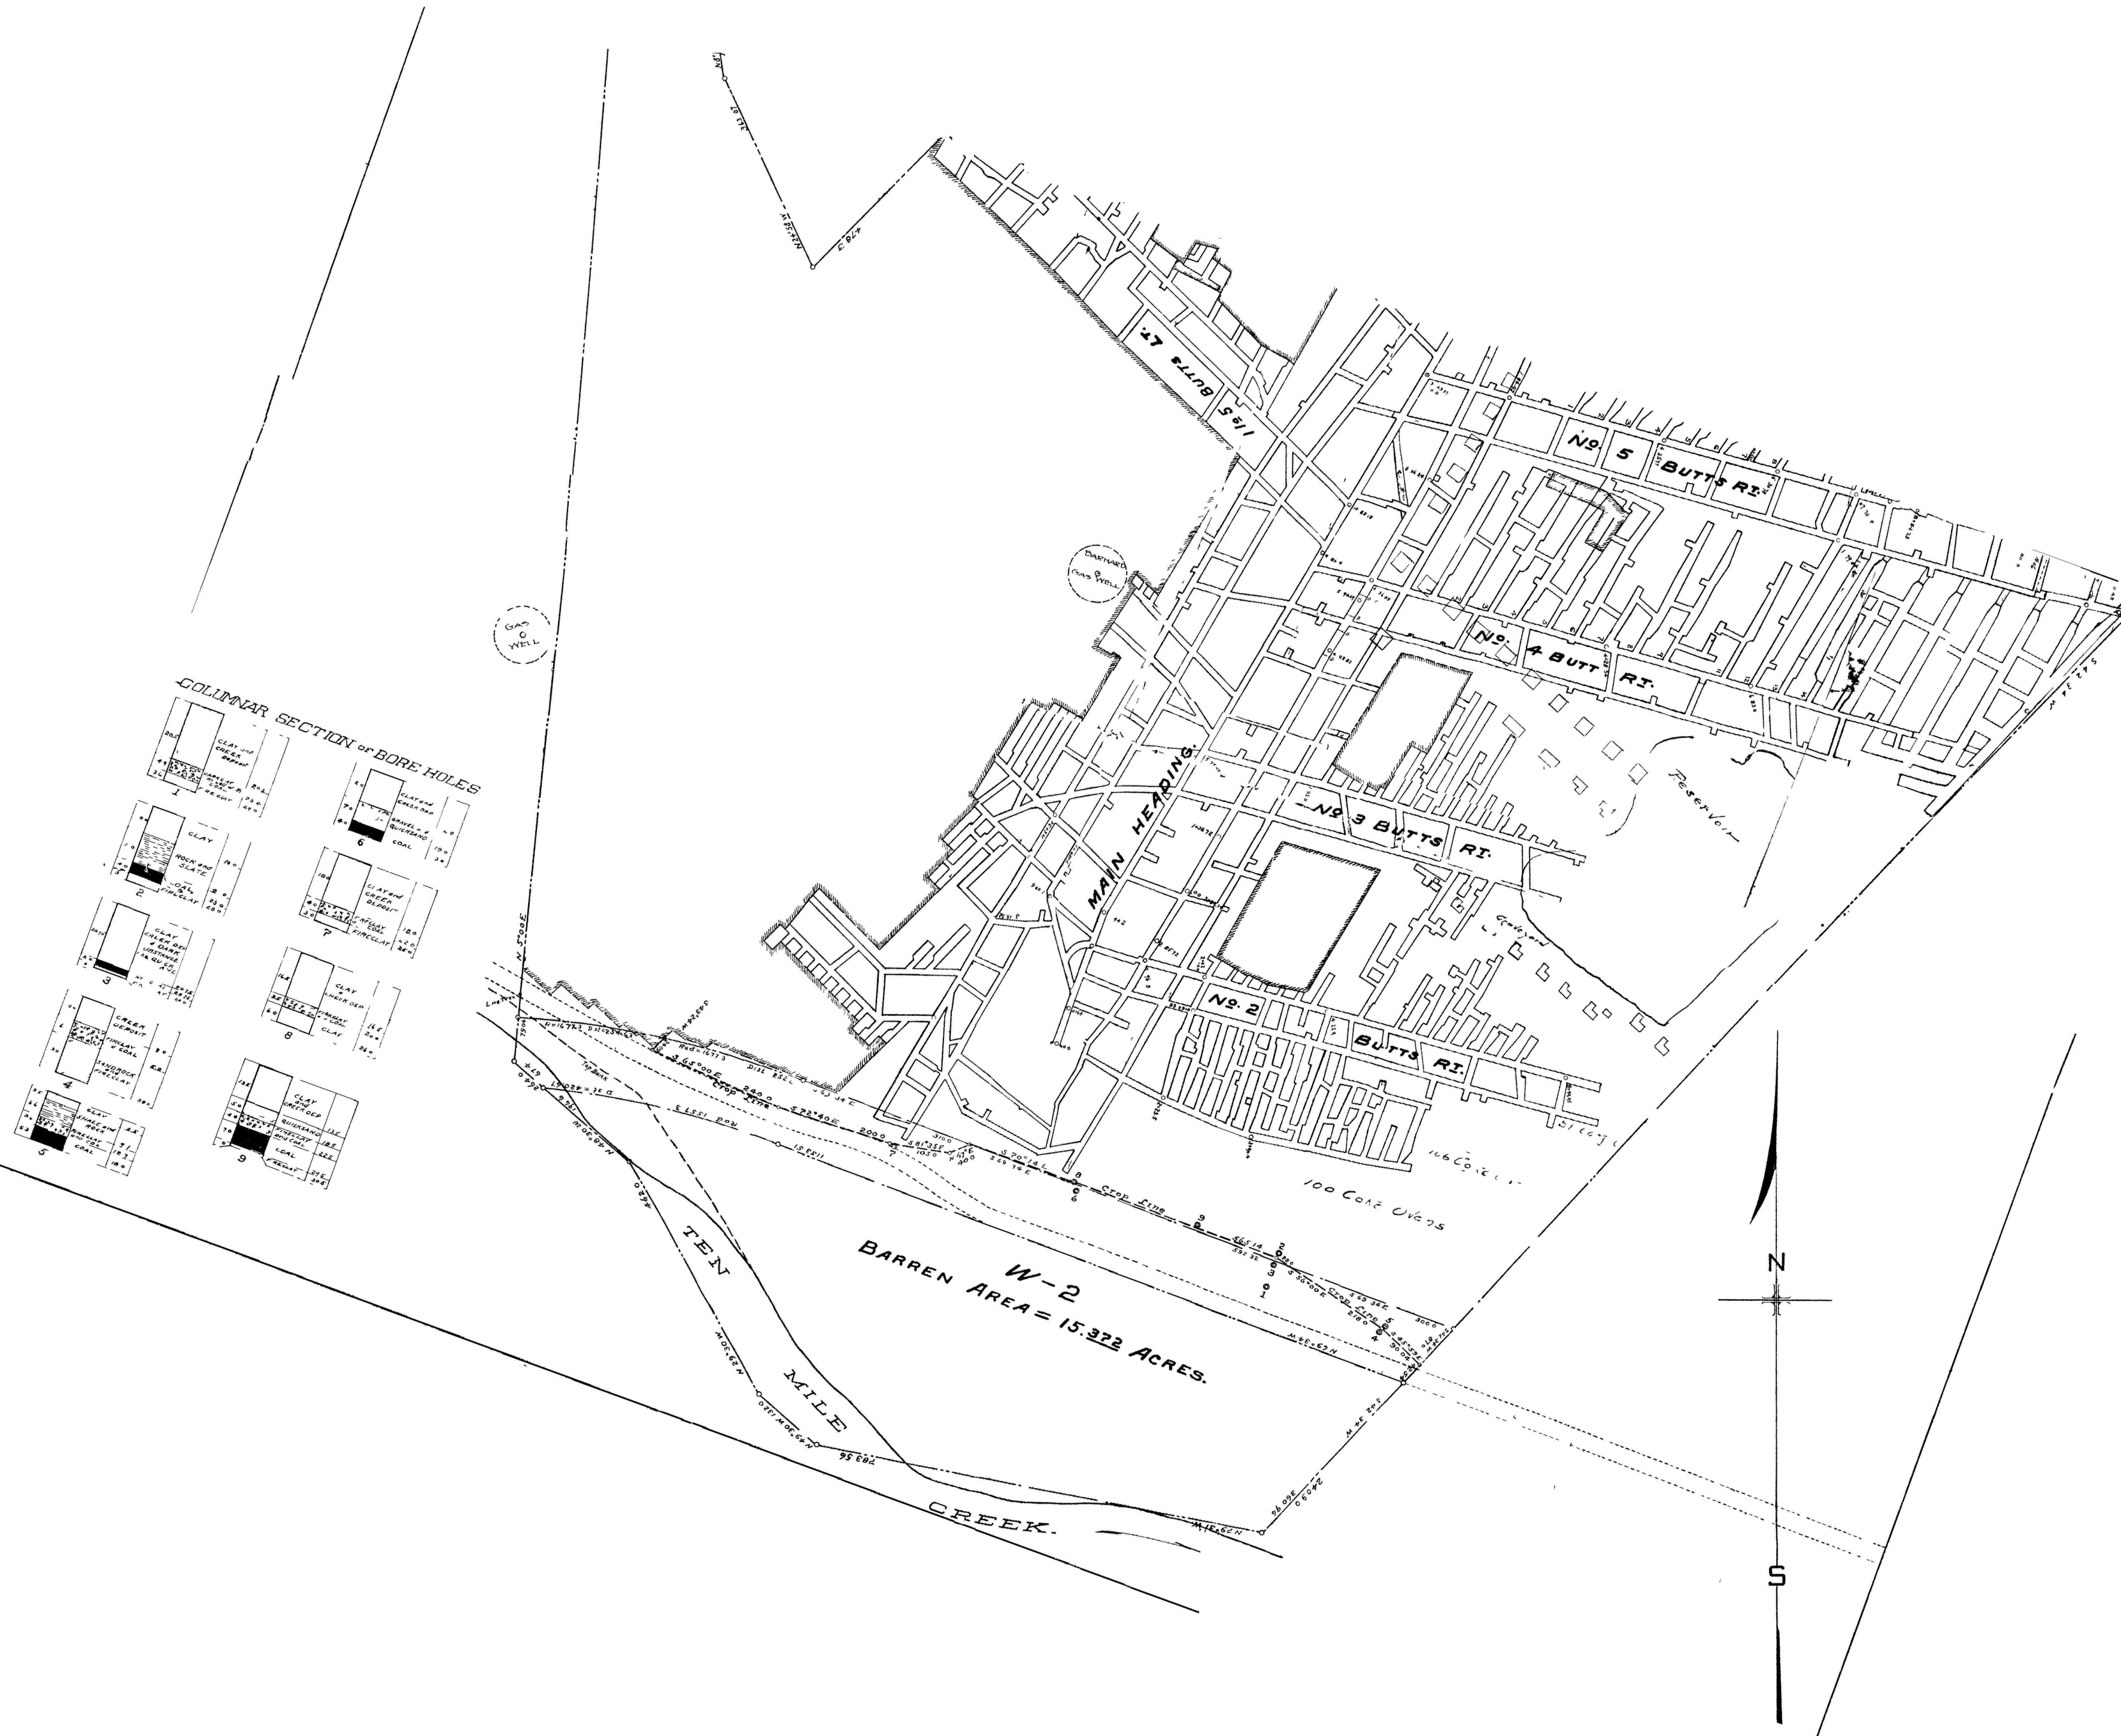

CALL

SITUATE IN

EAST BETHELEHEM TWP., WASHINGTON COUNTY, PA.

SCALE - 1" = 100 FT

FEBRUARY 1914.

