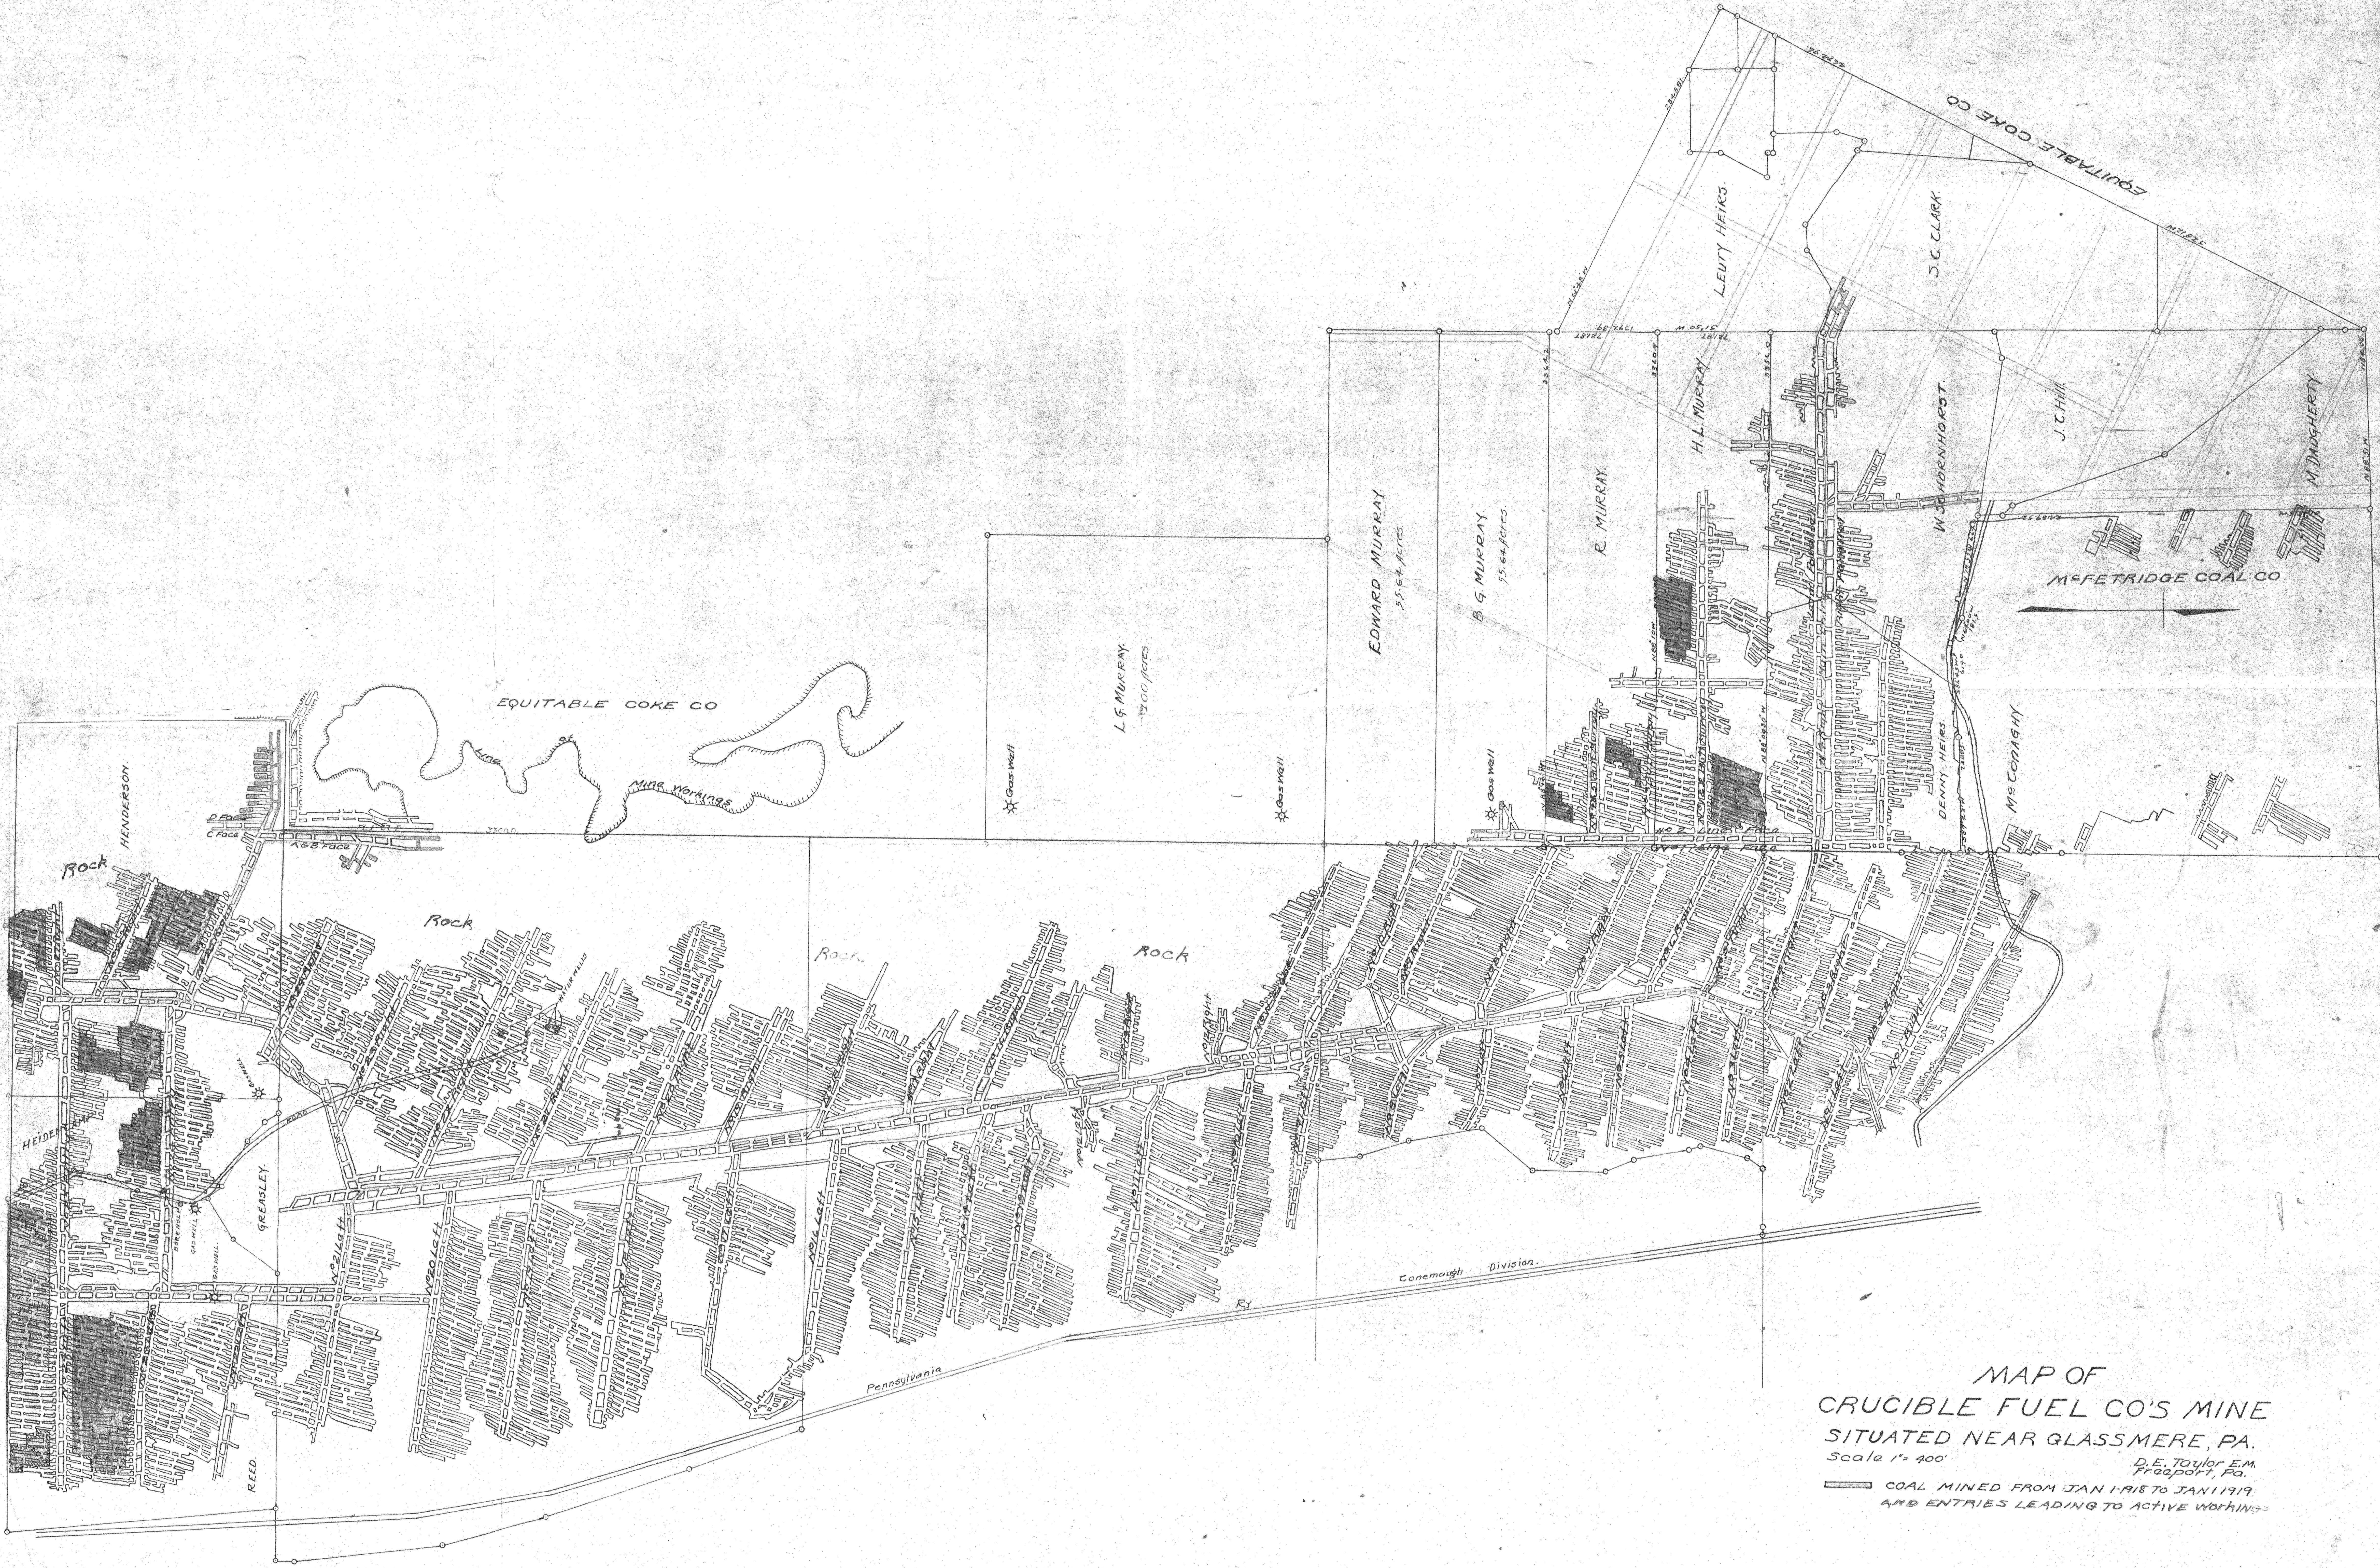
EQUITABLE COKE CO
Line of Mine Workings
EQUITABLE COKE CO.
4678.76
2345.81
5281 W
N61°48'W
1392.39
72187
N 05.15 W
3364.2
3360.9
3356.0
1184.06
N88°51'W
3300.0
LEUTY HEIRS.
S.C. CLARK.
H.L. MURRAY
W.J. HORNHORST.
J.C. Hill
M. DAUGHERTY
R. MURRAY.
B.G. MURRAY
55.64 Acres.
EDWARD MURRAY
55.64 Acres.
L.G. MURRAY.
100 Acres
Gas Well
Gas Well
Gas Well
McFETRIDGE COAL CO
N88°10'W
N88°09'30"W
DENNY HEIRS.
McCONAGHY
No 2 Line Face
No 1 Line Face
HENDERSON.
D Face
C Face
A&B Face
Rock
Rock
Rock
Rock
HEIDEN
GREASLEY.
REED.
GAS WELL
BORE HOLE
GAS WELL
GAS WELL
WATER WELLS
ROAD
No 21 Left
No 20 Left
No 16 Left
No 17 Left
No 15 Left
No 14 Left
No 12 Left
No 11 Left
No 10 Left
No 12 Right
No 13 Right
No 9 Right
No 8 Right
No 7 Right
No 6 Right
No 5 Right
No 4 Right
No 3 Right
No 2 Right
No 1 Right
No 7 Left
No 6 Left
No 5 Left
No 4 Left
No 3 Left
No 2 Left
No 1 Left
Pennsylvania
Ry
Conemaugh Division.

MAP OF
CRUCIBLE FUEL CO'S MINE
SITUATED NEAR GLASSMERE, PA.
Scale 1" = 400'

D.E. Taylor E.M.
Freeport, Pa.

▭ COAL MINED FROM JAN 1-1918 TO JAN 1 1919
AND ENTRIES LEADING TO ACTIVE WORKINGS