


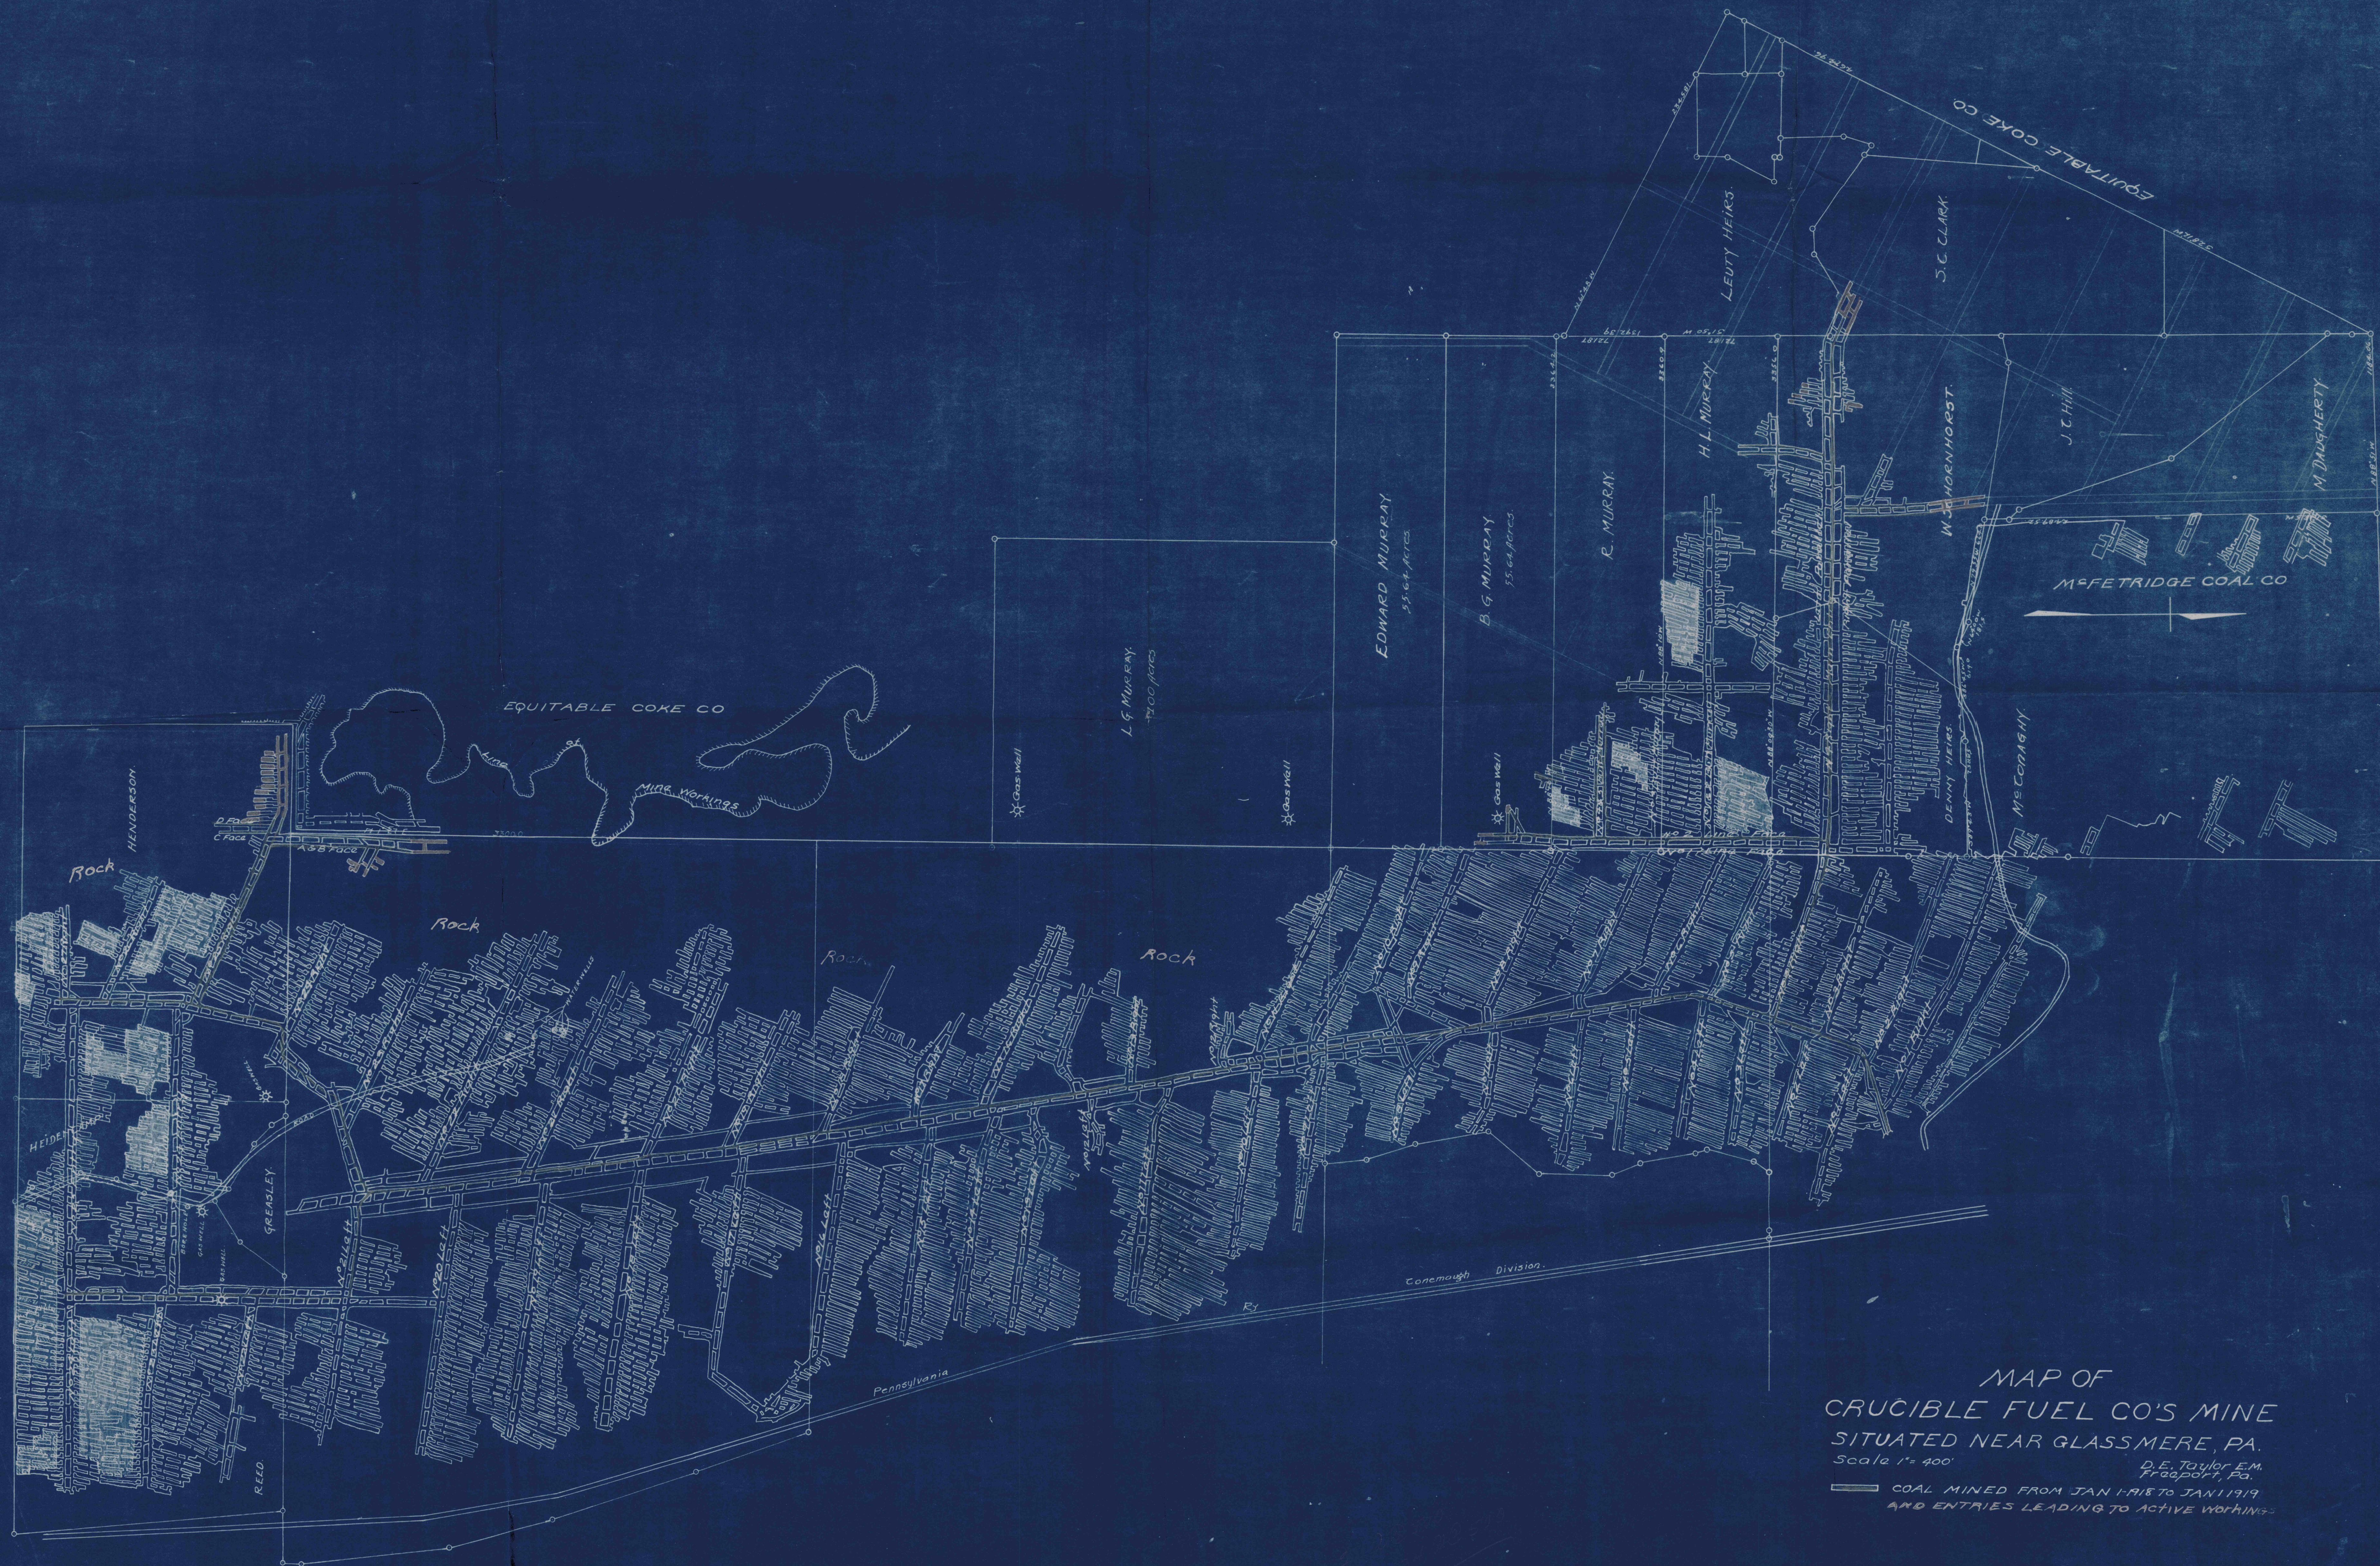

MAP OF
CRUCIBLE FUEL CO'S MINE
SITUATED NEAR GLASSMERE, PA.
Scale 1" = 400'
D. E. TAYLOR, E.M.
COAL MINED FROM JAN 1-18 TO JAN 1-19
AND ENTRIES LEADING TO ACTIVE WORKINGS