


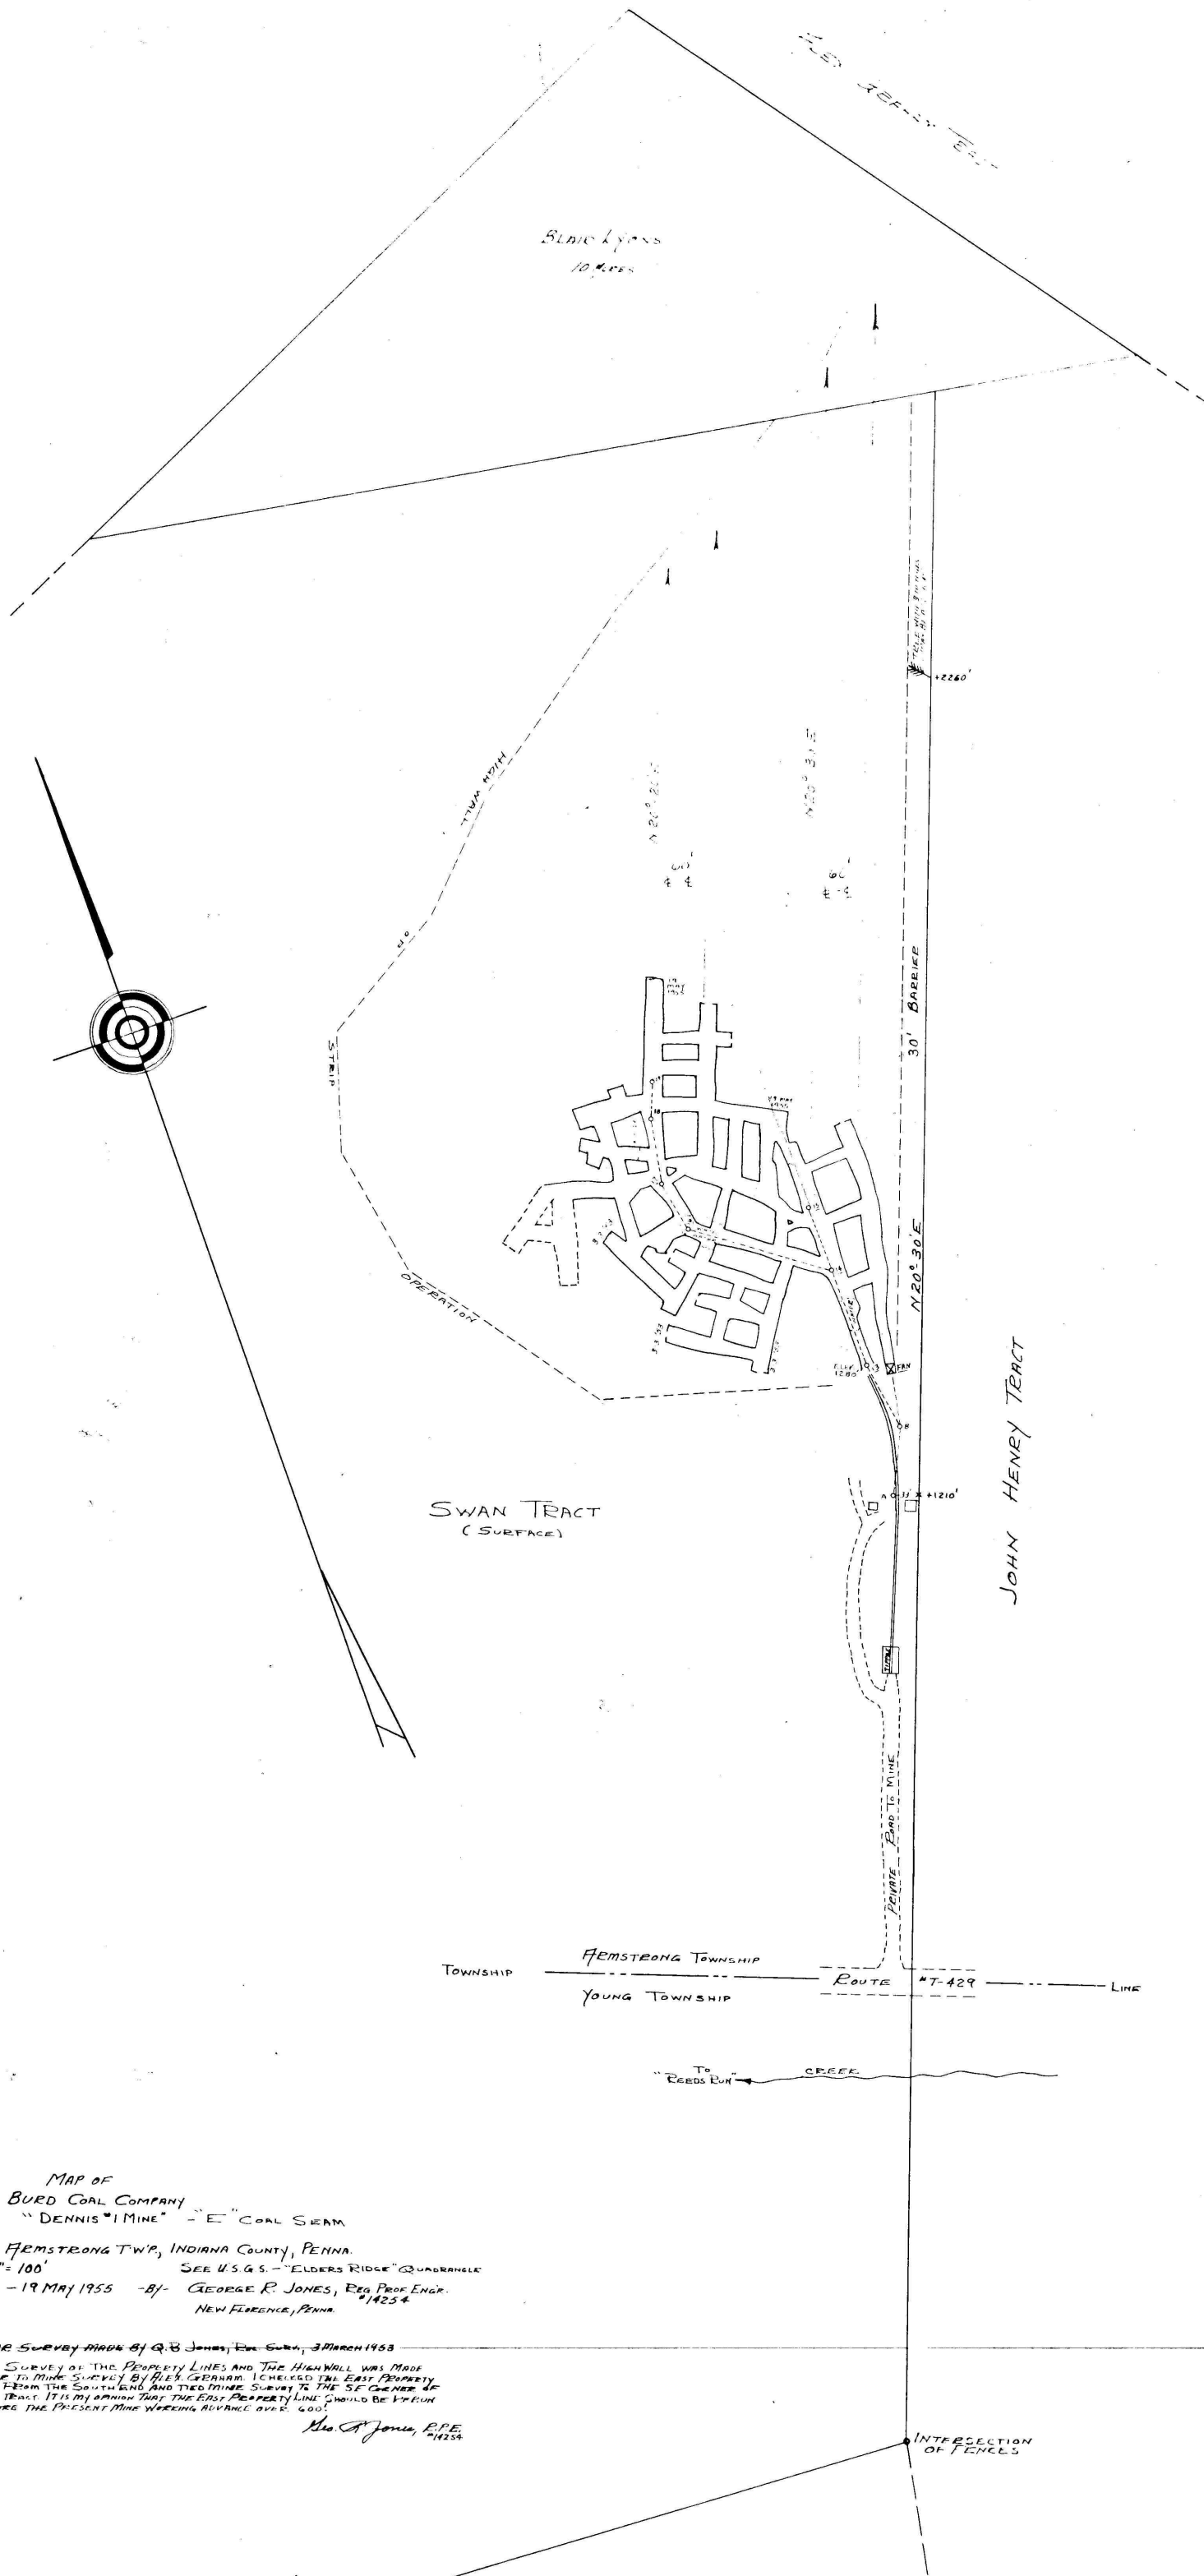

MAP OF
BURD COAL COMPANY
"DENNIS" MINE - "E" COAL SEAM

SITUATE - FEMSTRONG TWP, INDIANA COUNTY, PENNA.
SCALE - 1" = 100' SEE U.S.G.S. - "ELDERS RIDGE" QUADRANGLE
SURVEYED - 19 MAY 1955 - BY - GEORGE R. JONES, REG. PROF. ENGR. #14254
NEW FLORENCE, PENNA.

NOTE: PRIOR SURVEY MADE BY G. B. JONES, REG. SURV., 3 MARCH 1953
THE SURVEY OF THE PROPERTY LINES AND THE HIGH WALL WAS MADE
PRIOR TO MINE SURVEY BY ALEX. GRAHAM. I CHECKED THE EAST PROPERTY
LINE FROM THE SOUTH END AND TIED MINE SURVEY TO THE SE CORNER OF
THE TRACT. IT IS MY OPINION THAT THE EAST PROPERTY LINE SHOULD BE KEPT
BEFORE THE PRESENT MINE WORKING ADVANCE OVER 600'.

Geo. R. Jones, P.P.E.
#14254