


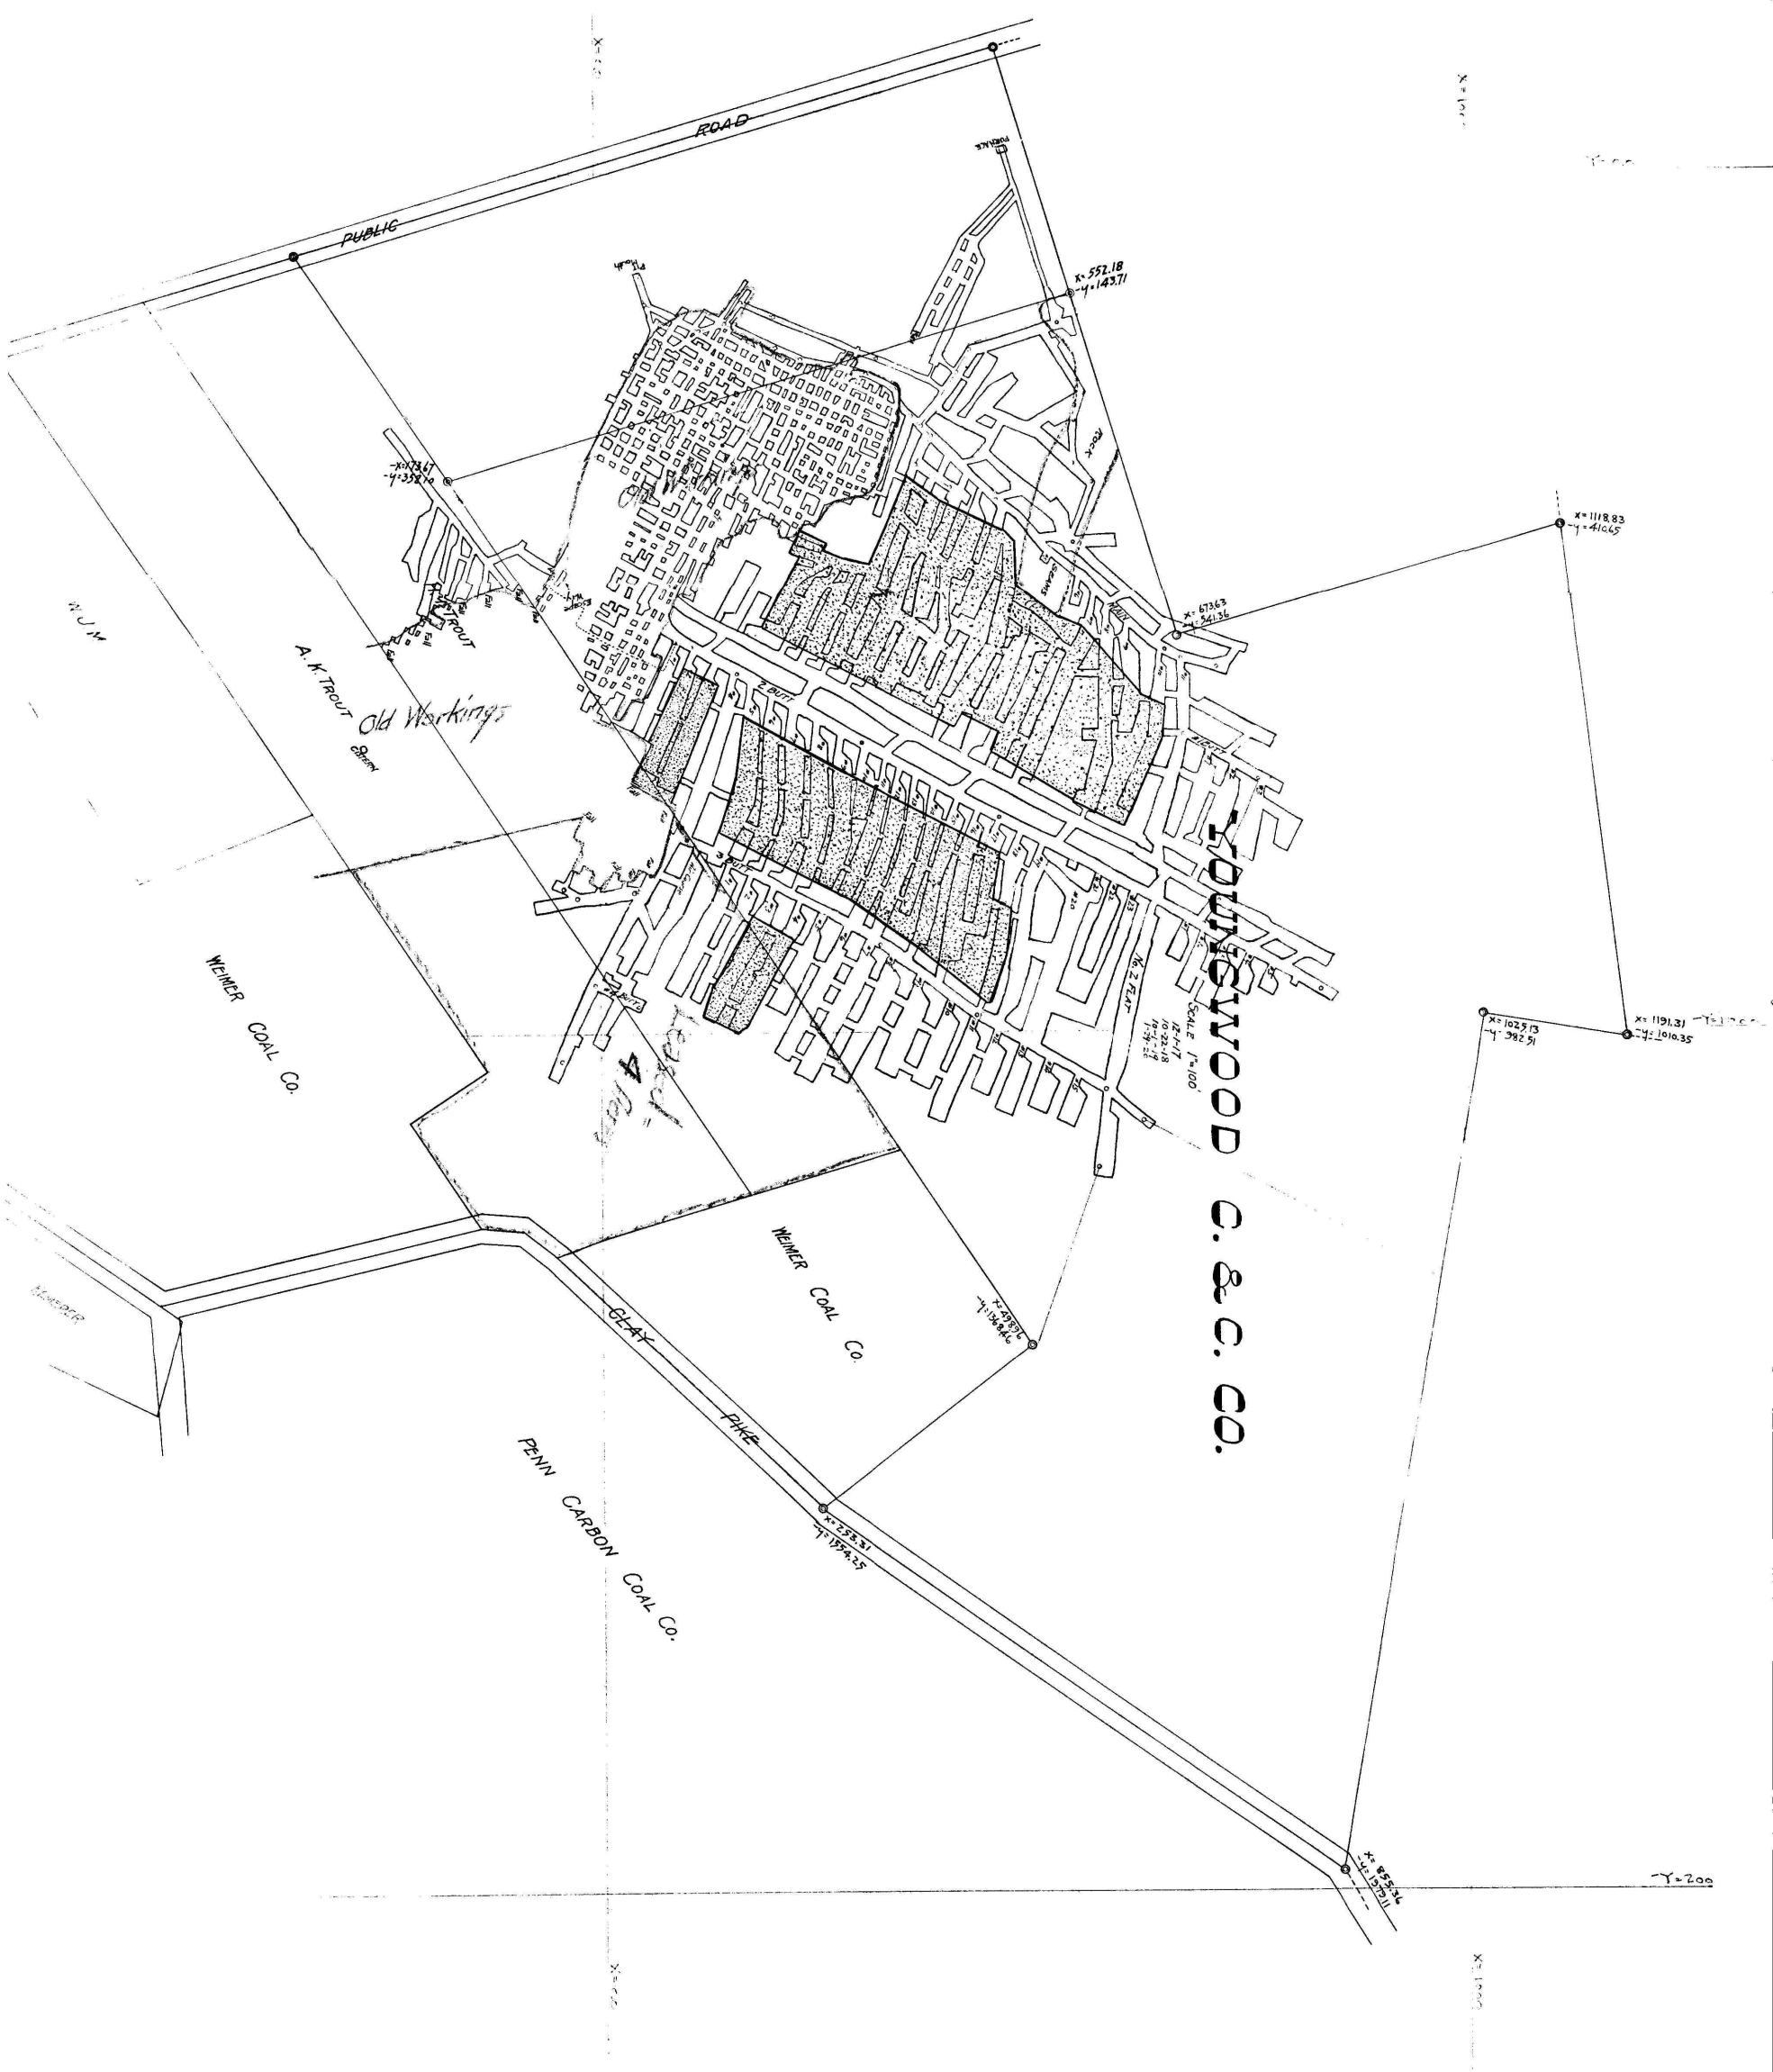

PUBLIC ROAD

X=552.18
Y=143.71

X=736.7
Y=352.1

A. K. Trout
Old Workings

WEIMER COAL Co.

YOUNGWOOD C. & C. CO.

SCALE 1"=100'
N. 27.5° E.
1032.18
19.45.19
17.51.23

WEIMER COAL Co.

GLAY

PINE

PENN CARBON COAL Co.



X=1118.83
Y=410.65

X=1023.13
Y=382.51

X=1191.31
Y=1010.35

X=855.1
Y=137.11

Y=200