


MAP OF
LARIMER GAS COAL CO

SCALE 1"=100'

W. W. Walker, Eng'r

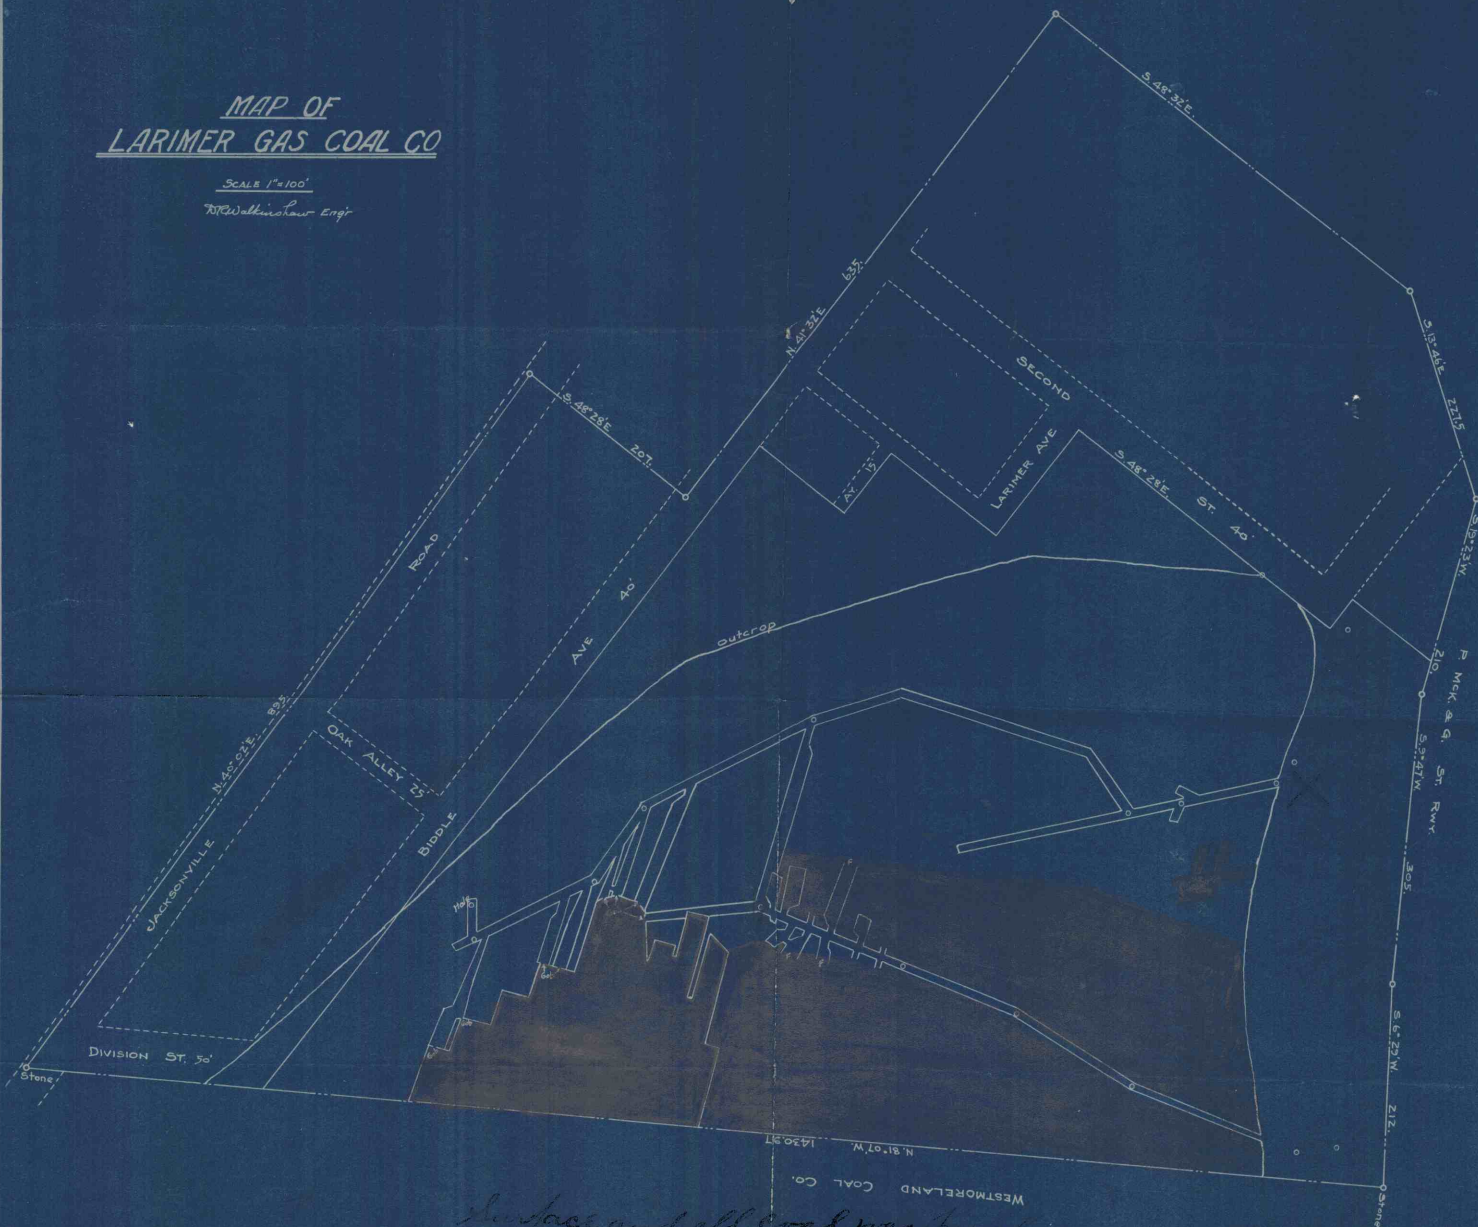

Surface and all coal was purchased on actual
acreage given, but when we opened it mark
X and developed main entry, rediposed
coal was found and been moved off Westmoreland
Coal Co. since that time, from 1900