


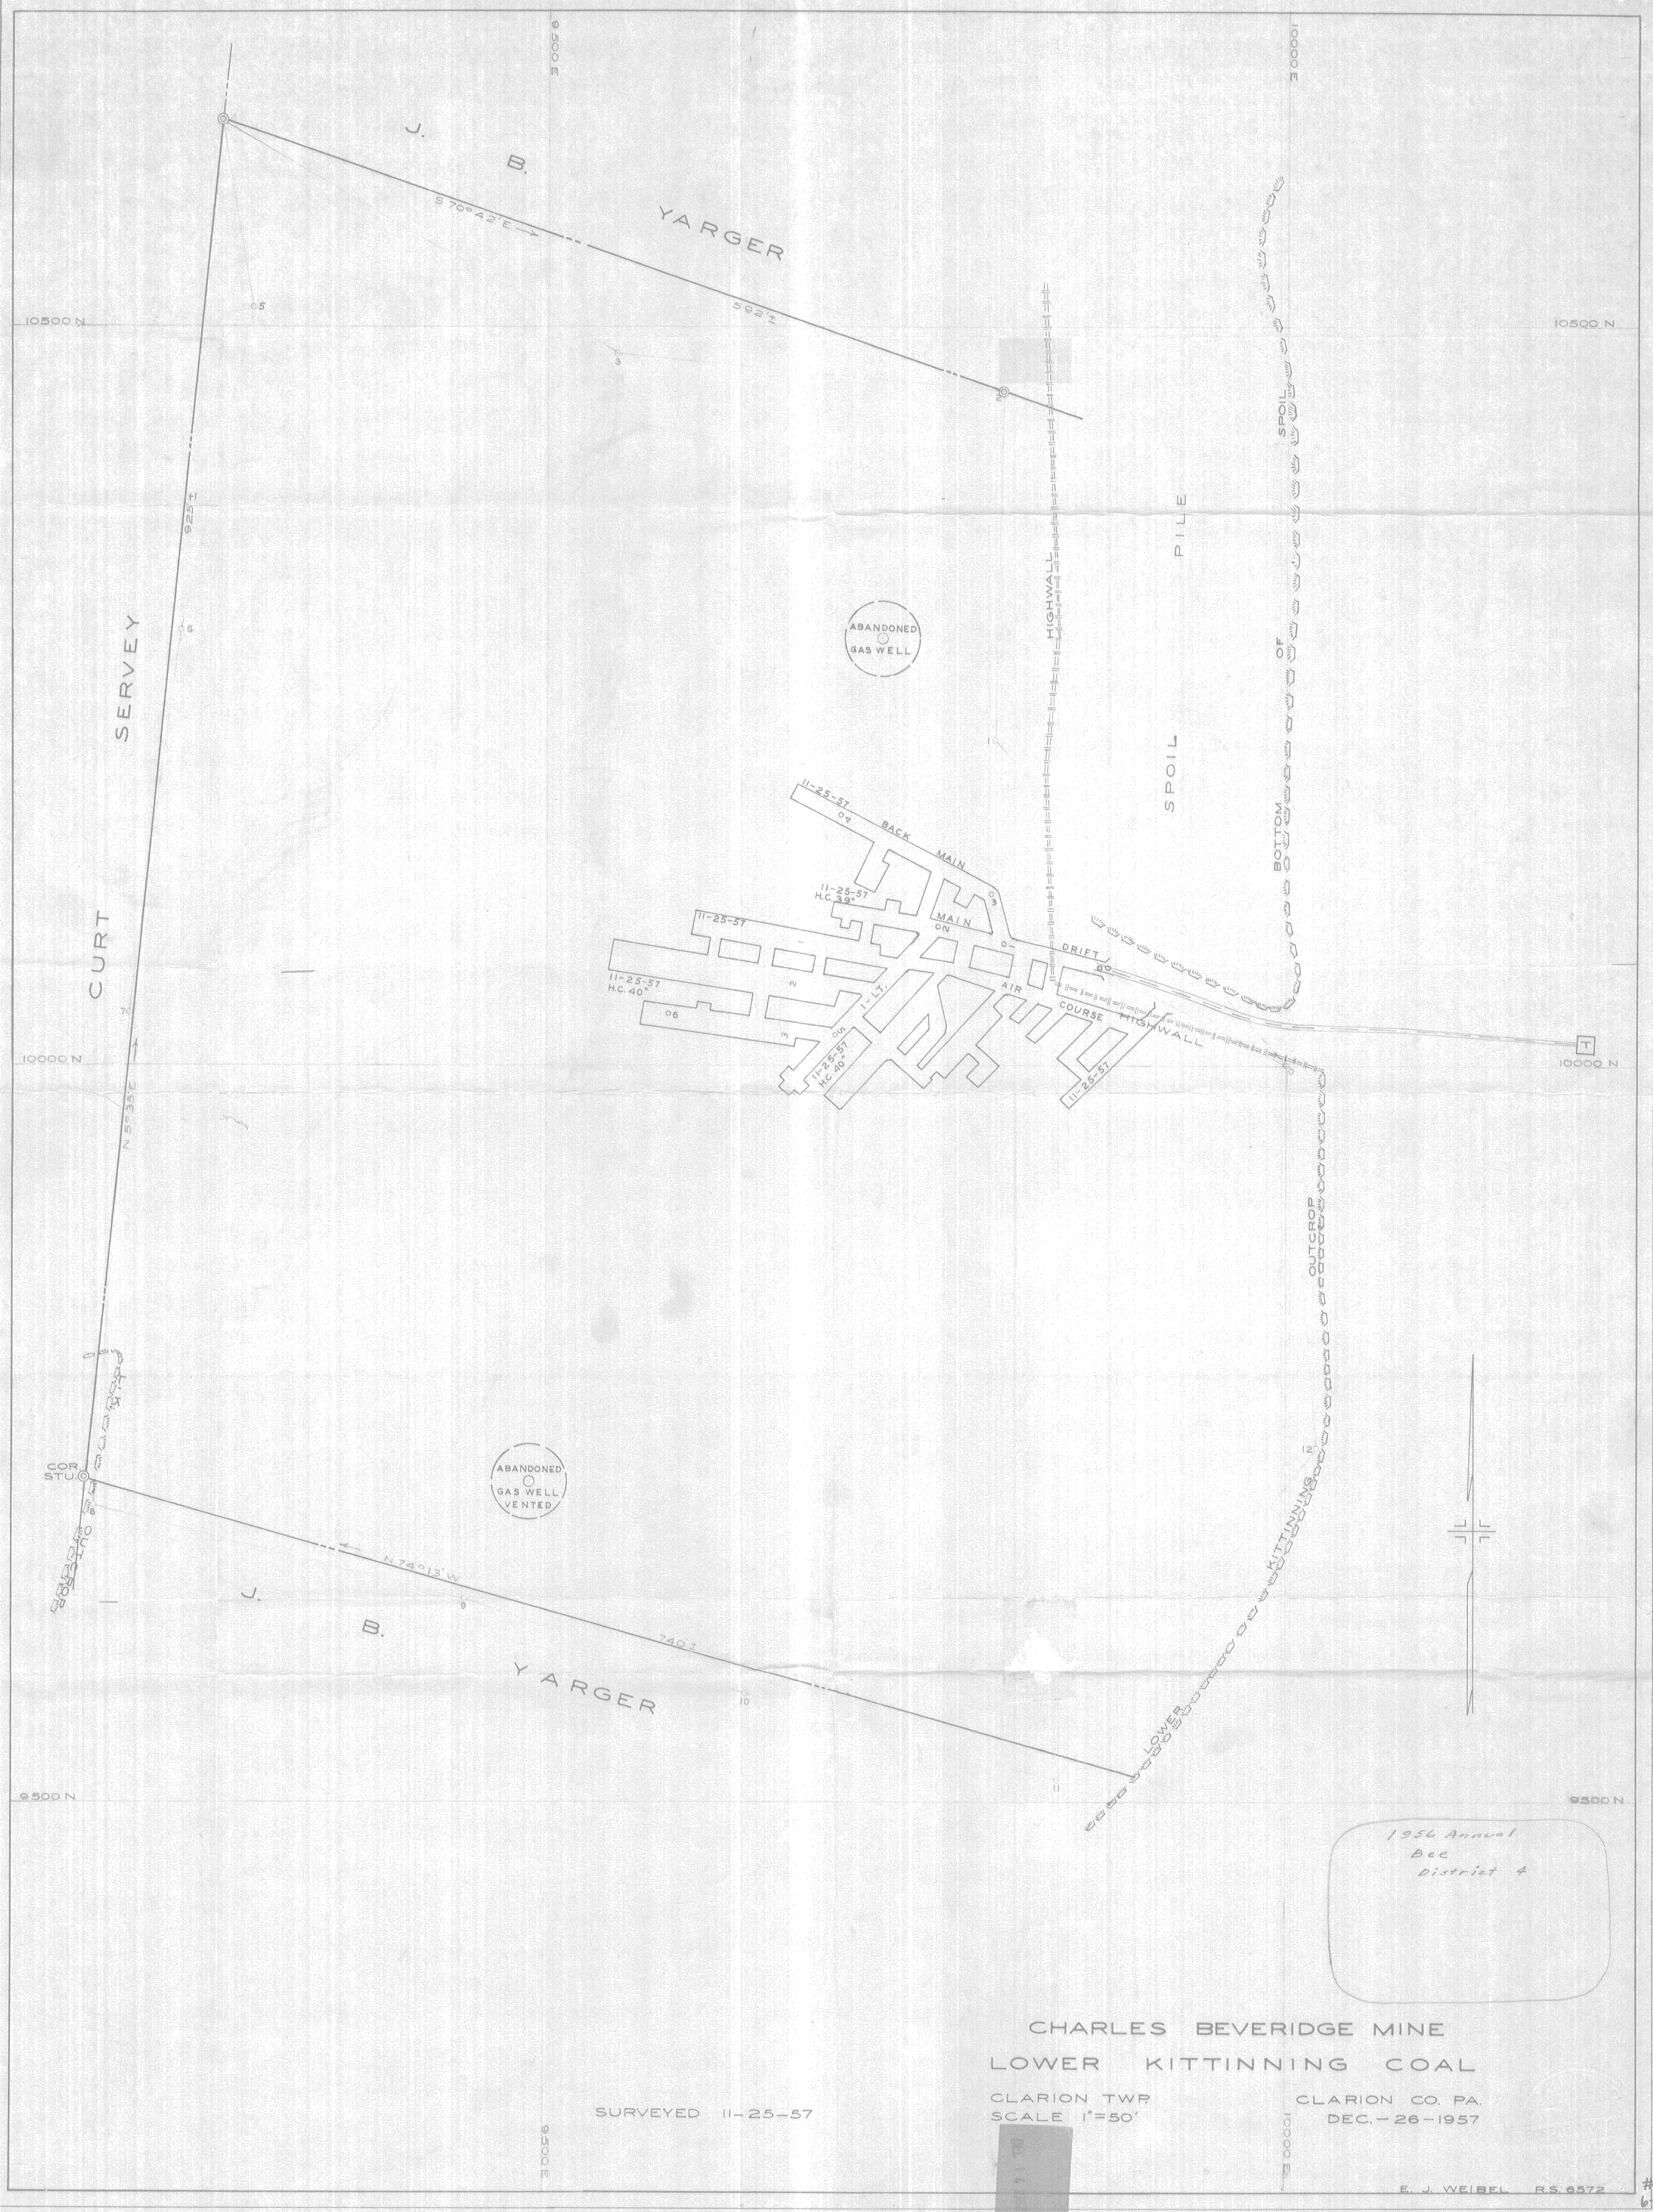

1956 Annual
Bec
District 4

CHARLES BEVERIDGE MINE
LOWER KITTANNING COAL
CLARION TWP
CLARION CO. PA.
SCALE 1"=50'
DEC.-26-1957

E. J. WEIBEL RS. 9572

#357
6-10-99
C.C.