











Underhill Coal Mining Co
Plan showing Mine Projection
For ~~No 1 Mine~~ UNDERHILL MINE
Scale 1" = 200' Engineer's Office
SURVEY EXTENDED TO Nov-14th-1930


* PRESENT DEVELOPED OUT AREA OF
PROPERTY LINES
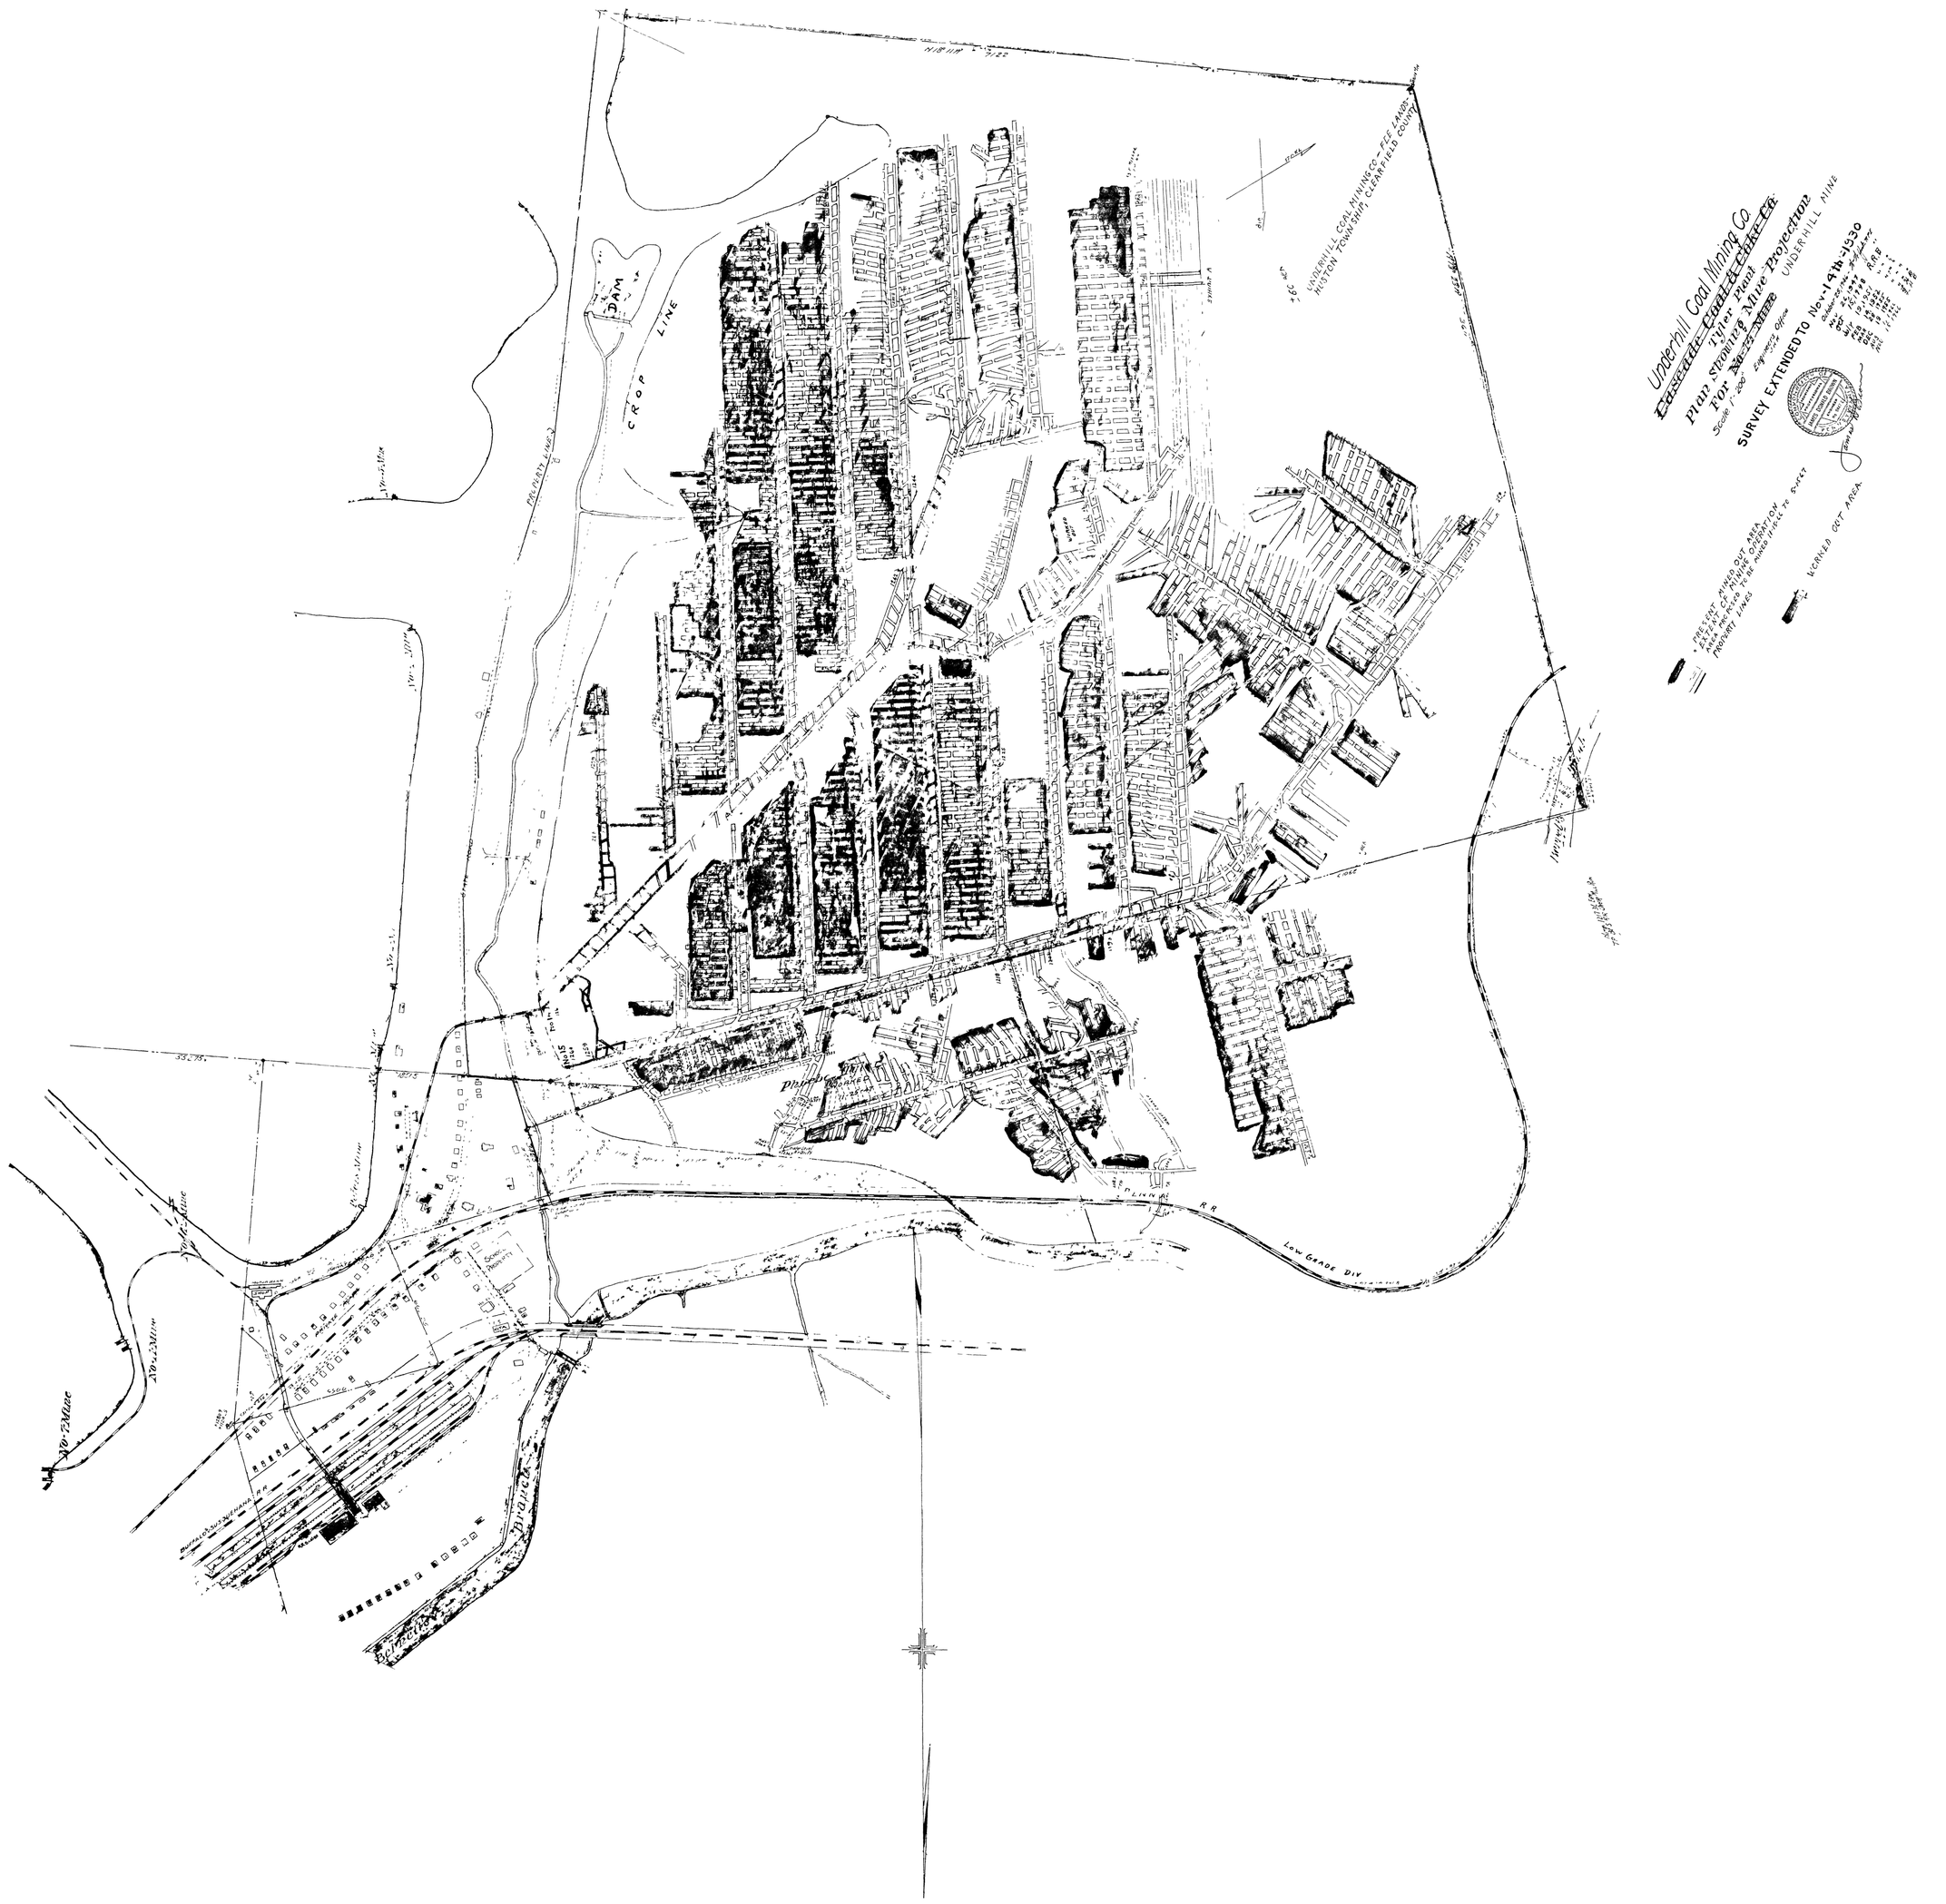
WORKED OUT AREA