


MAG 1914

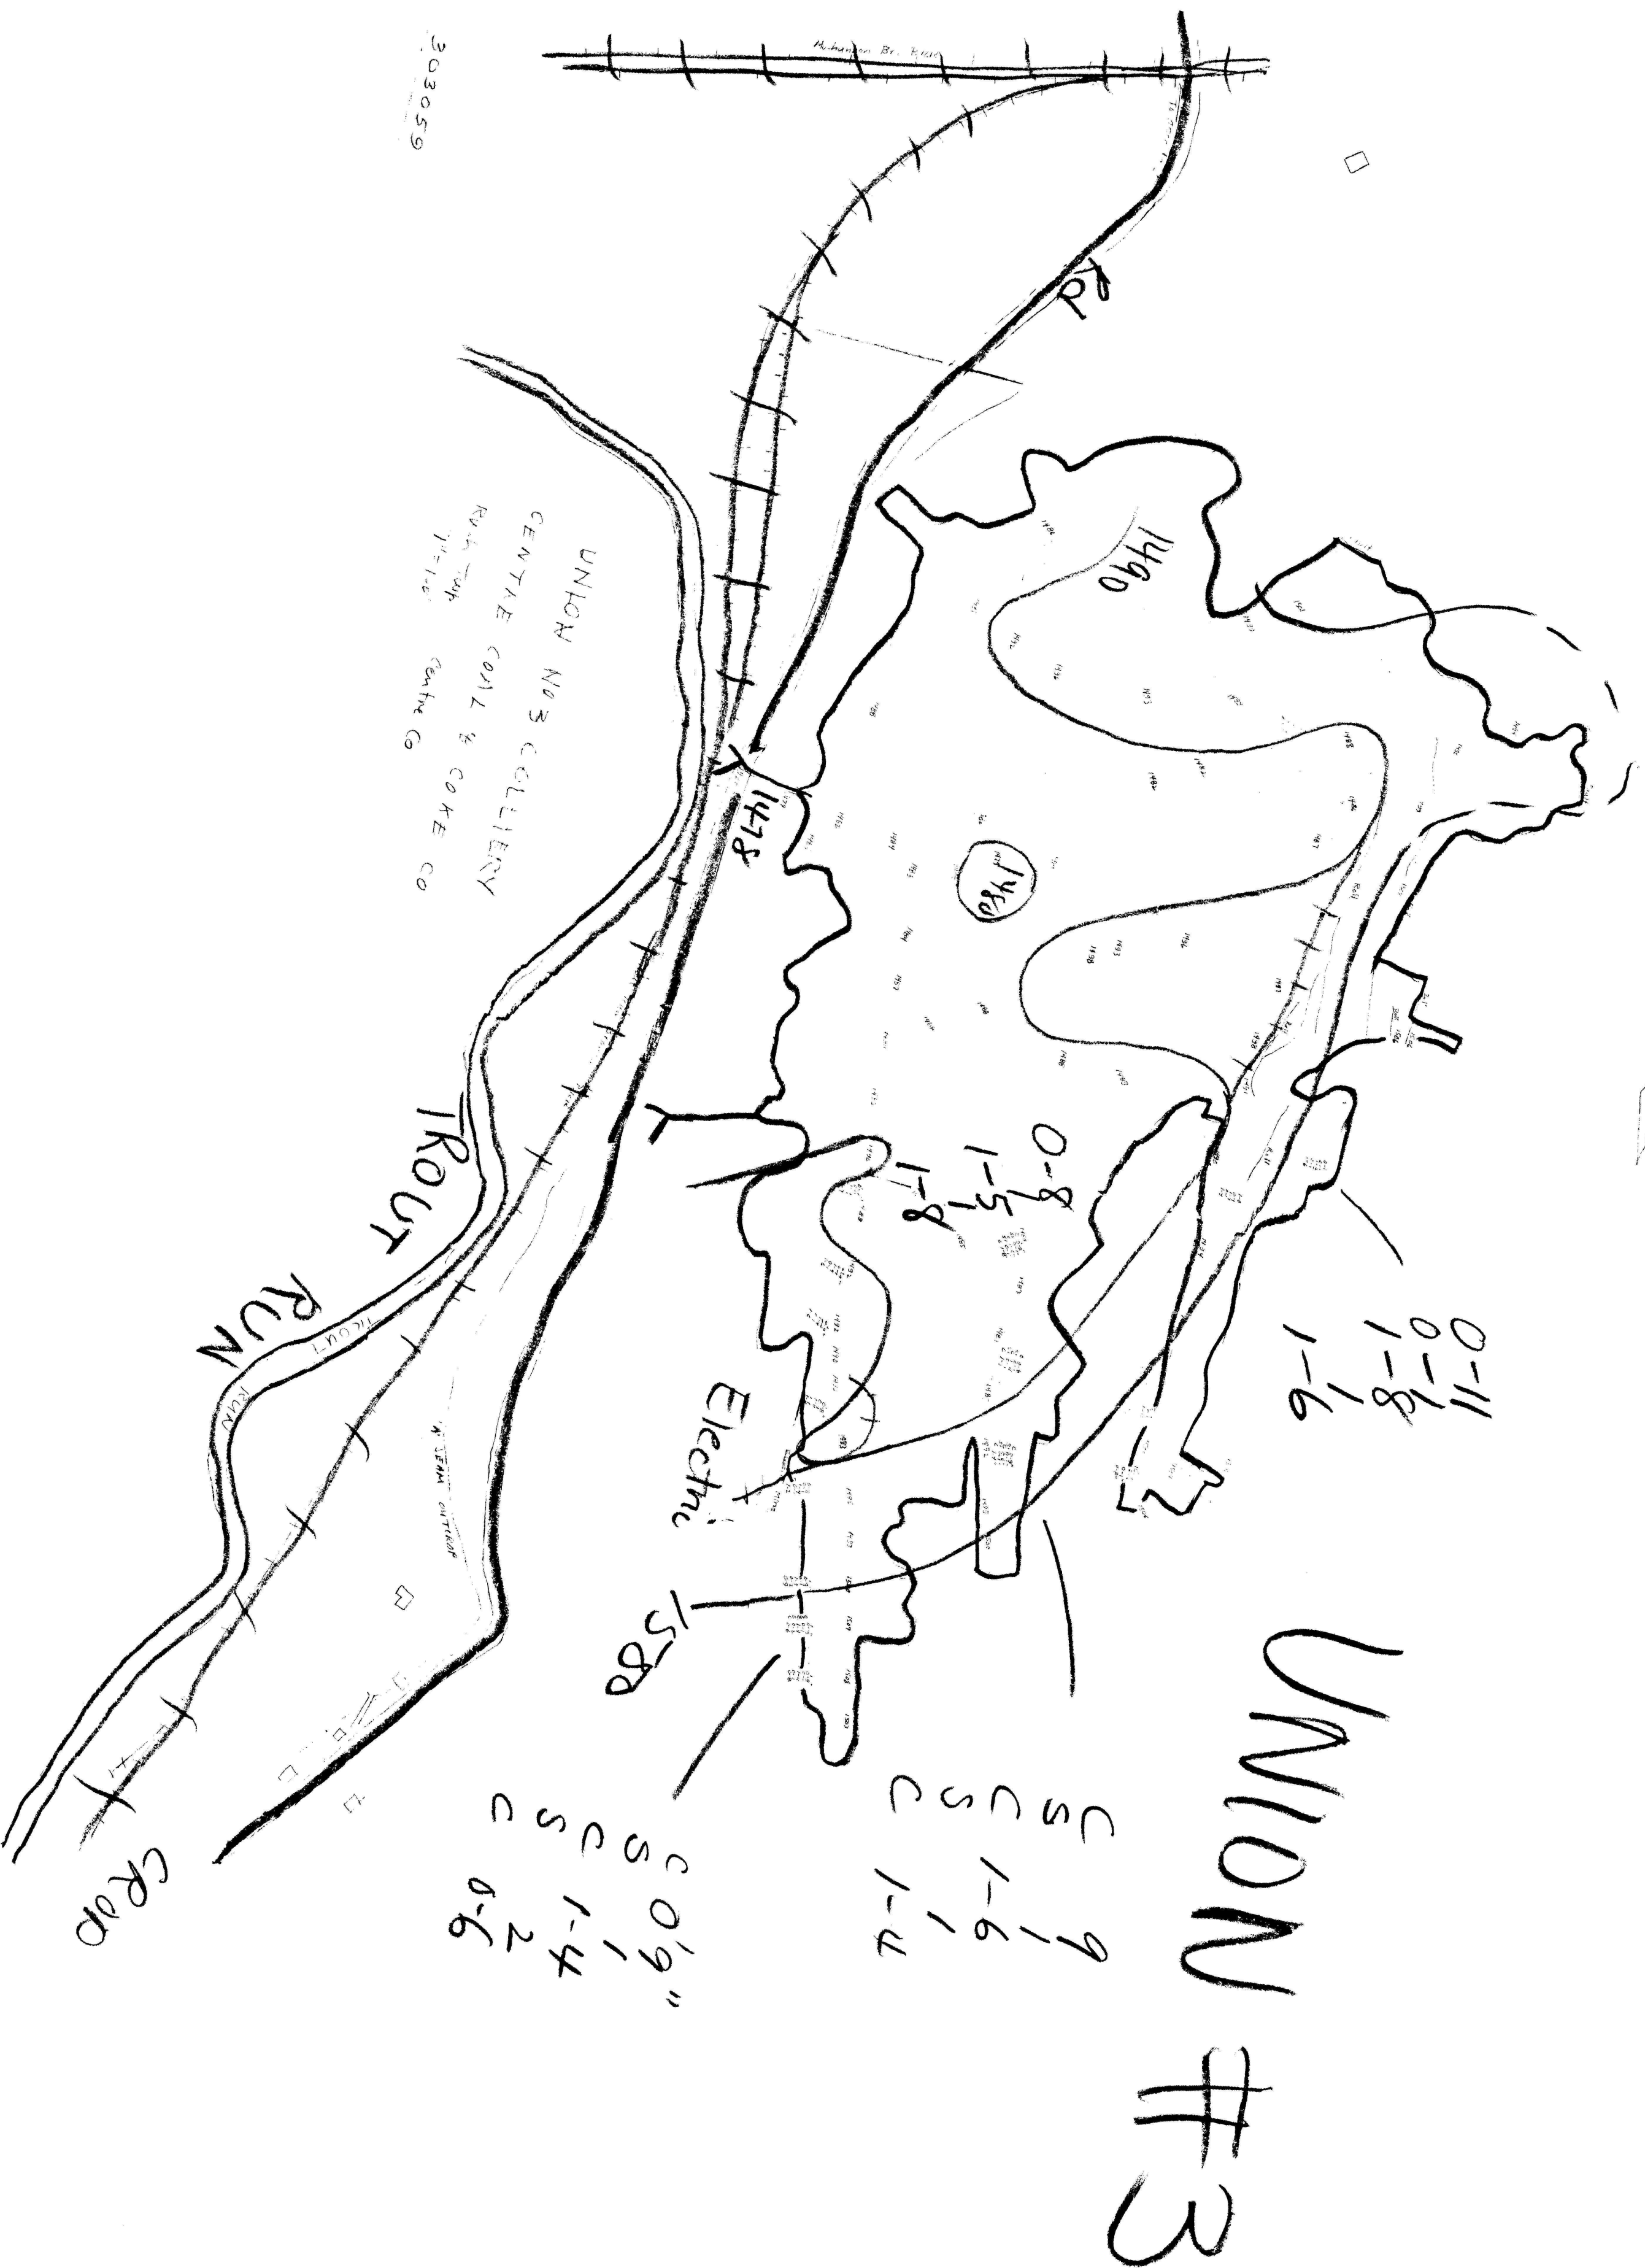

Union #3
MAG 1914