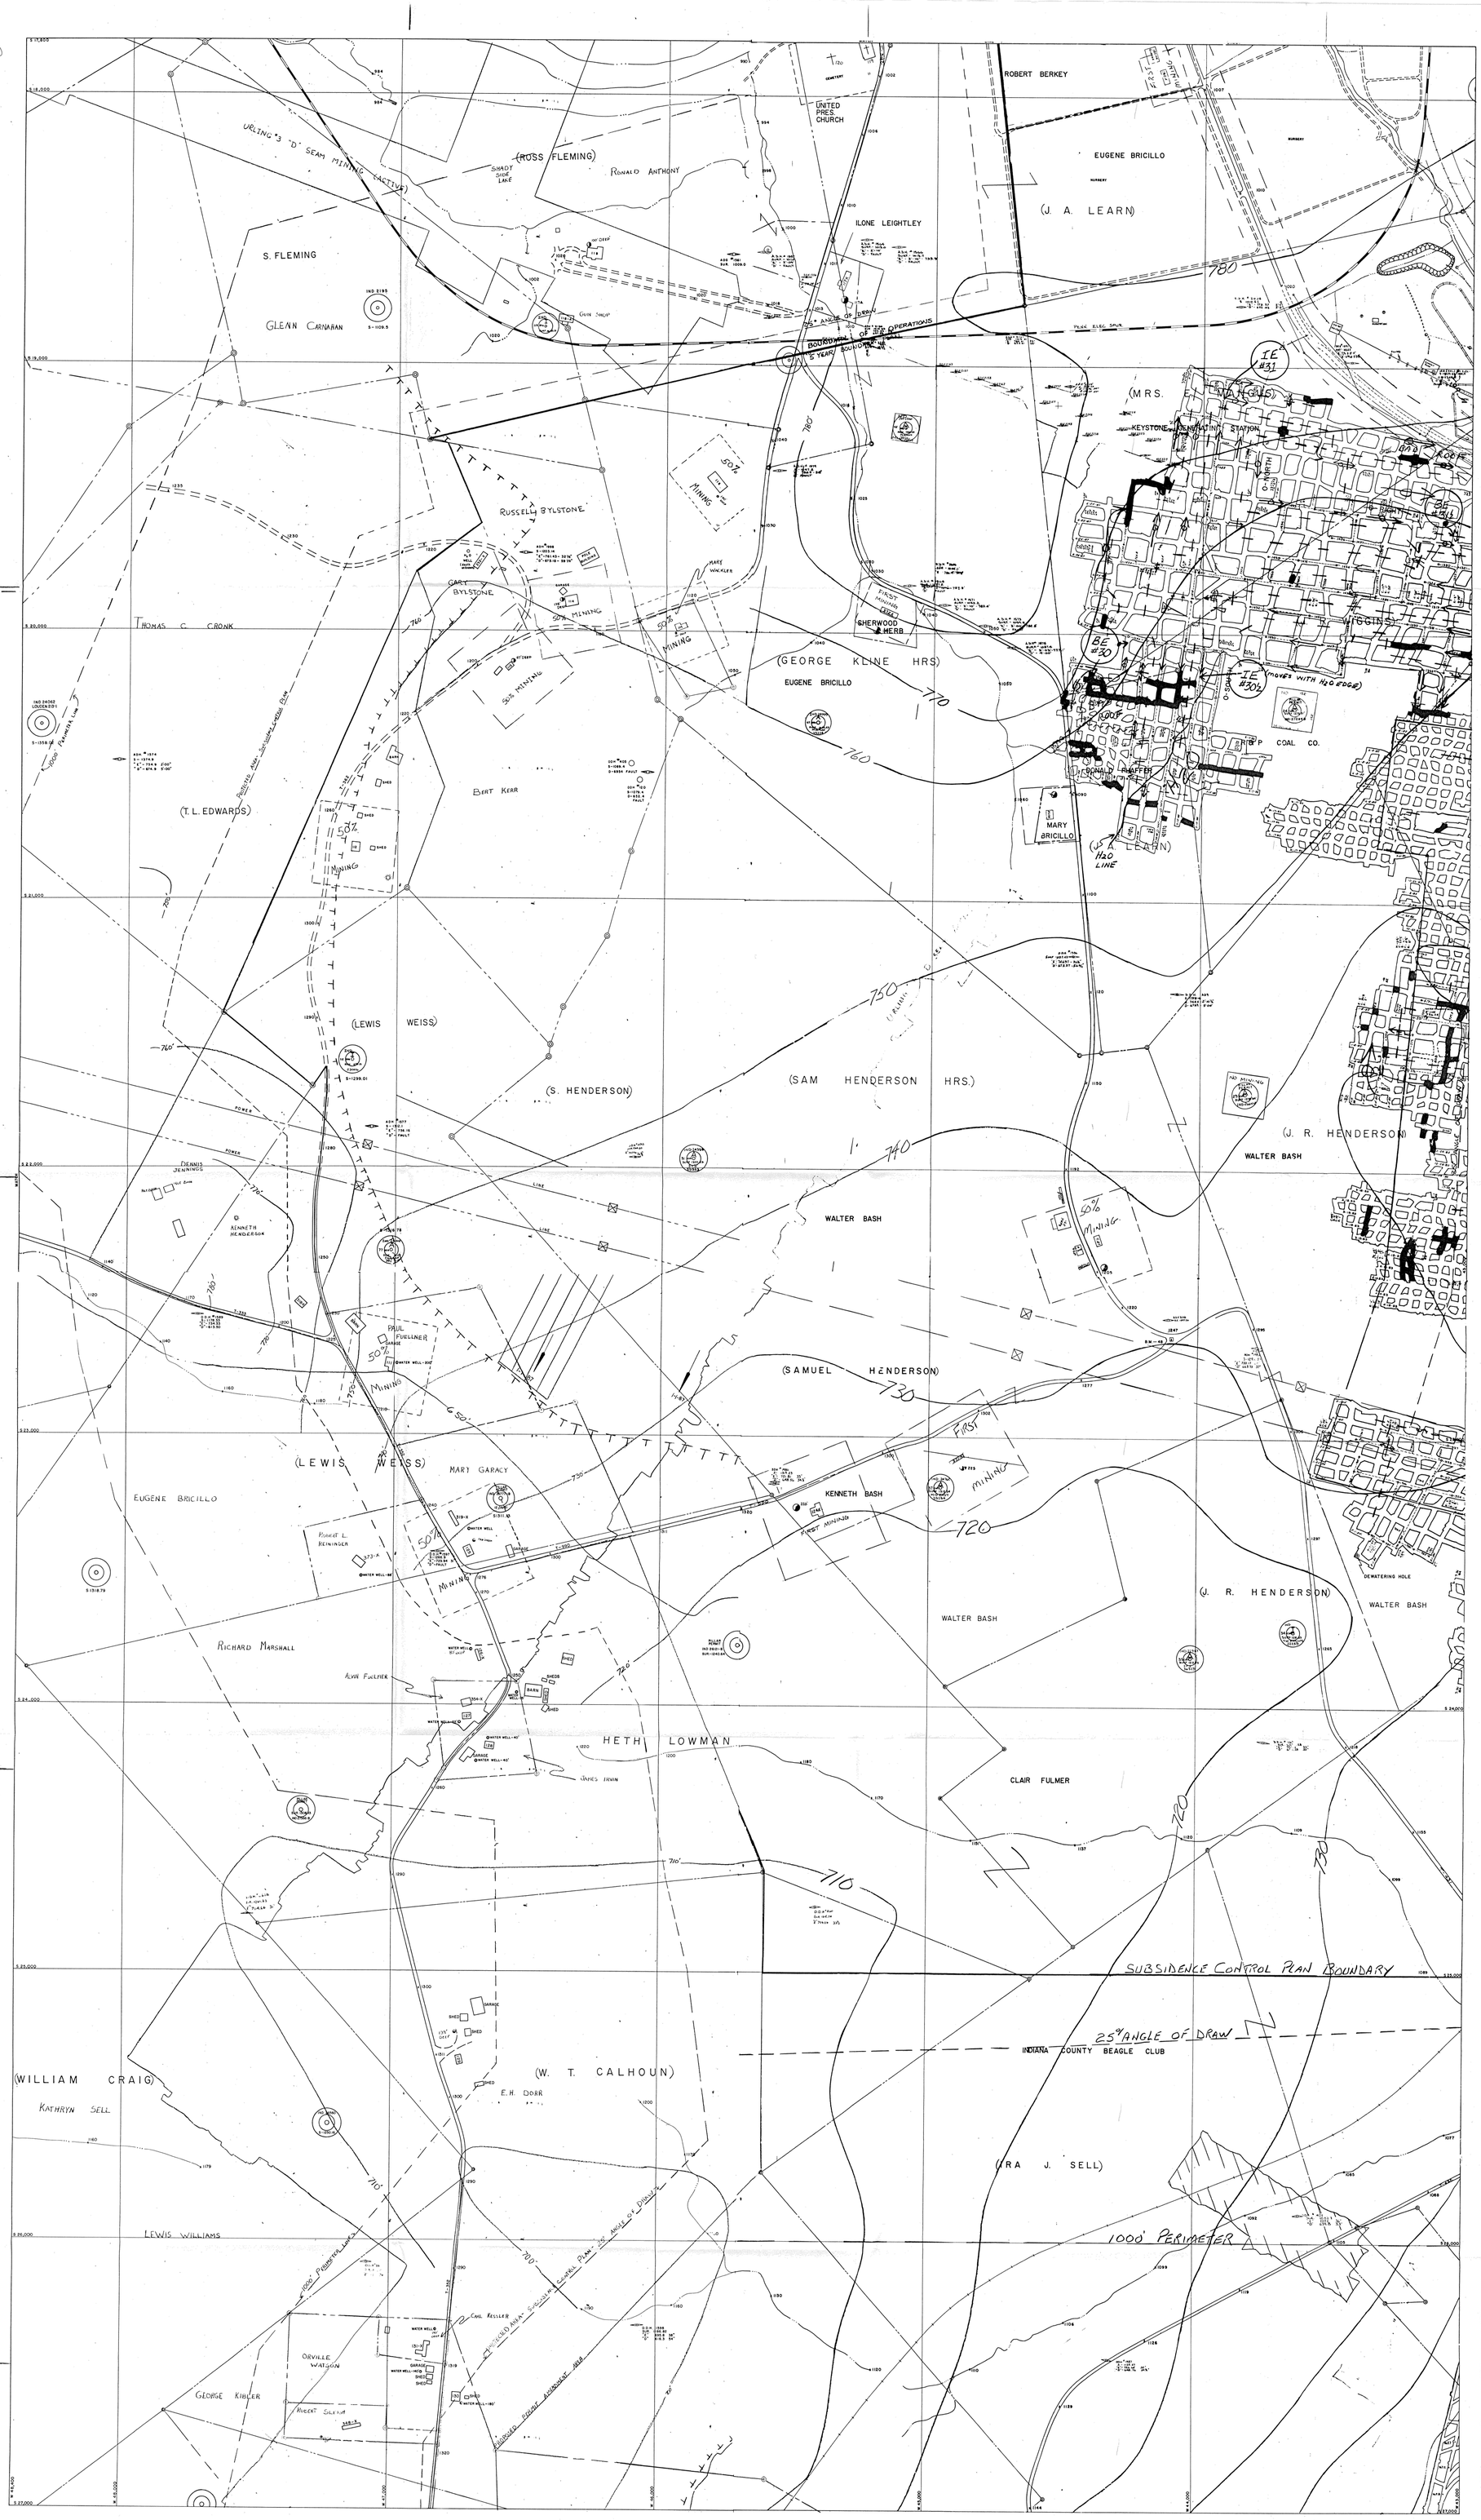

KEYSTONE COAL MINING CORP.
ARMSTRONG TWP. - INDIANA CO.-PA.