


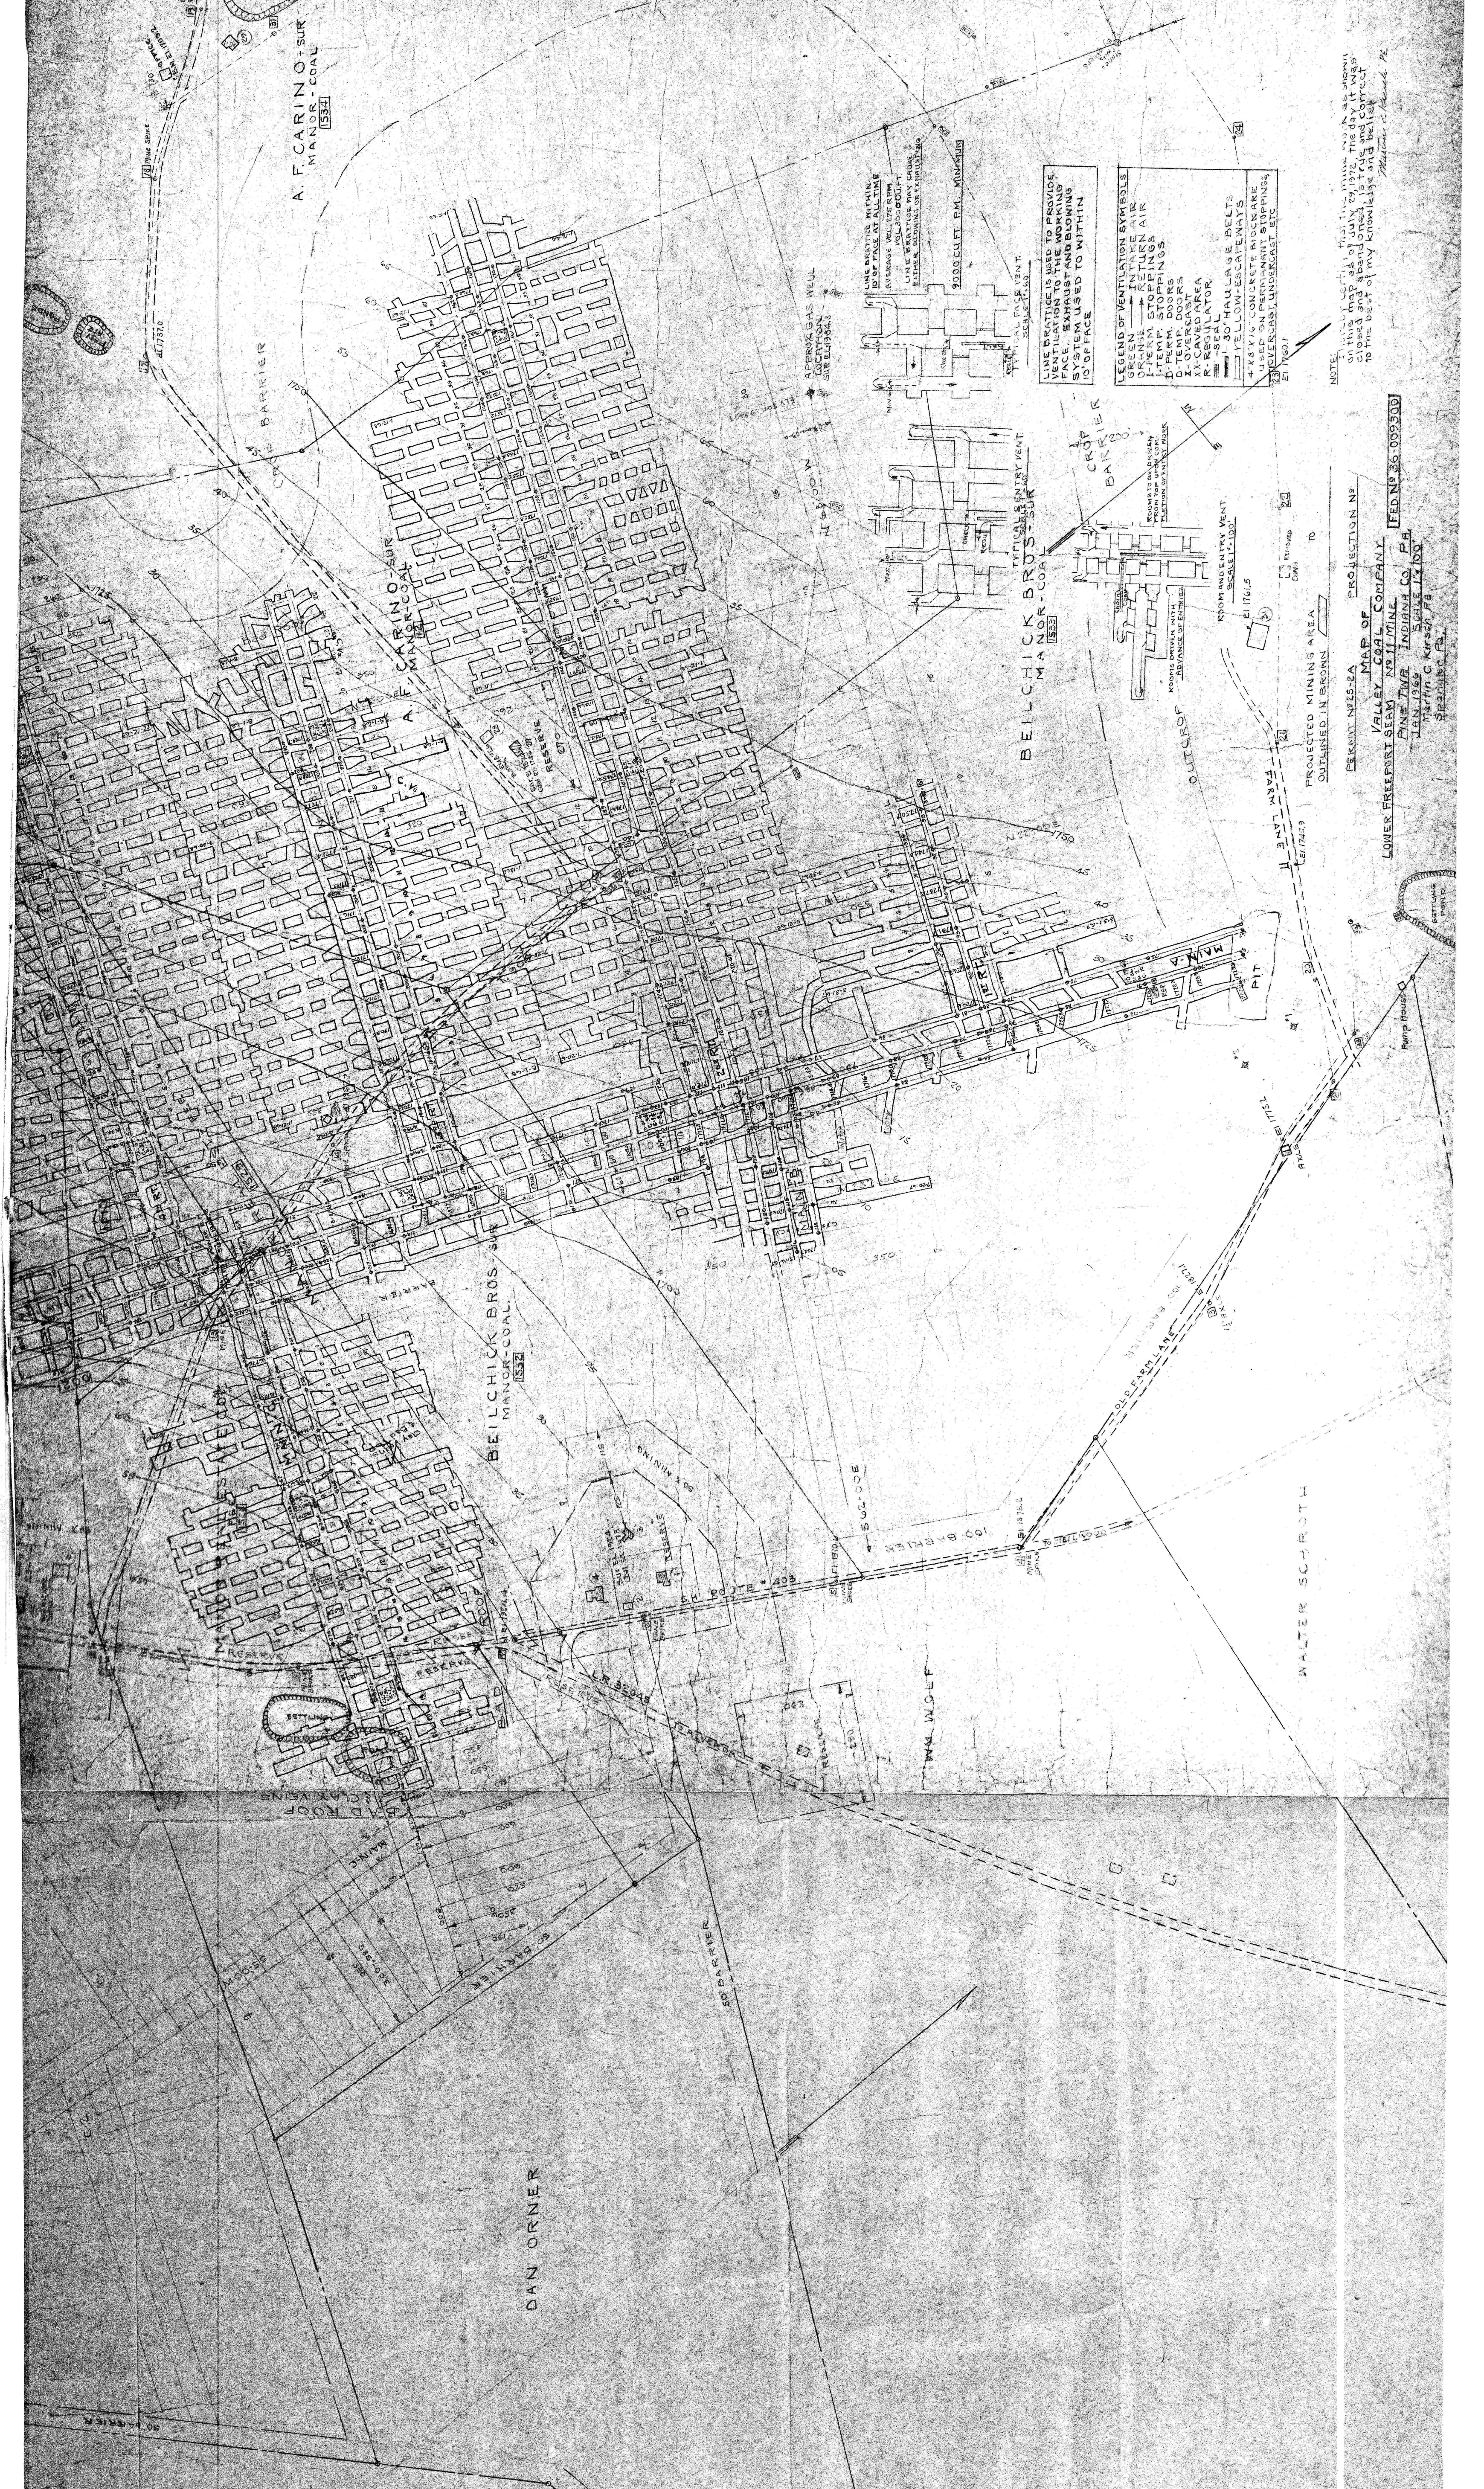

A. F. CARINO SUR
MANOR COAL
[534]

BEILCHICK BROS. SUR
MANOR COAL
[532]

BEILCHICK BROS. SUR
MANOR COAL
[533]

WALTER SCOUTH

LINE BRACKETS USED TO PROVIDE
VENTILATION TO THE WORKING
FACE. EXHAUST AIR BLOWING
SYSTEM USED TO WITHIN
10' OF FACE

LEGEND OF VENTILATION SYMBOLS
GREEN - INTAKE AIR
ORANGE - RETURN AIR
I - PERM STOPPINGS
D - PERM DOORS
X - OVERCAST
K - REGULATOR
S - SEAL
1 - 30' HAULAGE BELTS
4' X 7' 6" CONCRETE BLOCKS
4' X 7' 6" PERMANENT STOPPINGS
2' X 4' X 8' UNDERCAST ETC

NOTE:
This map was prepared by the
company on the basis of a survey
made on the day it was
prepared and is not
to be used as a basis for
any other survey.

PERMIT NO. 25-2A
MAP OF
VALLEY COAL COMPANY
LOWER FREEDOM BEAM NO. 11
JAN. 1934
INDIANA CO. PA.
Martin C. Kirsch, PA.
Scale 1" = 100'
[FED. NO. 36, 009, 300]