


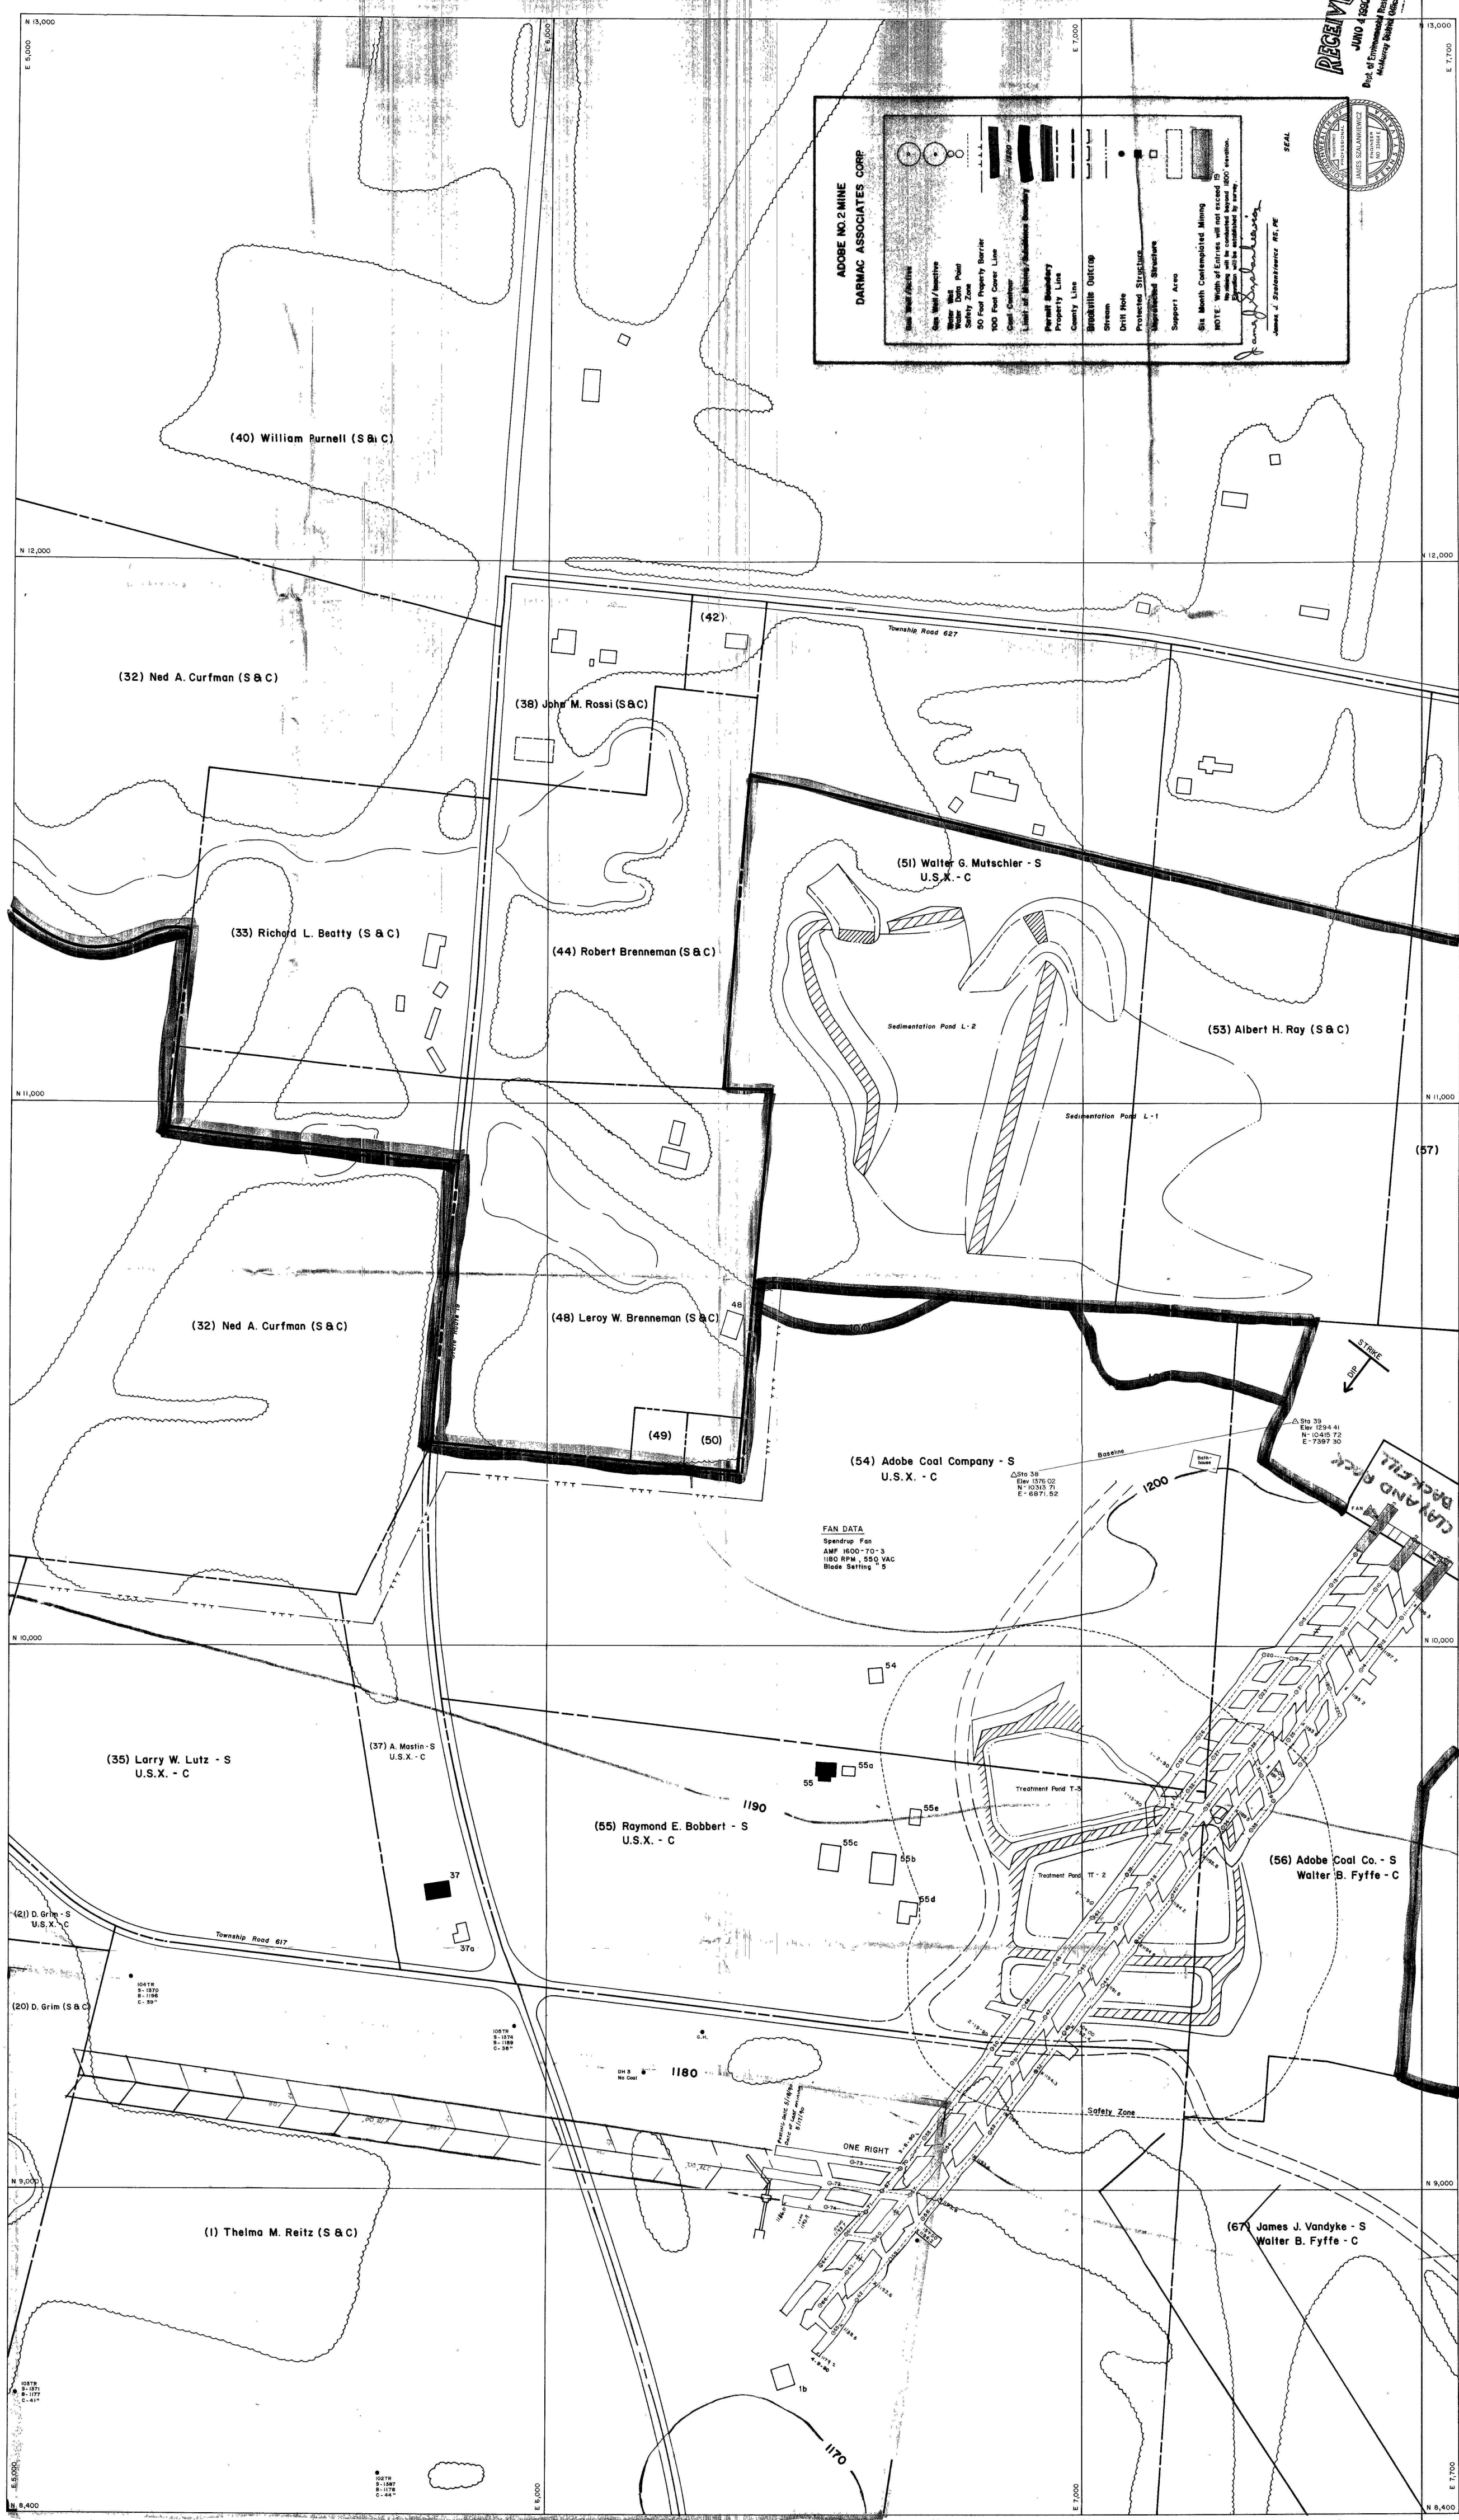

ADOBE NO. 2 MINE
DARMAC ASSOCIATES CORP.

SEE WELL / INACTIVE
WATER DRAIN
SAFETY ZONE
50 FOOT PROPERTY BARRIER
100 FOOT COVER LINE
LIMIT OF MINING / EXISTING BOUNDARY
PERMIT BOUNDARY
PROPERTY LINE
COUNTY LINE
BROOKVILLE OUTCROP
STREAM
DRIFT HOLE
PROTECTED STRUCTURE
UNPROTECTED STRUCTURE
SUPPORT AREA

SEE MONTH CONTINGENT MINING
NOTE: Width of Entries will not exceed 70'


RECEIVED
JUN 4 1990

SEAL
PROFESSIONAL ENGINEER
NO. 33461

BROOKVILLE COAL SEAM

DARMAC ASSOCIATES CORPORATION

ADOBE NO. 2 MINE

2

WASHINGTON TWP., LAWRENCE CO.
SCALE: 1" = 100' POSTING DATE: 5-18-90
MINING PERIOD: 1-1-90 to 7-1-90
PROJECTION NO.: 2

#35
5-25-99
C.C.